

4703500466P

RECEIVED
Office of Oil and Gas

OCT 05 2022

WV Department of
Environmental Protection

WW-7
8-30-06



West Virginia Department of Environmental Protection
Office of Oil and Gas
WELL LOCATION FORM: GPS

API: 47-035-00466 WELL NO.: Ripley 7310

FARM NAME: W. C. Foglesong, Et Al

RESPONSIBLE PARTY NAME: Columbia Gas Transmission, LLC

COUNTY: Jackson DISTRICT: Ripley

QUADRANGLE: ~~Sandyville~~ Ripley

SURFACE OWNER: Heartwood Forestland Fund III

ROYALTY OWNER: Lease #1052248-000, W.C. Foglesong, et al.

UTM GPS NORTHING: 4301482.87 (7355')

UTM GPS EASTING: 442363.02 GPS ELEVATION: 224.237m

The Responsible Party named above has chosen to submit GPS coordinates in lieu of preparing a new well location plat for a plugging permit or assigned API number on the above well. The Office of Oil and Gas will not accept GPS coordinates that do not meet the following requirements:

1. Datum: NAD 1983, Zone: 17 North, Coordinate Units: meters, Altitude: height above mean sea level (MSL) – meters.
2. Accuracy to Datum – 3.05 meters
3. Data Collection Method:

Survey grade GPS : Post Processed Differential

Real-Time Differential

Mapping Grade GPS : Post Processed Differential

Real-Time Differential

4. **Letter size copy of the topography map showing the well location.**

I the undersigned, hereby certify this data is correct to the best of my knowledge and belief and shows all the information required by law and the regulations issued and prescribed by the Office of Oil and Gas.

Signature

Wells Engineer STS
Title

09/26/2022
Date

11/04/2022

4703500466P
 Office of Oil & Gas
 OCT 05 2022
 WV Department of Environmental Protection

(RAVENSWOOD) 


RIPLEY QUADRANGLE
 WEST VIRGINIA
 TOPOGRAPHIC SERIES (LIVERPOOL)



(ELMWOOD)

Produced by Trimble Terrain Navigator Pro
 Topography based on USGS 1:24,000
 Maps
 North American 1983 Datum (NAD83)
 To place on the predicted North American
 1927 move the projection lines 9M N and
 13M E

Declination
 MN
 GN 0.41° W
 MN 7.82° W

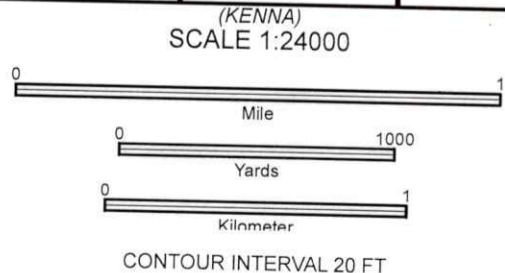

Printed: Fri Jan 21, 2022
 (KENTUCK)

38081-G5-TM-024
 RIPLEY, WV
 JAN 1, 1975

11/04/2022

Handwritten signature and date: 9-28-22