


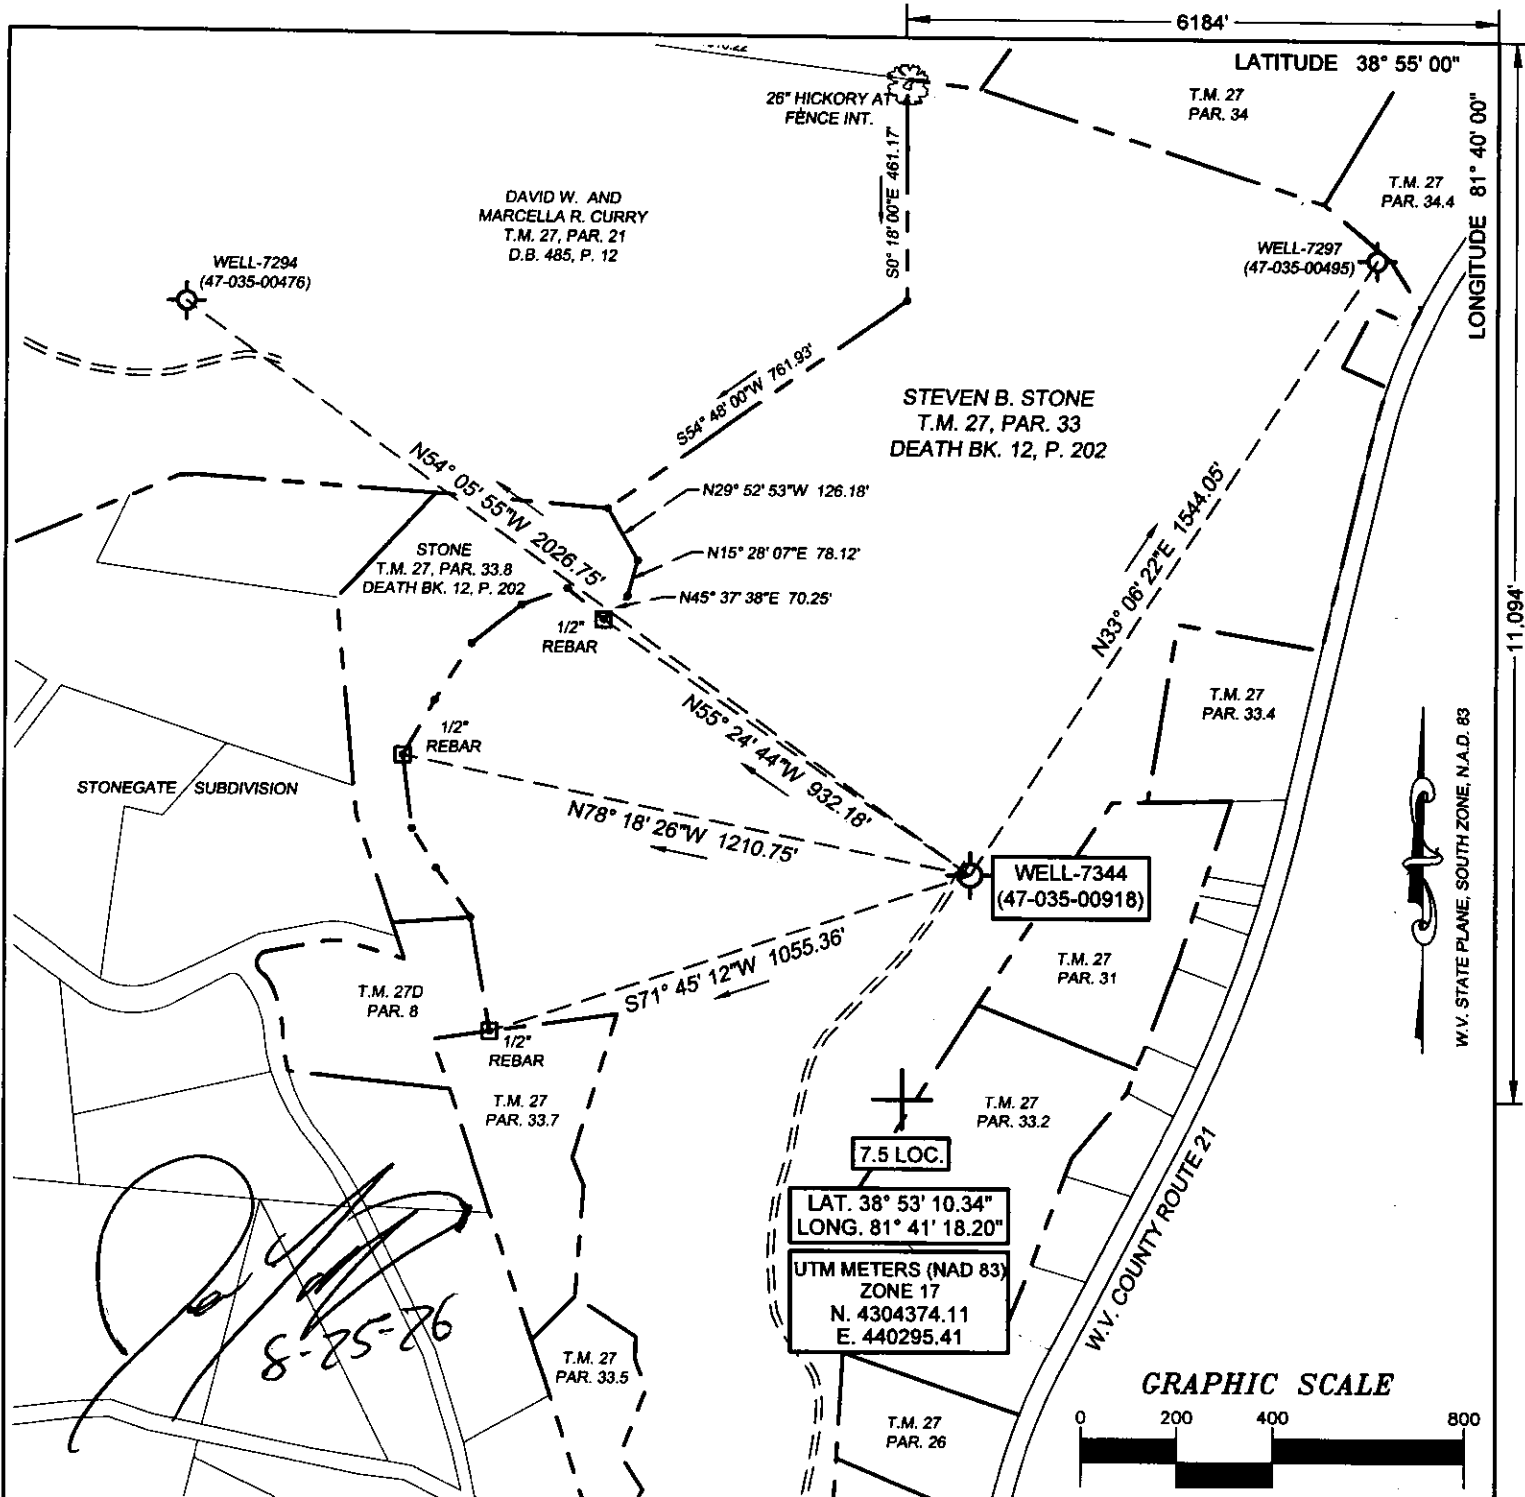

(+) DENOTES LOCATION OF WELL ON UNITED STATES TOPOGRAPHIC MAPS


FILE No 2601-3079-001-006
DRAWING No. 2026 RIPLEY-7344
SCALE 1"=400'
MINIMUM DEGREE OF
ACCURACY 1:200
PROVEN SOURCE OF
ELEVATION TRIMBLE R10
GPS UNIT

I THE UNDERSIGNED, HEREBY CERTIFY THAT
THIS PLAT IS CORRECT TO THE BEST OF MY
KNOWLEDGE AND BELIEF AND SHOWS ALL THE
INFORMATION REQUIRED BY LAW AND THE REGU-
LATIONS ISSUED AND PRESCRIBED BY THE
DIVISION OF ENVIRONMENTAL PROTECTION.

(SIGNED) *Richard B. Henline*

RICHARD B. HENLINE

PS #1984

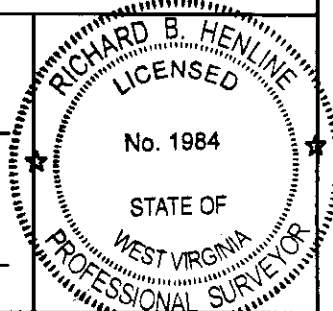

STATE OF WEST VIRGINIA
DIVISION OF ENVIRONMENTAL PROTECTION
OFFICE OF OIL AND GAS
NITRO, WV



DATE AUGUST 10 2026
OPERATOR'S WELL No. 7344
API WELL No. 47 035 - 00918
STATE COUNTY PERMIT

WELL TYPE: OIL GAS ☒ LIQUID INJECTION WASTE DISPOSAL
(IF "GAS") PRODUCTION STORAGE ☒ DEEP ☒ SHALLOW
LOCATION: ELEVATION 771.5' WATER SHED MUD RUN OF SANDY CREEK
DISTRICT RAVENSWOOD COUNTY JACKSON
QUADRANGLE SANDYVILLE, WV

SURFACE OWNER STEVEN B. & ALTA CORINNE MASEK STONE ACREAGE 76.12
OIL & GAS ROYALTY OWNER W. E. HUPP, ET. AL. LEASE ACREAGE 14
LEASE No. 52789

PROPOSED WORK: DRILL CONVERT DRILL DEEPER REDRILL FRACTURE 09/25/2026
STIMULATE ☒ PLUG OFF OLD FORMATION PERFORATE NEW
FORMATION OTHER PHYSICAL CHANGE IN WELL (SPECIFY)


PLUG AND ABANDON CLEAN OUT AND REPLUG
TARGET FORMATION ORISKANY ESTIMATED DEPTH 5016
WELL OPERATOR COLUMBIA GAS TRANSMISSION, LLC DESIGNATED AGENT MARIA MEDVEDEVA
ADDRESS PO BOX 1273, CHARLESTON, WV ADDRESS 1700 MACCORKLE AVE., S.E.
25325-1273 CHARLESTON, WV 25314

(PORTLAND)



SANDYVILLE QUADRANGLE
WEST VIRGINIA
TOPOGRAPHIC SERIES (ROCKPORT)

081° 42' 26.4396" W 081° 41' 30.0000" W 081° 41' 00.0000" W 081° 40' 30.0000" W 081° 40' 07.1220" W
038° 54' 29.4845" N 038° 54' 29.4845" N

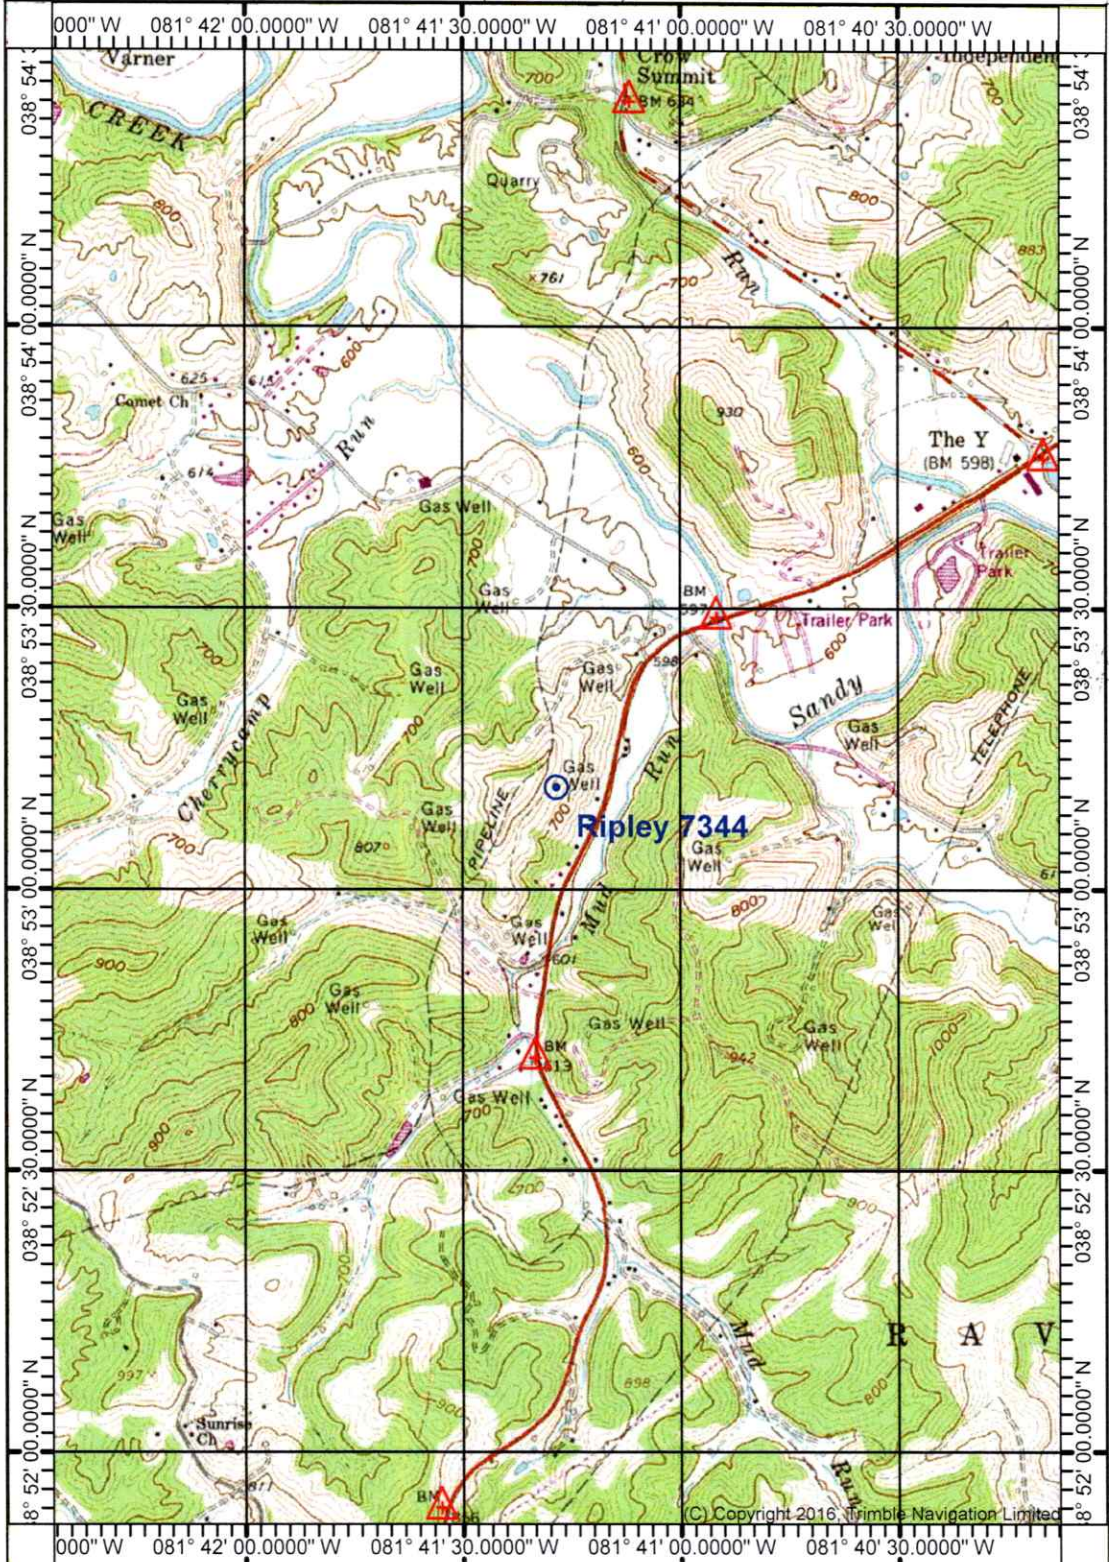

(RAVENSWOOD)

RECEIVED
P 08 2026
Department of
Environmental Protection


(LIVERPOOL)

(COTTAGEVILLE)

(GAY)

Produced by Trimble Terrain Navigator Pro
Topography based on USGS 1:24,000
Maps
North American 1983 Datum (NAD83)
To place on the predicted North American
1927 move the projection lines 9M N and
13M E

Declination
GN 0.43° W
MN 7.81° W

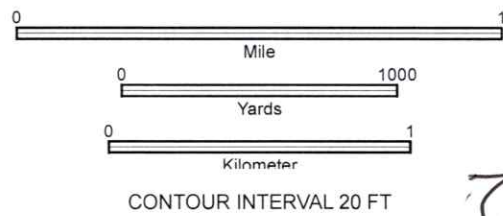

38081-H5-TM-024
SANDYVILLE, WV
JAN 1, 1988

09/25/2026