


Latitude 38° 55'

Longitude 81° 45'

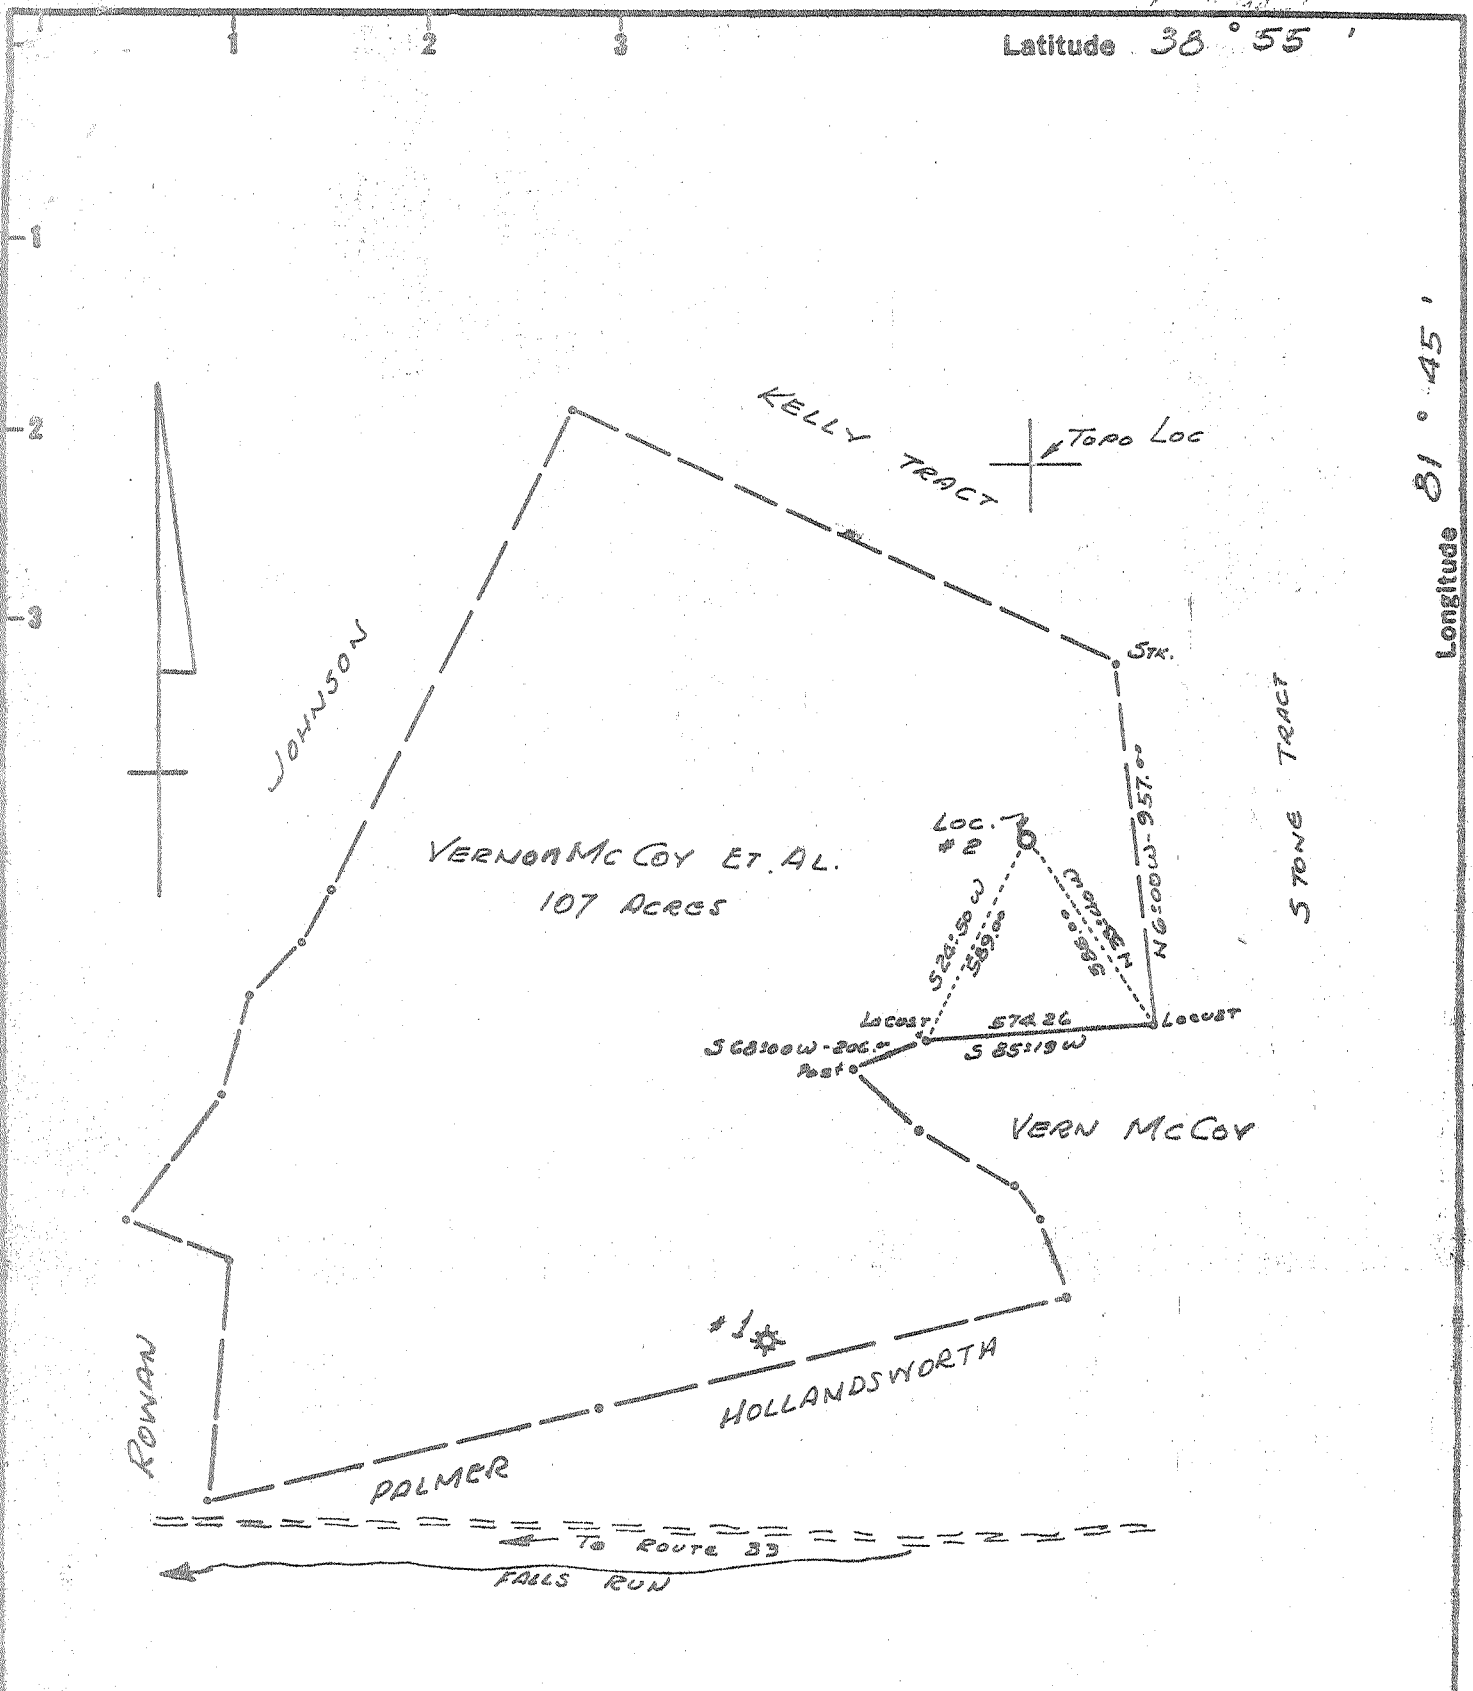

Minimum Error of Closure 1 in 200
 Source of Elevation U.S.G.S. Elev 824' TOP KNOB East of Loc.

New Location
 Drill Deeper
 Abandonment
used 1-25-72

"I, the undersigned, hereby certify that this map is correct to the best of my knowledge and belief and shows all the information required by paragraph 6 of the rules and regulations of the oil and gas section of the mining laws of West Virginia."

Company COLONIAL GAS CO.
 Address CHAS. NATL PLAZA, CHARLESTON, W.VA.
 Farm VERNON MCCOY ET AL.
 Tract _____ Acres 107 Lease No. _____
 Well (Farm) No. 2 Serial No. _____
 Elevation (Spirit Level) 791.00
 Quadrangle RAVENSWOOD EC
 County JACKSON District UNION
 Engineer N.L. Sexton
 Engineer's Registration No. 1832
 File No. _____ Drawing No. _____
 Date 12-23-71 Scale 1" = 500'

STATE OF WEST VIRGINIA
 DEPARTMENT OF MINES
 OIL AND GAS DIVISION
 CHARLESTON


WELL LOCATION MAP
 FILE NO. Jac-1326-P

+ Denotes location of well on United States Topographic Maps, scale 1 to 62,500 latitude and longitude lines being represented by border lines as shown.

- Denotes one inch spaces on border line of original tracing.

Latitude 38° 55'

Longitude 81° 45'

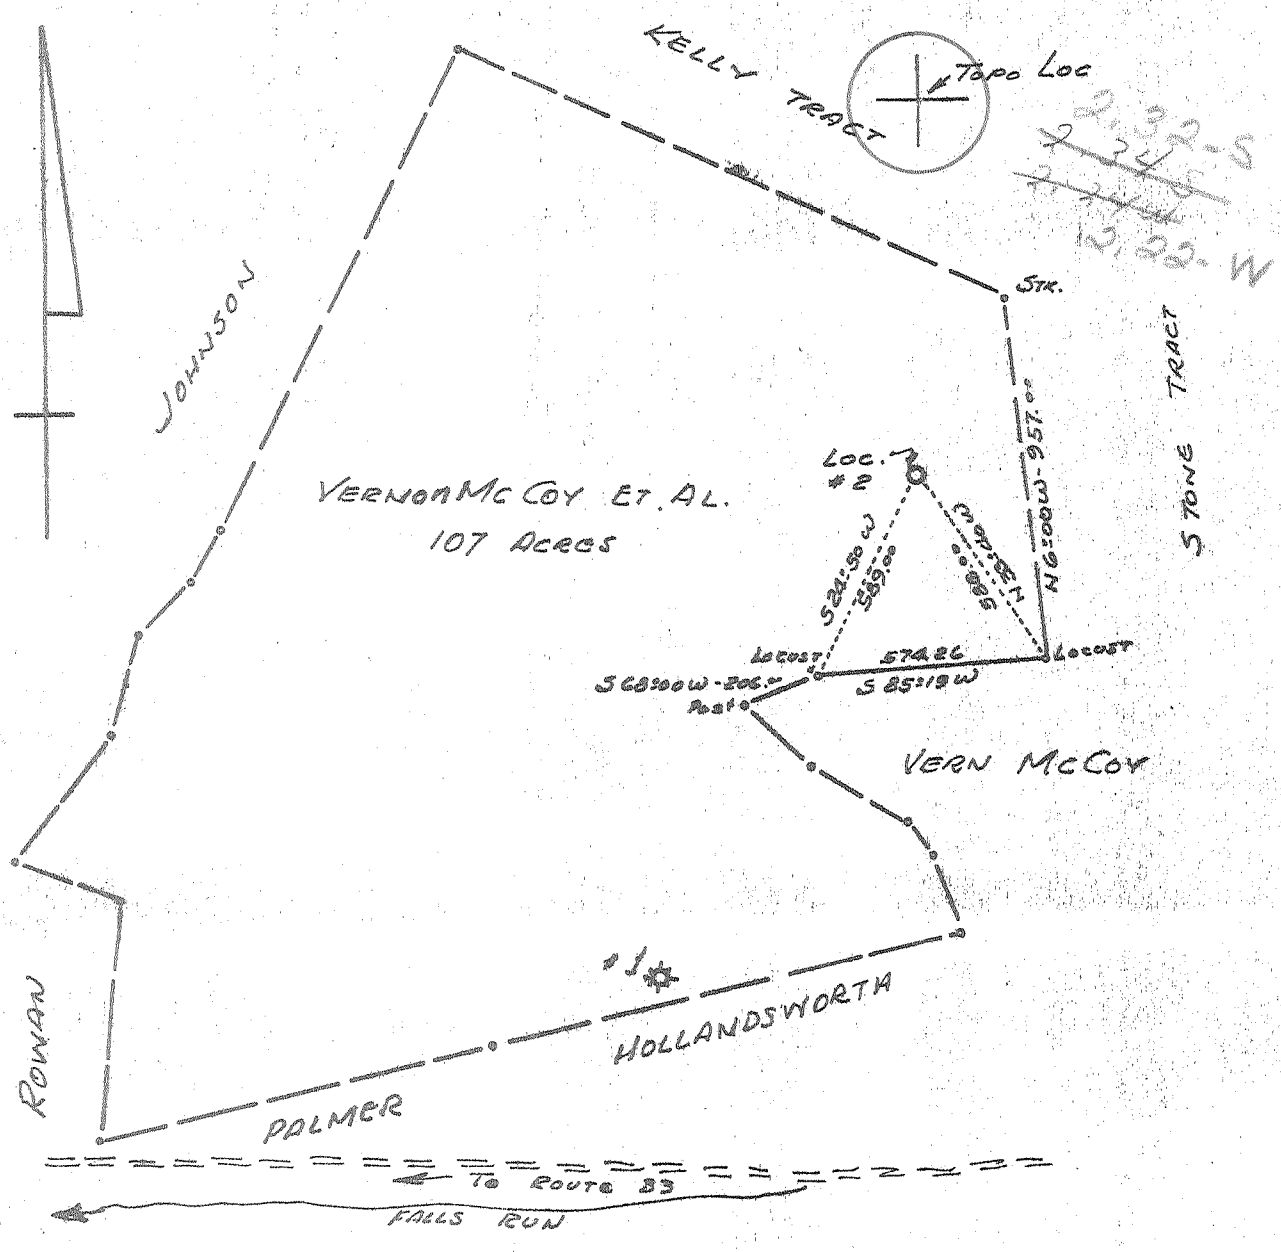

New Location
 Drill Deeper
 Abandonment

Minimum Error of Closure 1 in 200
 Source of Elevation U.S.G.S. Elev 824' Top Knob East of Loc.

"I, the undersigned, hereby certify that this map is correct to the best of my knowledge and belief and shows all the information required by paragraph 6 of the rules and regulations of the oil and gas section of the mining laws of West Virginia."

Company COLONIAL GAS CO.
 Address CHAS. NATL PLAZA, CHARLESTON, W.VA.
 Farm VERNON MCCOY ET AL.
 Tract _____ Acres 107 Lease No. _____
 Well (Farm) No. 2 Serial No. _____
 Elevation (Spirit Level) 791.00
 Quadrangle RAVENSWOOD R
 County JACKSON District UNION
 Engineer N.L. Septon
 Engineer's Registration No. 1832
 File No. _____ Drawing No. _____
 Date 12-23-71 Scale 1" = 500'

STATE OF WEST VIRGINIA
 DEPARTMENT OF MINES
 OIL AND GAS DIVISION
 CHARLESTON

WELL LOCATION MAP
 FILE NO. Jac-1326

+ Denotes location of well on United States Topographic Maps, scale 1 to 62,500 latitude and longitude lines being represented by border lines as shown.
 - Denotes one inch spaces on border line of original tracing.

6-0 Ripley North (342)

Deep Well (Newburg) JAN 11 1972



STATE OF WEST VIRGINIA
DEPARTMENT OF MINES
OIL AND GAS WELLS DIVISION 3

Rotary
Spudder
Cable Tools
Storage

Quadrangle Ravenswood

Permit No. JAC - 1326

WELL RECORD

Oil or Gas Well DRY
(KIND)

Company Colonial Gas Company
Address 1025 Charleston National Plaza
Farm Vernon & Mary Jane McGehee 107
Location (waters) _____
Well No. 2 Elev. 803 KB
District Union County Jackson
The surface of tract is owned in fee by _____
Address _____
Mineral rights are owned by _____
Address _____
Drilling commenced Dec. 27, 1971
Drilling completed Jan. 26, 1972
Date Shot _____ From _____ To _____
With _____
Open Flow _____ /10ths Water in _____ Inch
_____ /10ths Merc. in _____ Inch
Volume _____ Cu. Ft.
Rock Pressure _____ lbs. _____ hrs.
Oil _____ bbls., 1st 24 hrs.
WELL ACIDIZED (DETAILS) _____
WELL FRACTURED (DETAILS) _____

Casing and Tubing	Used in Drilling	Left in Well	Packers
Size			Kind of Packer
16			
13			Size of
10 9/8	250	250	
8 1/4			Depth set
6 3/4	2050		
5 3/16			
4 1/2	5278		
3			Perf. top
2			Perf. bottom
Liners Used			Perf. top
			Perf. bottom

Attach copy of cementing record. see other side
CASING CEMENTED yes SIZE _____ No. Ft. _____ Date _____
Amount of cement used (bags) _____
Name of Service Co. Jones Cementing-Halliburton
COAL WAS ENCOUNTERED AT none FEET _____ INCHES _____
FEET _____ INCHES _____ FEET _____ INCHES _____
FEET _____ INCHES _____ FEET _____ INCHES _____

RESULT AFTER TREATMENT (Initial open Flow or bbls.) _____
ROCK PRESSURE AFTER TREATMENT _____ HOURS _____
Fresh Water _____ Feet _____ Salt Water _____ Feet _____
Producing Sand _____ Depth _____

Formation	Color	Hard or Soft	Top	Bottom	Oil, Gas or Water	Depth	Remarks
soil			0	20			
Shale-Sand-Red Rock			20	2450			
Sand - Salt Sand?			2450	2769			
✓ Limestone - Bigline			2769	2895			
✓ Sand - Injira			2895	2995			
Sandy Shale			2995	2050			
Shale			2050	4468			
✓ Corniferous Lime - 463			4478	4550			
✓ Oriskany Sand			4550	4560			
✓ Limestone & Dolomite - HELDERBERG & SALINA			4560	5227			
✓ Newburg Horizon			5227	5233			
✓ Dolomite - McKenais			5233	5263			
				545			
					5263	Log Total Depth	

(over)

