

Abandonment - Permit issued 6-15-37

Company	Walker Beren Oil Company
Address	P.O. Box 1105, Parkersburg, W.Va.
Farm	D. Evans
Tract 1 Acres	98 Lease No.
Well (Farm) No.	3 Serial No. 1395
Elevation (Spirit Level)	821.8
Quadrangle	Ripley SE
County	Jackson District Washington
Engineer	Wm. Litton
Engineer's Registration No.	
File No.	Drawing No.
Date	May 28 1"-400'

STATE OF WEST VIRGINIA
 Department of Mines
 OIL AND GAS DIVISION
 CHARLESTON

WELL LOCATION MAP
 File No. JAC-66A

+ Denotes location of well on United States Topographic Maps, scale 1 to 62,500, latitude and longitude lines being represented by border lines as shown.

— Denotes one inch spaces on border line of original tracing.

WEST VIRGINIA DEPARTMENT OF MINES
OIL AND GAS DIVISION

51 ✓

WELL RECORD


Permit No. JAC-66-A Oil or Gas Well Oil
(Kind)

Company Walker-Beren Oil Co.
Address Parkersburg, W. Va.
Farm Daniel Evans Acres 98
Location (waters).....
Well No. (3) 1395 Elev. 821
District Washington County Jackson
The surface of tract is owned in fee by D. Evans
heirs Address Gay, W. Va.
Mineral rights are owned by Walker-Beren Oil Co.
Address Parkersburg, W. Va.
Drilling commenced July 22, 1919
Drilling completed Aug. 31, 1919
Date shot..... Depth of shot.....
Open Flow /10ths Water in..... Inch
/10ths Merc. in..... Inch
Volume..... Cu. Ft.
Rock Pressure..... lbs..... hrs.
Oil..... 5..... bbls., 1st 24 hrs.
Fresh water..... feet..... feet
Salt water..... feet..... feet

Casing and Tubing	Used in Drilling	Left in Well	Packers
Size			Kind of Packer.....
16			
13	Conductor 16	16	Size of.....
10			
8 1/4	619		Depth set.....
6 5/8	1365	1365	
5 3/16			Perf. top.....
3			Perf. bottom.....
2	1603	1603	Perf. top.....
			Perf. bottom.....
Liners Used.....			

CASING CEMENTED..... SIZE..... No. FT..... Date.....
COAL WAS ENCOUNTERED AT none FEET..... INCHES
..... FEET..... INCHES..... FEET..... INCHES
..... FEET..... INCHES..... FEET..... INCHES

Formation	Color	Hard or Soft	Top	Bottom	Oil Gas or Water	Depth Found	Remarks
ed Rock Cave			105	135			
st Gov Run	✓ LITTLE DUNKARD		800	825			
nd Gov Run	✓ BIG DUNKARD		1000	1125			
st Salt	✓ GAS SAND		1157	1252			
st Salt	✓		1578	1613-70	oil	1578-91	

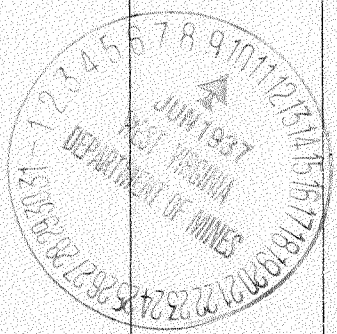

Formation	Color	Hard or Soft	Top	Bottom	Oil, Gas or Water	Depth Found	Remarks

Date 6-9, 19 37

APPROVED Walker-Boyer Oil Co., Owner

By Max Boyer Partner
(Title)