

Company Walker Beren Oil Company  
 Address P.O. Box 1105, Parkersburg, W. Va.  
 Farm Icy J. Cobb & Mazy B. Godby  
 Tract No. 6 Acres 18 & 19 Lease No.  
 Well (Farm) No. 1 Serial No. 45081431  
 Elevation (Spirit Level) 836 F & 858  
 Quadrangle Ripley, W. Va.  
 County Jackson District Washington  
 Engineer Wm. Litton, Surveyor  
 Engineer's Registration No.  
 File No. July 12, 1937 Drawing No.  
 Date July 8, 1937 Scale 1"=400'

STATE OF WEST VIRGINIA  
 Department of Mines  
 OIL AND GAS DIVISION  
 CHARLESTON

WELL LOCATION MAP

File No. JAC-68A/67A  
 ABANDONMENT CANCELLED: DEC. 1937

Denotes location of well on United States Topographic Maps, scale 1 to 62,500, latitude and longitude lines being represented by border lines as shown. SEE RECORD ON BACK →

Denotes one inch spaces on border line of original tracing. 67 now 145A

JAC - 68-A (CANCELLED)

Icy Cobb #1 (1430)

Elev. 836'

CASING:

13" @ 16'

10" @ 640'

8" @ 885'

6" @ 1270'

2" @ 1599'

Oil @ 1593.99'

F. WATER @ 885'

TD 1607'

JAC - 67-A (Renamed to JAC 145-A)

Mazy Goosey #1 (1431)

Elev. 858'

CASING:

13" @ 16'

10" @ 720'

8" @ 1000'


6" @ 1325'

2" @ 1631'

Oil @ 1607'

Gas @ 1604'

TD 1641'

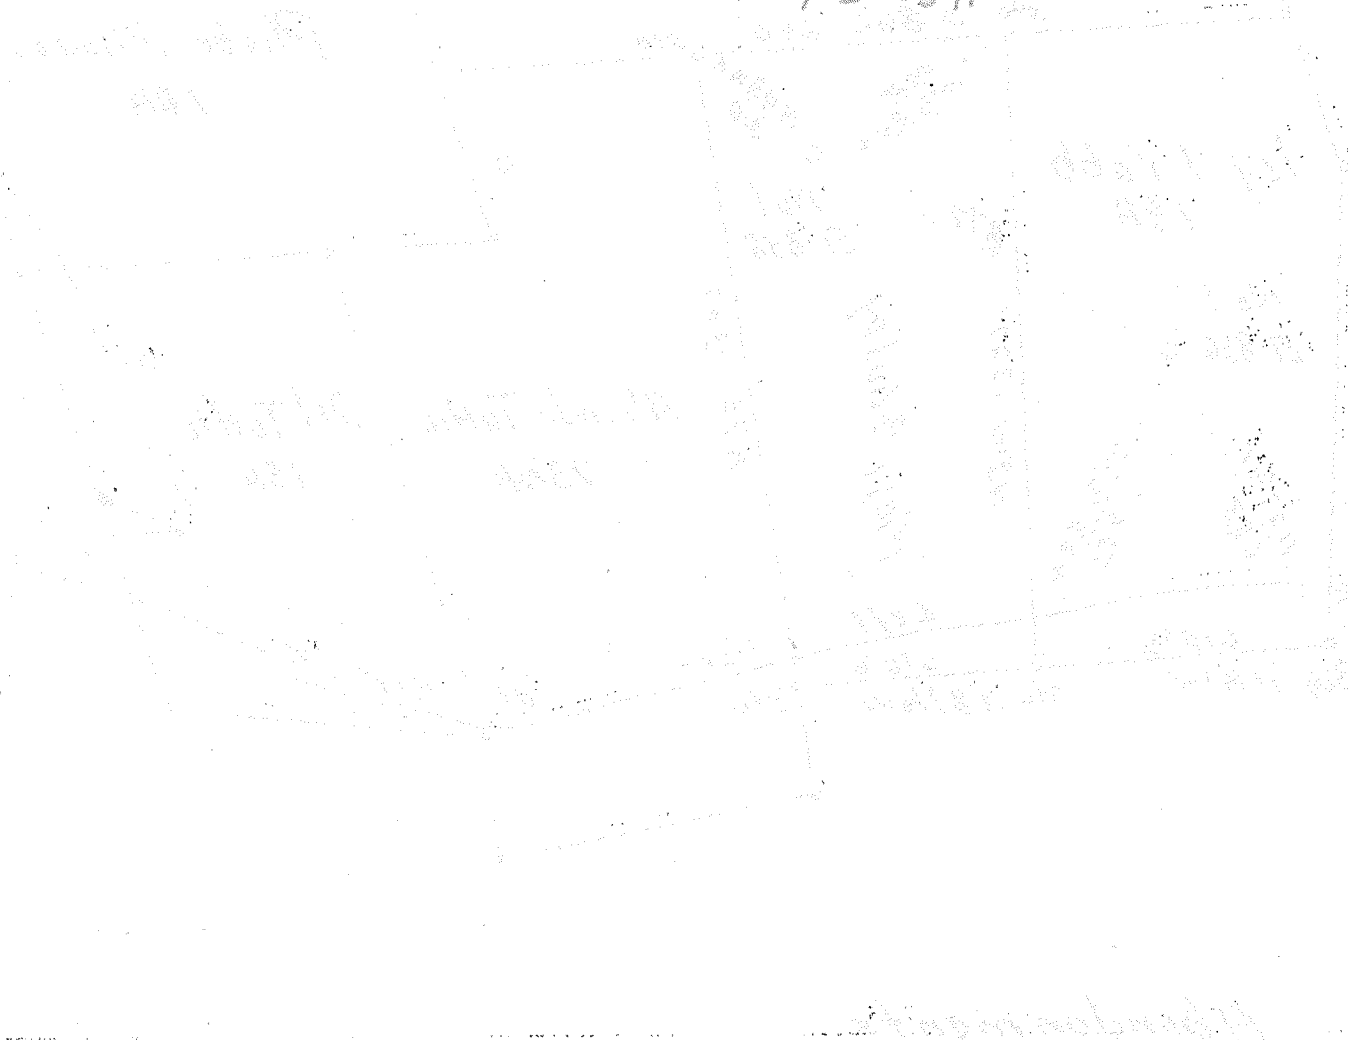

Notes on the left side of the page, including a section titled "GENERAL NOTES" and several paragraphs of handwritten text. The text appears to be a log or report related to the well operations, mentioning dates and specific details.

Notes on the right side of the page, including a section titled "GENERAL NOTES" and several paragraphs of handwritten text. The text appears to be a log or report related to the well operations, mentioning dates and specific details.