

Company	UNITED FUEL GAS CO.		
Address	CHARLESTON, W.VA.		
Farm	M.M. PARSONS		
Tract	Acres	Lease No.	4430
Well (Farm) No.		Serial No.	1049
Elevation (Spirit Level)	856.1		
Quadrangle	RIPLEY		
County	JACKSON	District	WASHINGTON
Engineer			
Engineer's Registration No.	662		
File No.	66 - 89	Drawing No.	
Date	Oct. 2, 1946	Scale	1" = 400'

STATE OF WEST VIRGINIA
DEPARTMENT OF MINES
OIL AND GAS DIVISION
CHARLESTON

WELL LOCATION MAP
FILE NO. JAC 92-A

+ Denotes location of well on United States Topographic Maps, scale 1 to 62,500, latitude and longitude lines being represented by border lines as shown.

- Denotes one inch spaces on border line of original tracing.

6-6-163 Gay



168

STATE OF WEST VIRGINIA
DEPARTMENT OF MINES
OIL AND GAS DIVISION

WELL RECORD
(Abandonment)

Oil or Gas Well GAS
(KIND)

Permit No. 92-A

Company United Fuel Gas Company

Address Box 1273, Charleston 25, W. Va.

Farm M. M. Parsons Acres 130

Location (waters) _____

Well No. 1049 Elev. 840

District Washington County Jackson

The surface of tract is owned in fee by _____
Address _____

Mineral rights are owned by A. M. C. Matheny
Address Gay, W. Va.

Drilling commenced 11-20-1918

Drilling completed 2-20-1919

Date Shot Not Shot From _____ To _____

With _____

Open Flow 22 /10ths Water in _____ Inch
6-5/8 /10ths Merc. in _____ Inch

Volume 9,000,000 Cu. Ft.

Rock Pressure 570 lbs. _____ hrs.

Oil 7 bbls., 1st 24 hrs.

Fresh water 1720 feet _____ feet

Salt water _____ feet _____ feet

Casing and Tubing	Used in Drilling	Left in Well	Packers
Size			
16	16'	16'	Callanan Kind of Packer
13			
10	780'	354' 4"	Size of <u>6-5/8 x 1 1/2</u>
8 1/4	1115'		
6 5/8	2064'	2064'	Depth set <u>358'</u> from Bottom
5 3/16	120'	120'	
3			Perf. top
2 1/2	2543	2543	Perf. bottom
Liners Used			Perf. top
			Perf. bottom


CASING CEMENTED _____ SIZE _____ No. Ft. _____ Date _____

COAL WAS ENCOUNTERED AT _____ FEET _____ INCHES

_____ FEET _____ INCHES FEET _____ INCHES

_____ FEET _____ INCHES FEET _____ INCHES

Formation	Color	Hard or Soft	Top	Bottom	Oil, Gas or Water	Depth Found	Remarks
Pittsburgh	Ss. - 18'		470	682			P-420'
Little Dunkard			1020	1040			Bt-712'
Big Dunkard			1080	1180			P-1000'
Sand			1265	1600			
Salt Sand			1547	1930	Gas	1650-1655	P-1629
Maxon			1930	1980	Water	1720	P-1980 + 1910'
Big Lime			1980 - 9	2000			P-2074'
Big Injun			2000	2060			P-2442'
Serea			2442	2460	Gas	2451	
Total Depth				2504			
				410			

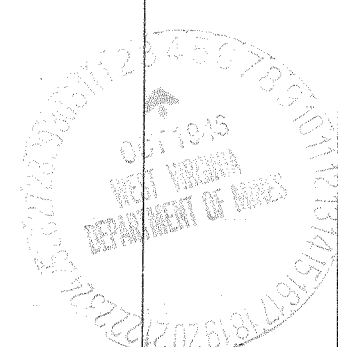

Formation	Color	Hard or Soft	Top	Bottom	Oil, Gas or Water	Depth Found	Remarks

Date October 2, 1946

APPROVED UNITED FUEL GAS COMPANY, Owner

By G. H. Moore Chief Engineer (Title) Ⓚ