

New Location
 Drill Deeper
 Abandonment

NOV 1 1954

Company UNITED FUEL GAS CO.
 Address CHARLESTON, W.VA.
 Farm C.W. & S.G. STARCHER
 Tract _____ Acres 1.72 Lease No. 10496
 Well (Farm) No. 1 Serial No. 717
 Elevation (Spirit Level) 629.0
 Quadrangle KENNA
 County JACKSON District WASHINGTON
 Engineer Robert A. Stull
 Engineer's Registration No. 2529
 File No. 62-85 Drawing No. _____
 Date 10-8-54 Scale 1"=1320'

STATE OF WEST VIRGINIA
 DEPARTMENT OF MINES
 OIL AND GAS DIVISION
 CHARLESTON

WELL LOCATION MAP
 FILE NO. JAC-137-A

+ Denotes location of well on United States Topographic Maps, scale 1 to 62,500, latitude and longitude lines being represented by border lines as shown.

- Denotes one inch spaces on border line of original tracing.

6-6-(163) Gay

Washington District, Jackson County, W. Va.

By United Fuel Gas Co.

On 1300 acres.

Keller Map C-24.

Elevation, 640⁺ ft.

Completed Oct. 27, 1915.

Gas well. 26/10 Merc. in 5¹/₂ ft.

S. P. - S-47 - W-56-57; on Mill Creek.

From Heck's notes.

	Top.	Bottom.
Big Lime	1658	-
Berea Sand (gas, 2273-2277') (El. 1629 ⁺)	2269	- 2277
Total depth		2305



STATE OF WEST VIRGINIA
DEPARTMENT OF MINES
OIL AND GAS DIVISION

301

WELL RECORD

Oil or Gas Well Gas
(KIND)

Quadrangle Kenna
Permit No. 1377
Company UNITED FUEL GAS CO.
Address P.O. Box 1273, Charleston 25, W. Va.
Farm C. W. Starcher Acres 1238
Location (waters) Tug Fork
Well No. 717 Elev. 629.0'
District Washington County Jackson
The surface of tract is owned in fee by _____
Address _____
Mineral rights are owned by R. C. Starcher, et al
Box 352 Address Ripley, W. Va.
Drilling commenced 8-17-15
Drilling completed 10-27-15
Date Shot _____ From _____ To _____
With _____

Casing and Tubing	Used in Drilling	Left in Well	Packers
Size			
16			Kind of Packer
13			<u>Anchor</u>
10	<u>390'</u>		Size of
8 1/4	<u>890'</u>		<u>3x5-3/16</u>
6 1/2		<u>1780'</u>	Depth set <u>2168'</u>
5 3/16		<u>1906'</u>	
3		<u>2317'</u>	Perf. top
2			Perf. bottom
Liners Used			Perf. top
			Perf. bottom


Open Flow 1.6 /10ths Water in 3 Inch
/10ths Merc. in _____ Inch
Volume 423,000 Cu. Ft.
Rock Pressure 965 lbs. _____ hrs.
Oil _____ bbls., 1st 24 hrs.
Fresh water 1728 feet 1869 feet
Salt water _____ feet _____ feet

CASING CEMENTED _____ SIZE _____ No. Ft. _____ Date _____

COAL WAS ENCOUNTERED AT _____ FEET _____ INCHES
_____ FEET _____ INCHES _____ FEET _____ INCHES
_____ FEET _____ INCHES _____ FEET _____ INCHES

Formation	Color	Hard or Soft	Top	Bottom	Oil, Gas or Water	Depth Found	Remarks
Sand			13	40			
✓ Little Dunkard			695	715			
✓ Big Dunkard			800	825			
✓ Gas Sand			890	990			
✓ Salt Sand			1400	1640			
✓ Little Lime			1640	1655			
✓ Pencil Cave			1655	1658			
✓ Big Lime			1658	1759	Water at 1728'		
✓ Big Injun			1759	1880	Water at 1869'		
✓ Berea			2269	2277	Gas 2273-2277		
Total depth			2305'		Deepened August 1922 -	2320'	

410

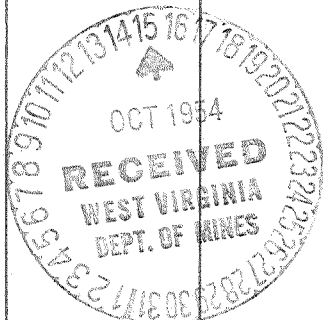

JAN 7 1955

