

GODFREY L. CABOT, INC.

WELL RECORD

*NSA*

*1241*

SERIAL NO. 828

OPERATING DISTRICT **Auk**

Map Square Lot No. Warrant No. **32-38**

FARM **Plus R. Levi**

NO. **1**

LEASE NO.

COUNTY **Kanawha**

TAX DISTRICT **Malden**

STATE **West Virginia**

DRILLING COMMENCED **May 1, 1935**

DRILLING COMPLETED **August 28, 1935**

CONTRACTOR **Fink & Buckner**

ADDRESS **Charleston, West Virginia**

ROCK PRESSURE RECORD

PRODUCING SAND RECORD

Sand **1285** lbs., in **24** hrs.

**Oriskany**

Sand, from **4808** to **4857** Init. Prod. **M. C. F. Gas**

Sand lbs., in hrs.

Sand, from to Init. Prod. **M. C. F. Gas**

Sand lbs., in hrs.

Sand, from to Init. Prod. **M. C. F. Gas**

OPEN FLOW Time, Condition:

**12** Water Mercury in **2** inch opening

CASING RECORD

Volume **164,160** M. C. F.

24 HOUR PRODUCTION TEST AFTER TUBING

M. C. F. Line Pressure

Bbls. Oil in 24 Hours

SIZE	WEIGHT	USED IN DRILLING	LEFT IN WELL	HOW CASING SET
<b>13</b>		<b>22'</b>	<b>22'</b>	<i>3.205 38° 20'</i> <i>3.05 W 81° 30'</i> <i>SE Charleston</i>
<b>10</b>		<b>288'</b>	<b>288'</b>	
<b>8 1/4</b>		<b>1427'</b>	<b>1427'</b>	
<b>5 1/2</b>		<b>4752'</b>	<b>4752'</b>	

TUBED AND SHUT IN Date

Backer, Size Kind  
Anchor, Depth Size Anchor


Perf. Top Bottom  
Perf. Top Bottom

SHOOTING RECORD

Acid Shot with **50 gts.** from **Shot in Oriskany** Date **8/29/35**  
Gauge Before { Acid Shot } Min. Hrs. After { Acid Shot }

ELEVATION: **951.02 Ground**

FORMATION	COLOR	TOP	BOTTOM	STEEL LINE MEASUREMENTS	HARD OR SOFT	OIL, GAS OR WATER	DEPTH FOUND	REMARKS
Clay		0	20					
Dark Slate		20	40					
Sand		40	60					
Lime		60	90					
Slate		90	110					
Sand		110	186					
Slate		186	210					
Old Coal Mine		210	213			<b>Water 210'</b>		<b>8 Bailers per hour.</b>
Slate		213	250					<b>Water disappeared at 250'</b>
Old Coal Mine		250	260					
Slate		260	280					
Sand		280	310					
Slate and L. Shells		310	360					
Sand		360	415					
Slate & Shells		415	460					
Sand		460	530					
Dark Slate		530	570					
Sand		570	615					
Hard Lime		615	645					
Salt Sand		645	762		<b>Salt Water</b>		<b>720'</b>	<b>2 Bailers Pr. Hr.</b>
Slate		762	770					
Salt Sand		770	780					
Slate Break		780	785					
Salt Sand		785	973		<b>Salt Water</b>		<b>910'</b>	<b>Hole full</b>
Slate & L. Shells		973	985					

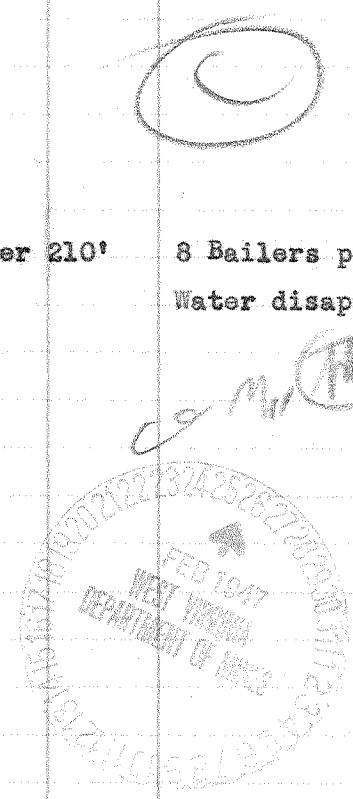

SERIAL NO. **828**

FARM **Plus R. Levi**

NO. **1**

OPERATING DIST. **Malden**

MAP SQUARE LOT NO. **32-38** WARRANT NO.

