



RECEIVED
Office of Oil & Gas

MAY 4 2012

Department of Environmental Protection

West Virginia Department of Environmental Protection
Office of Oil and Gas
WELL LOCATION FORM: GPS

API: 47-039-00332-P WELL NO.: 4
FARM NAME: Chelyan Coal & Land Co.
RESPONSIBLE PARTY NAME: Gary E. Acord
COUNTY: Kanawha DISTRICT: Cabin Creek
QUADRANGLE: Belle
SURFACE OWNER: Penn Virginia (erroneously listed as Shonk Land Co. on previous permit application)
ROYALTY OWNER: Penn Virginia (erroneously listed as Shonk Land Co. on previous permit application)
UTM GPS NORTHING: 4220804.915
UTM GPS EASTING: 454699.008 GPS ELEVATION: 1,224.78 feet

The Responsible Party named above has chosen to submit GPS coordinates in lieu of preparing a new well location plat for a plugging permit or assigned API number on the above well. The Office of Oil and Gas will not accept GPS coordinates that do not meet the following requirements:

1. Datum: NAD 1983, Zone: 17 North, Coordinate Units: meters, Altitude: height above mean sea level (MSL) – meters.
2. Accuracy to Datum – 3.05 meters
3. Data Collection Method:
Survey grade GPS X: Post Processed Differential _____
Real-Time Differential _____
Mapping Grade GPS _____: Post Processed Differential _____
Real-Time Differential _____


4. Letter size copy of the topography map showing the well location.

I the undersigned, hereby certify this data is correct to the best of my knowledge and belief and shows all the information required by law and the regulations issued and prescribed by the Office of Oil and Gas.

Gary E. Acord PE ENGINEER
Signature Title

5/11/12
Date

39.00332 P

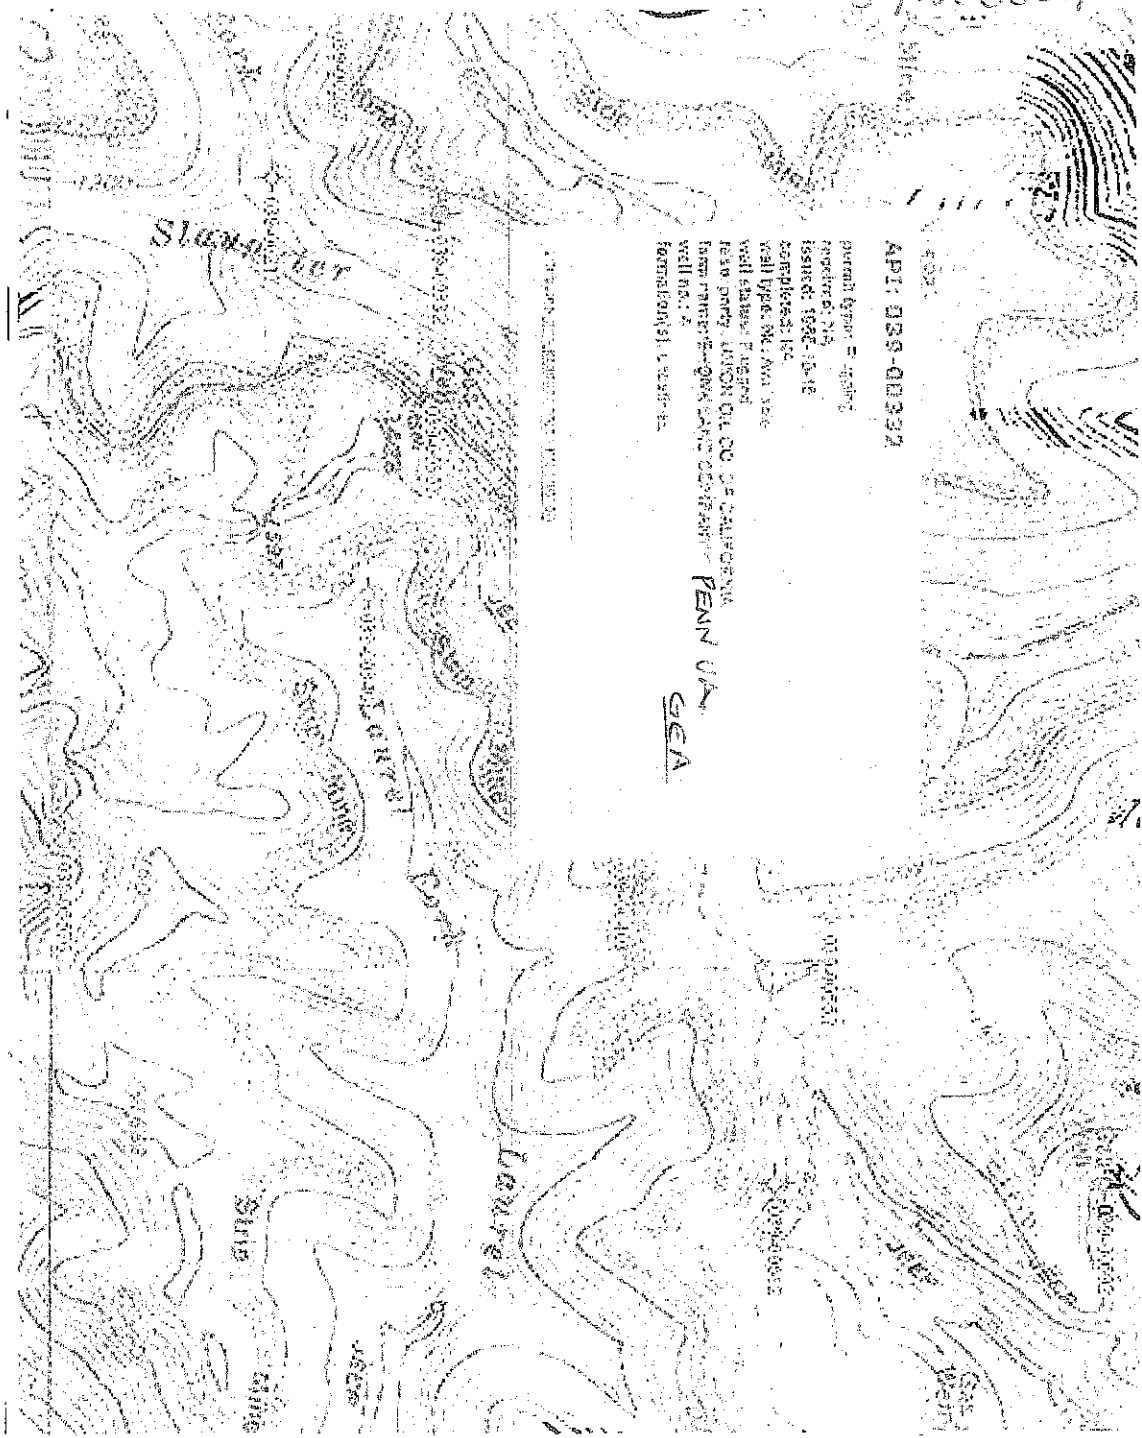

API: 039-00332
 permit type: 4881
 received: 1981
 issued: 1981-10-18
 completed: 1981
 well type: Oil, Ann. Use
 well status: Plugged
 Farm: Pennine-Guyon Oil Co. of California
 Farm: Pennine-Guyon Land Company
 well no.: 2
 formation: 1, 2, 3, 99, 100

PENN VA
 GEA

Well Status	Well Type	Well Use	Firm Name	Well No.	Lon	Lat
Plugged	Not Available	Not Available	SHONK LAND COMPANY	4	-81.518215	38.132373
Plugged	Not Available	Not Available	SHONK LAND COMPANY	4	-81.518215	38.132373

RECEIVED
 Office of Oil & Gas

Receipt 5/01/12
 FROM
 GAHEY PERSINGER
 PENN VA