


LATITUDE 38° 35'

LONGITUDE 81° 35'

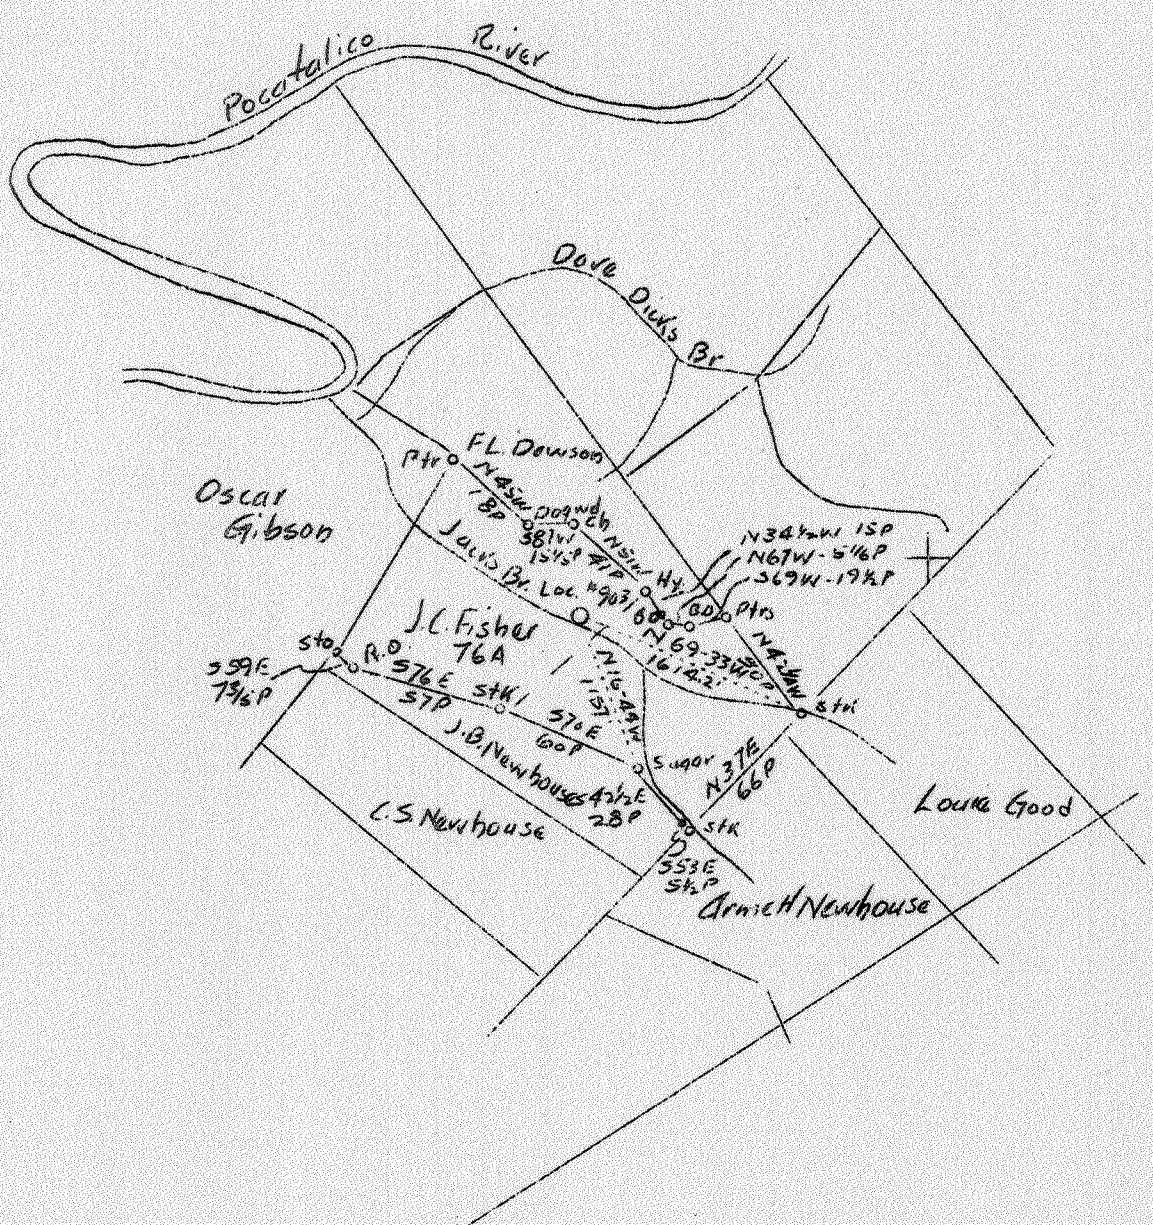

1.82 W
3.43 R

Ground Elev. 697.72

Company	Godfrey L. Cabot, Inc.
Address	Union Bldg., Charleston, W. Va.
Farm	J. C. Fisher et al
Tract	Acres 76 Lease No. 4-547
Well (Farm)	No. 1 Serial No. 903
Quadrangle	Kenna (SR)
County	Kanawha
District	Poca
Engineer	O. L. Fitz Randolph
Engineer's Registration No.	806
File No.	Date 4-12-37
Drawing No.	Scale 1" = 1520'

STATE OF WEST VIRGINIA
Department of Mines
OIL AND GAS DIVISION
Charleston

WELL LOCATION MAP
File No. KAN-366

+ Denotes location of well on U.S. Topographic Maps, scale 1 to 62,500 latitude and longitude lines being represented by border lines as shown
- Denotes one inch spaces on border line of original tracing.

6-6-1937

GOSFREY L. GADGET, INC.
Box 548

J. F. Fisher et al #1, Serial #903
Poca District, Hancock County, W. Va.

Charleston, W. Va.
Casing & Tubing

Initial Open Flow

Drilling Commenced June 1, 1937
Drilling Completed Sept. 28, 1937

Size	Used in	
	Drilling	Well
16"	36'	36'
18-3/8"	377	377
10-5/4"	1543	1543
8-5/8"	2140	2140
7"	4778	4778

125/10 Hg. 6-5/8" - 20,100 H.

Elevation 697.72

Surface	0	50			
Red Rock	50	60			
Lime	60	80			
Red Rock	80	110			
Blue Slate	110	120			
Red Rock	120	188			
White Slate	188	252			
Red Rock	252	330			
White Slate	330	335			
Red Rock	335	360			
Slate	360	382			
Sand	382	388			
Red Rock	388	400			
Lime	400	445			
Sand	445	490			
Slate	490	500			
Sand	500	560			
Slate	560	585			
Sand	585	575			
Lime	575	625			
Slate	625	640			
Lime	640	670			
Sand	670	700			
Slate & Lime	700	714			
Sand	714	744			
Slate	744	793			
Sand	793	814			
Slate	814	820			
Sand	820	826			
Slate & Shells	826	1016			
Sand	1016	1046			
Slate	1046	1074			
Sand	1074	1215	Show of Oil	1078'	
Lime	1215	1268	" " Gas	1084'	Not enough to gauge
Slate & Shells	1268	1290	Salt Water	1088'	1 bailer per hour
Sand	1290	1305	" "	1200	dx Hole full
Sand & Lime	1305	1480			
Coal	1480	1482			
Daxton Sand	1482	1506			
Little Lime	1506	1517			
Pencil Cave	1517	1521			
Big Lime	1521	1676	Show Gas	1538'	Not enough to gauge
Sand	1676	1720	" "	1633'	" " " "
Slate	1720	1750			
Lime	1750	1840			
Slate	1840	1861			
Sand	1861	1860			
Slate & Shells	1860	2128			
Brown Shale	2128	2140	Brown Shale	4410	4745
Berea Grit	2140	2145	Corn. Lime	4745	4806
Slate & Shells	2145	2750	Oriskany Sand	4806	4881
Lime	2750	2775	*otal Depth	4881	4881
Slate	2775	3330			
Lime	3330	3380			
Slate	3380	3400			
Lime	3400	3450			
Slate & Shells	3450	3510			
Brown Shale	3510	3955			
White Slate	3955	4410			

Gas 4886' 15/10 Mer. in 2"
" 4874' 43/10 " 20-5/8"
" 4881' 125/10 " 8-5/8"