

0 1 2 3 LATITUDE 38° 35'


1

2

3

LONGITUDE 81° 35'

Poca C. & L. Co.

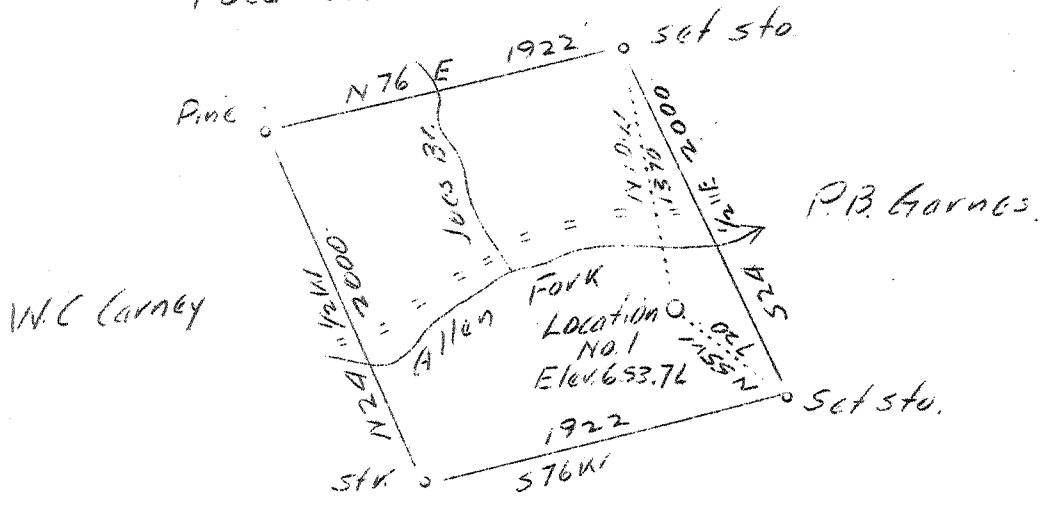

Poca C. & L. Co.  
 ABD  
 10/43  
 4.48 W  
 1.36 R

Company	Joe Rubin
Address	1900 19th St. Parkersburg, W. Va.
Farm	Carney Heirs
Tract	Acres 87 Lease No.
Well (Farm) No.	1 Serial No.
Quadrangle	Kenna (50)
County	Kanawha
District	Poca
Engineer	C.E. Krebs
Engineer's Registration No.	9
File No.	11,489 Drawing No.
Date	8-3-37 Scale 1"-1000'

STATE OF WEST VIRGINIA  
 Department of Mines  
 OIL AND GAS DIVISION  
 CHARLESTON

WELL LOCATION MAP  
 File No. KAN-438

Denotes location of well on United States Topographic Maps, scale 1 to 62,500, latitude and longitude lines being represented by border lines as shown.

Denotes one inch spaces on border line of original tracing.

WEST VIRGINIA DEPARTMENT OF MINES

OIL & GAS DIVISION

WELL RECORD

Permit No. Kan-438

Gas Well

Kenna Quad.

CASING & TUBING

Company	Joe Rubin, et al	14"	106
Address	Parkersburg, W. Va.	10	580
Farm	Carney Heirs Acres -	8-1/4	1879
Location	-	5-3/16	4815
Well No.	One		
District	Poca		Elev. 652.51'
Surface & Mineral	-		County Kanawha
Drilling commenced	March 17, 1938		
Drilling completed	- July 1938 - vol XVI		
Open Flow	-		
Volume	-		
Rock Pressure	-		
Shot	-		
Water	-		3500 mcf - vol XVI

Formation Color		Mar 5	TOP	Base	Result	Formation Color	Mar 5	TOP	Base	Result
Red			0	10		Slate	white		4075	4490
Slate			10	90		Slate			4490	4765
Sand			90	95		Slate	black		4765	4798
Slate - Water			95	130		Lime			4798	4807
Red			130	150	Hole	Sand			4907	
Slate			150	210	Full	Gas at				4908
Red			210	235	Water	Total Depth				4928
Slate			235	245						
Red			245	270						
Blue Slate			270	280						
Sand			280	295						
Slate			295	305						
Red			305	360						
Slate			360	435						
Sand			435	485						
Red			485	500						
Slate			500	525						
Sand			525	545						
Sandy Slate			545	620						
Sand			620	690						
Slate			690	710						
Sand			710	735						
Slate			735	864						
Sand			864	890						
Slate			890	1175						
Sand			1175	1200						
Slate			1200	1210						
Sand Salt			1210	1563	Full Water					
Slate			1563	1587						
Sand			1587	1605						
Slate Pencil			1605	1610						
Sand			1610	1657						
Lime			1657	1803						
Sand			1803	1832						
Slate			1832	1866						
Lime			1866	1900						
Sandy Shale			1900	1990						
Slate			1990	2270						
Berea Sand			2270	2280						
Slate & Shells			2280	2800						
Slate			2800	3485						
Shale			3485	3560						
Slate			3560	3760						
Shale			3760	3780						
Top Brown Cinnamon			3780	3830						
Slate			3830	3860						
Shale	brown		3860	4075						