


LATITUDE 38° 35'

LONGITUDE 81° 35'

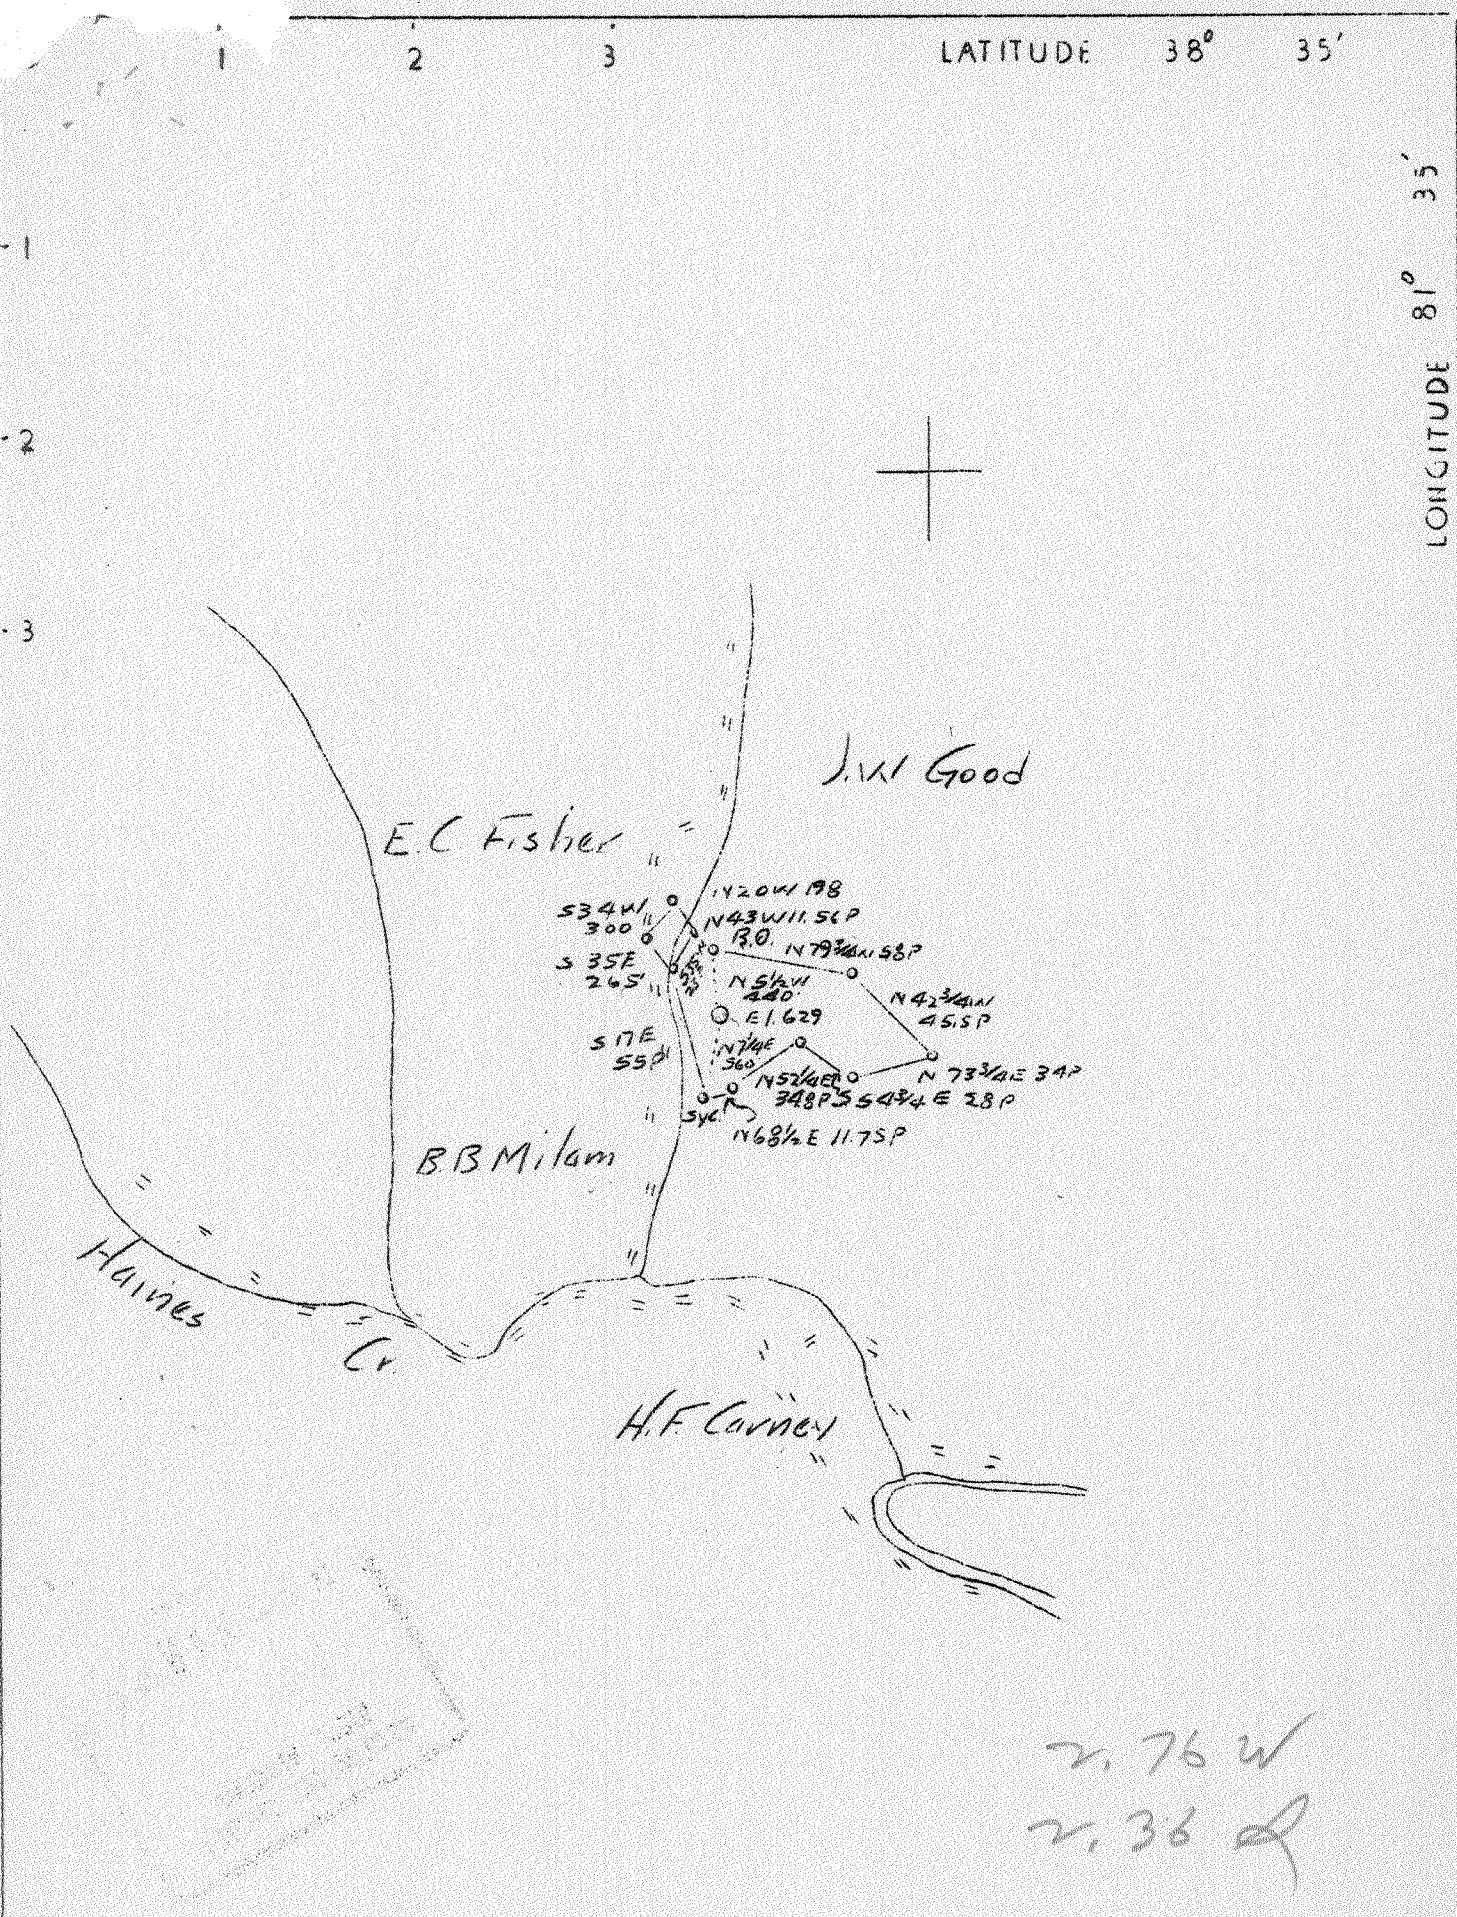

2.76 W
2.36 S

Company	Godfrey L. Cabot, Inc.
Address	600 Union Bldg., Charleston, W. Va.
Farm	Myrna & Homer Jarrett
Tract	Acres 26 Lease No.
Well (Farm) No.	1 Serial No. 914
Elevation (Spirit Level)	629'
Quadrangle	Kenna 50
County	Kanawha District Pocahontas
Engineer	O.L. Fitz Randolph
Engineer's Registration No.	806
File No.	Drawing No.
Date	7/13/37 Scale 1"=1320'

STATE OF WEST VIRGINIA
Department of Mines
OIL AND GAS DIVISION
CHARLESTON

WELL LOCATION MAP

File No. KAN-453

+ Denotes location of well on United States Topographic Maps, scale 1 to 62,500, latitude and longitude lines being represented by border lines as shown.

- Denotes one inch spaces on border line of original tracing.

RECORD

CASING AND TUBING

INITIAL OPEN FLOW

Jarrett #1, Trial #814

Man District, Kanawha Co., W. Va.

453 Paca Dist

Drilling commenced-Sept. 21, 1937

Drilling completed-Jan. 24, 1938

Elevation - 629

Soil	Red	0	5
Red Rock	Red	5	10
Blue Mud		10	40
Quick Sand	Blue	40	50
Blue Rock		50	60
Blue Mud		60	70
Sand	White	70	90
Black Slate		90	110
Red Rock	Red	110	187
Blue Rock		187	193
Red Rock		193	249
Blue Rock		249	325
Slate	White	325	338
Lime	Blue	338	350
Red Rock		350	358
Lime	Blue	358	370
Red Rock		370	380
Blue Rock		380	408
Red Rock		408	433
Blue Rock		433	518
Slate	White	518	558
Slate	"	558	568
Lime	Blue	568	577
Slate	White	577	589
Sand	"	589	665
Gritty Lime	Blue	665	694
Coal	Black	694	702
Black Slate		702	720
Sand	White	720	800
Slate & Shells	Blk.	800	1090
Gritty Lime		1090	1095
Slate & Shells		1095	1155
Sand		1155	1447
Slate		1447	1470
Sand		1470	1515
Slate		1515	1522
Lime		1522	1538
Slate		1538	1545
Big Lime		1545	1635
Injun Sand		1635	1755
Lime Shells		1755	1850
Slate		1850	1975
Slate & Shells		1975	2050
Slate		2050	2165
Lime Shell		2165	2182
Slate		2182	2325
Slate & Shell		2325	2385
Slate		2385	2538
Slate		2538	2625
Slate & Shell		2625	2700
Slate		2700	3025
Slate & Shell		3025	3400
Slate		3400	3800
Brown Shale		3800	3912
Lime Shell		3912	3917
Slate		3917	4470
Brown Shale		4470	4695
Black Shale		4695	4761
Corniferous Lime		4761	4874
Oriskany Sand		4874	4881

Size	Used in Drilling	Left in Well
16"	53'	53'
13"	512'	512'
10"	1565'	1565'
8-1/4"	1787'	1787'
6-5/8"	4782'	4782'

130/10 Hg. in 7" - 24,000 M.C.F.
 Oil Saver Head
 Not shot
 Rock Pressure - 1825# 24 hrs.
 Shut in 1/24/38 - not tubed
 7" O.D. casing cemented in by
 Halliburton Oil Well Cementing Co.
 Water 72' Fresh
 Water 360'
 Hard
 Hard Water 1193'
 Soft Water 1246'
 Bad hole at 1198'
 Bad hole at 1280
 Hole full of water 1246 to 1256
 Gas
 Light show at 3850'
 Gas 4876' 50/10 Water in 1"
 Gas 4881' 130/10 Hg. in 7" O.D.
 Oil Saver Head

