

New Location    
 Drill Deeper    
 Abandonment  - 10-24-72

Company Cities Service Oil Co.  
~~Continental Carbon Co.~~

Address BOX 873 - CHARLESTON - W. VA., 25323

Farm B. F. JONES

Tract     Acres 93 Lease No. C-248

Well (Farm) No. G-1 Serial No. GW-407

Elevation (Spirit Level) 891.0

Quadrangle CHARLESTON - N. E.

County KANAWHA District E. I. K.

Engineer J. N. Sells

Engineer's Registration No. 772

File No.     Drawing No.    

Date 9-27-37 Scale 1" = 660'


STATE OF WEST VIRGINIA  
 DEPARTMENT OF MINES  
 OIL AND GAS DIVISION  
 CHARLESTON

WELL LOCATION MAP  
 FILE NO. KAN-485-P

+ Denotes location of well on United States Topographic Maps, scale 1 to 62,500, latitude and longitude lines being represented by border lines as shown.

- Denotes one inch spaces on border line of original tracing.

DEEP WELL

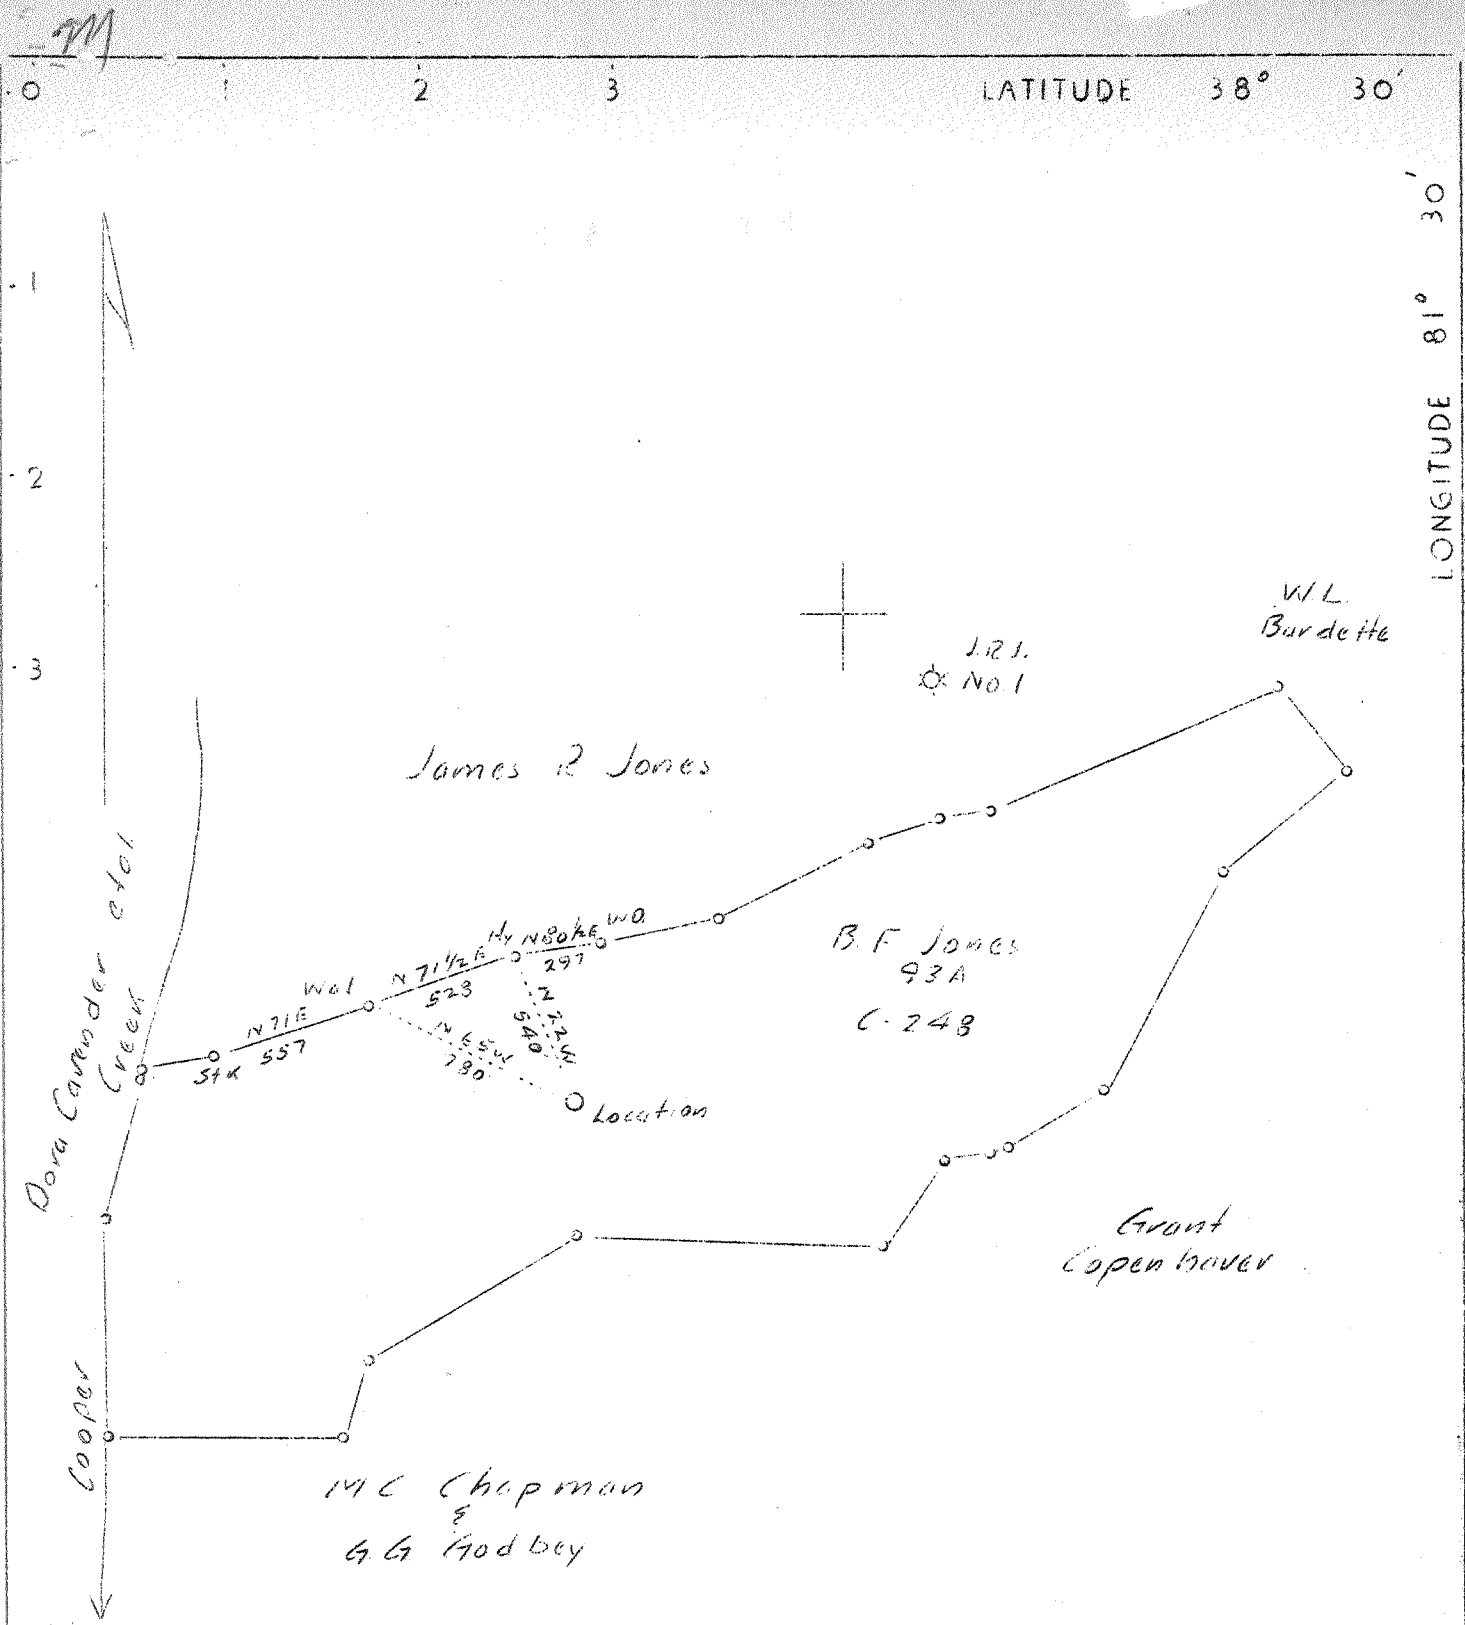

(269-Oriskany Chart)

7.5' OGIS loc  $\frac{15 \text{ min}}{2.875}$   
 38° 30' 2.875  
 81° 32' 30" .94W  $\frac{3.10W}{2.98}$

3.22 W  
 2.9 8

Company	Columbian Carbon Co.
Address	Box 1240, Charleston, W.Va.
Farm	B.F. Jones
Tract	Acres 93 Lease No. C-248
Well (Farm)	No. 1 Serial No.
Elevation (Spirit Level)	891'
Quadrangle	Charleston (718)
County	Kanawha District Elk
Engineer	J.N. Sell
Engineer's Registration No.	772
File No.	Drawing No.
Date	9-27-37 Scale 1"-660'

STATE OF WEST VIRGINIA  
 Department of Mines  
 OIL AND GAS DIVISION  
 CHARLESTON

WELL LOCATION MAP

File No. KAN-485

+ Denotes location of well on United States Topographic Maps, scale 1 to 62,500, latitude and longitude lines being represented by border lines as shown.

— Denotes one inch spaces on border line of original tracing.

6-6 19



STATE OF WEST VIRGINIA  
DEPARTMENT OF MINES  
OIL AND GAS DIVISION

RECEIVED

FEB 1 1973

OIL & GAS DIVISION  
DEPT. OF MINES  
AFFIDAVIT OF PLUGGING AND FILLING WELL

AFFIDAVIT SHOULD BE MADE IN TRIPLICATE, ONE COPY MAILED TO THE DEPARTMENT, ONE COPY TO BE RETAINED BY THE WELL OPERATOR AND THE THIRD COPY (AND EXTRA COPIES IF REQUIRED) SHOULD BE MAILED TO EACH COAL OPERATOR AT THEIR RESPECTIVE ADDRESSES.

Alex J. Bruen Jr. ~~SOLE OPERATOR OR OWNER~~  
195. 83rd., New York, New York  
ADDRESS

Alexander M. Bruen Heirs  
CITIES SERVICE OIL COMPANY  
NAME OF WELL OPERATOR  
Box 873, Charleston, W. Va. 25323  
COMPLETE ADDRESS

B. F. Jones  
COAL OPERATOR OR OWNER  
Rt. Box 136 Charleston W. Va.  
ADDRESS

October 20, 1972 19  
WELL AND LOCATION  
Elk District

Charles S. Bannerman  
LEASE OR PROPERTY OWNER  
120 Broadway New York, New York  
ADDRESS

Kanawha County  
Well No. "G" #1, GW-407  
Benjamin F. Jones Farm

STATE INSPECTOR SUPERVISING PLUGGING Fred Burdette

AFFIDAVIT

STATE OF WEST VIRGINIA,  
County of Braxton } ss:

Steve Duckworth and Eugene Prunty  
being first duly sworn according to law depose and say that they are experienced in the work of plugging and filling oil and gas wells and were employed by Cities Service Oil Company, well operator, and participated in the work of plugging and filling the above well, that said work was commenced on the 1 day of January, 1973, and that the well was plugged and filled in the following manner:

SAND OR ZONE RECORD FORMATION	FILLING MATERIAL	PLUGS USED SIZE & KIND	CASING	
			CSG PULLED	CSG LEFT IN
	Filled hole with Gel (6% Bentonite Mud)		2429	2475-6 5/8
			820	763-8 5/8
	5040-4940 20 sacks	100' cement		
	2420-2400 7 sacks	20' cement		44'- 14
	1640-1620 7 sacks	20' cement		
	820-800 10 sacks	20' sacks		
	300-50	clay		
	50- surface 40 sacks	50' cement		
	84 sacks cement			
	40 sacks gel			
COAL SEAMS			DESCRIPTION OF MONUMENT	
(NAME)			10" x 14' Pipe erected as	
(NAME)			prescribed by law	
(NAME)				
(NAME)				

and that the work of plugging and filling said well was completed on the 16 day of January, 1973.

And further deponents saith not.

Sworn to and subscribed before me this 20 day of Jan, 1973.

My commission expires:

2-10-77

*Steve Duckworth*  
*Eugene Prunty*  
*Notary Public*

Permit No. Kan. 485-P

C. NOLL