


4 m

P

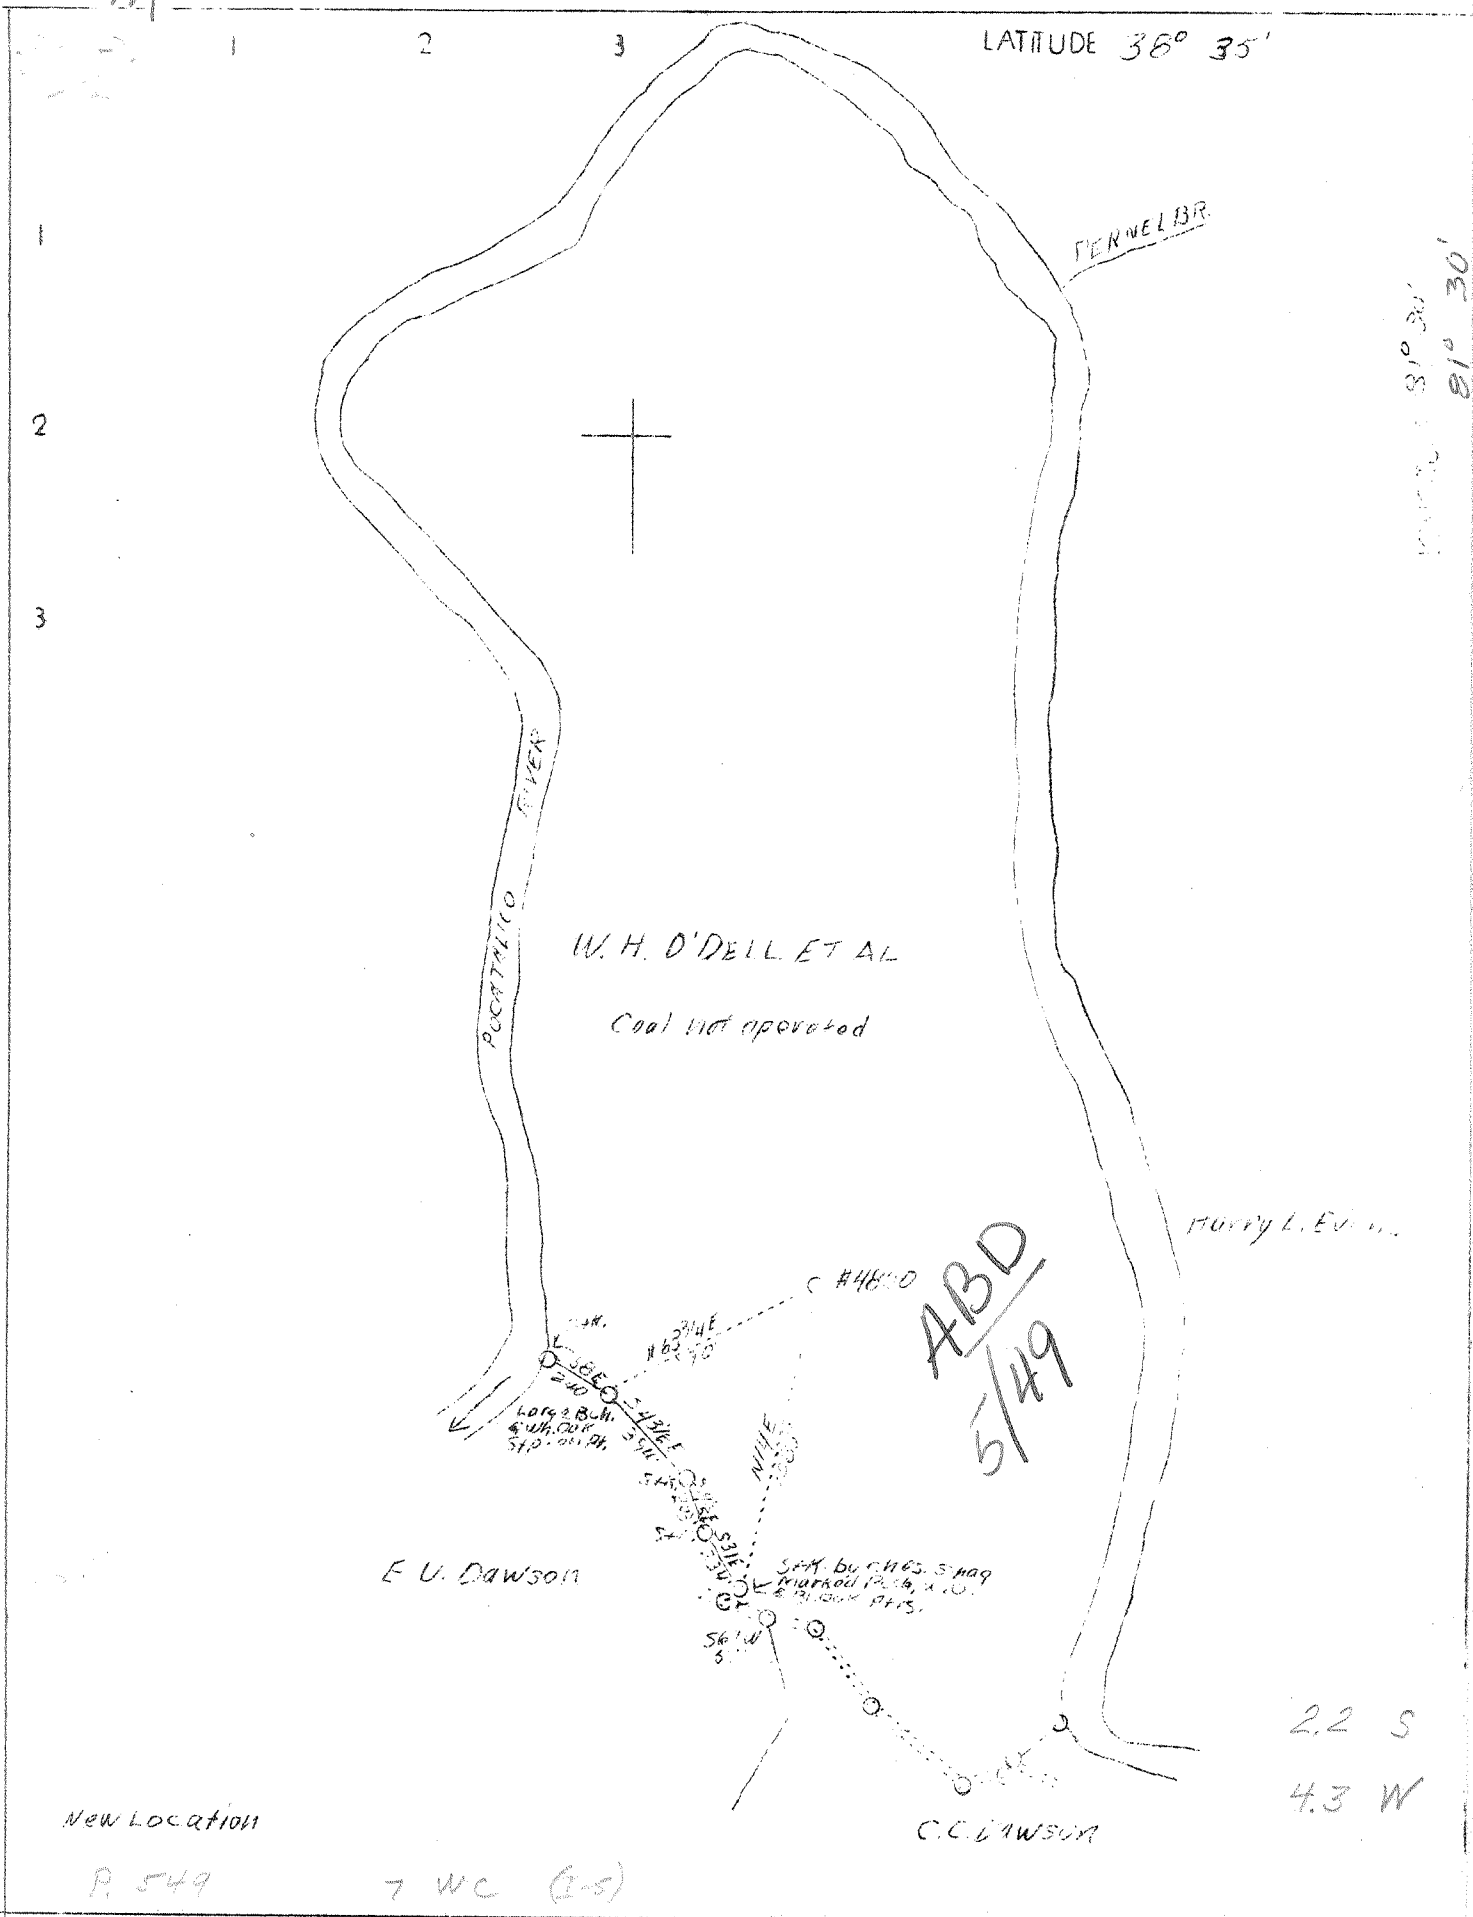

Company United Fuel Gas Co.  
 Address Charleston, W. Va.  
 Farm W. H. O'Dell et al  
 Acres 228  
 Lease No. 40123  
 Well (Farm) No. 1  
 Serial No. 4800  
 Elevation (Spirit Level) 895.25'  
 Quadrangle Kenna ~~Se.~~ Se.  
 County Kanawha  
 District Poca  
 Engineer G. A. Cunningham  
 Eng. Reg. No. 659  
 File No. 64-73  
 Date June 13, 1938  
 Scale 1" = 660'

STATE OF WEST VIRGINIA  
 Department of Mines  
 OIL & GAS DIVISION  
 Charleston

WELL LOCATION MAP  
 File No. K211-549

X Denotes location of well on U. S. Topographic Maps, scale 1 to 62,500, latitude and longitude lines being represented by border lines as shown.

- Denotes one inch spaces on border line of original tracing.

7-6-1938 ✓ Deep Well

WEST VIRGINIA DEPARTMENT OF MINES

OIL & GAS DIVISION

WELL RECORD

Permit No. Kan-549

Gas Well

Kenna Quad.

CASING & TUBING

Company	United Fuel Gas Co.	10-3/4	747	703
Address	Charleston, W. Va.	8-5/8	1954	1904
Farm	W. H. O'Dell et al ACRES 228	7	5010	5010
Location	Poca River	2	36	7
Well No.	4800 ELEV. <u>898.65</u>			
District	Poca - Kanawha County			
Surface & Mineral	W. H. O'Dell et al, Charleston, W.Va.			
Drilling commenced	July 13, 1938			
Drilling completed	Sept. 21, 1938			
Shot	Not shot			
Open Flow	48/10ths Merc. in 7 inch			
Volume	<u>10,817,000</u> c.f.			
Rock Pressure	1470 lbs. 48 hrs.			
Salt Water	1285			

Formation	Color	Mar	TOP	Base	Result	Formation	Color	Mar	TOP	Base	Result
Sub Soil			0	34		Corniferous			4962	5077	
White Sand			34	48		Oriskany			5077	5086	Gas pay
Red Rock			48	55		Total Depth			5099		
Blue Slate			55	127							
Red Rock			127	137							
Blue Slate			137	154							
White Sand			154	205							
Blue Slate			205	225							
Red Rock			225	267							
Lime			267	294							
Blue Slate			294	298							
Red Rock			298	404							
Blue Slate			404	430							
Red Rock			430	530							
Blue Slate			530	570							
Lime			570	585							
Blue Slate			585	610							
White Sand			610	720							
Slate			720	760							
Sand			760	784							
Slate			784	810							
Lime			810	825							
Slate & Shells			825	880							
Sand			880	904							
Slate			904	930							
Sand			930	962							
Slate			962	990							
Sand			990	998							
Slate & Shell			998	1004							
Sand			1004	1058							
Slate			1058	1255							
Salt Sand			1255	1635	Salt Water 1285 Hole Full						
Little Lime			1635	1677							
Big Lime			1677	1829	Gas 5086-5089						
Tnjun			1829	1861							
Slate			1861	1870							
Lime			1870	1880							
Slate			1880	1905							
Slate & Weir Shells			1905	2262							
Brown Shale			2262	2272							
Berea Shell			2272	2280	Gas Show						
Slate & Shells			2280	3930							
Brown Shale			3930	4060							
Slate & Shells			4060	4625							
Brown Shale			4625	4868							
White Slate			4868	4889							
Black Shale			4889	4962							

4962  
899  
40