


LATITUDE 38° 35'

LONGITUDE 81° 30'

2.195
4.09W

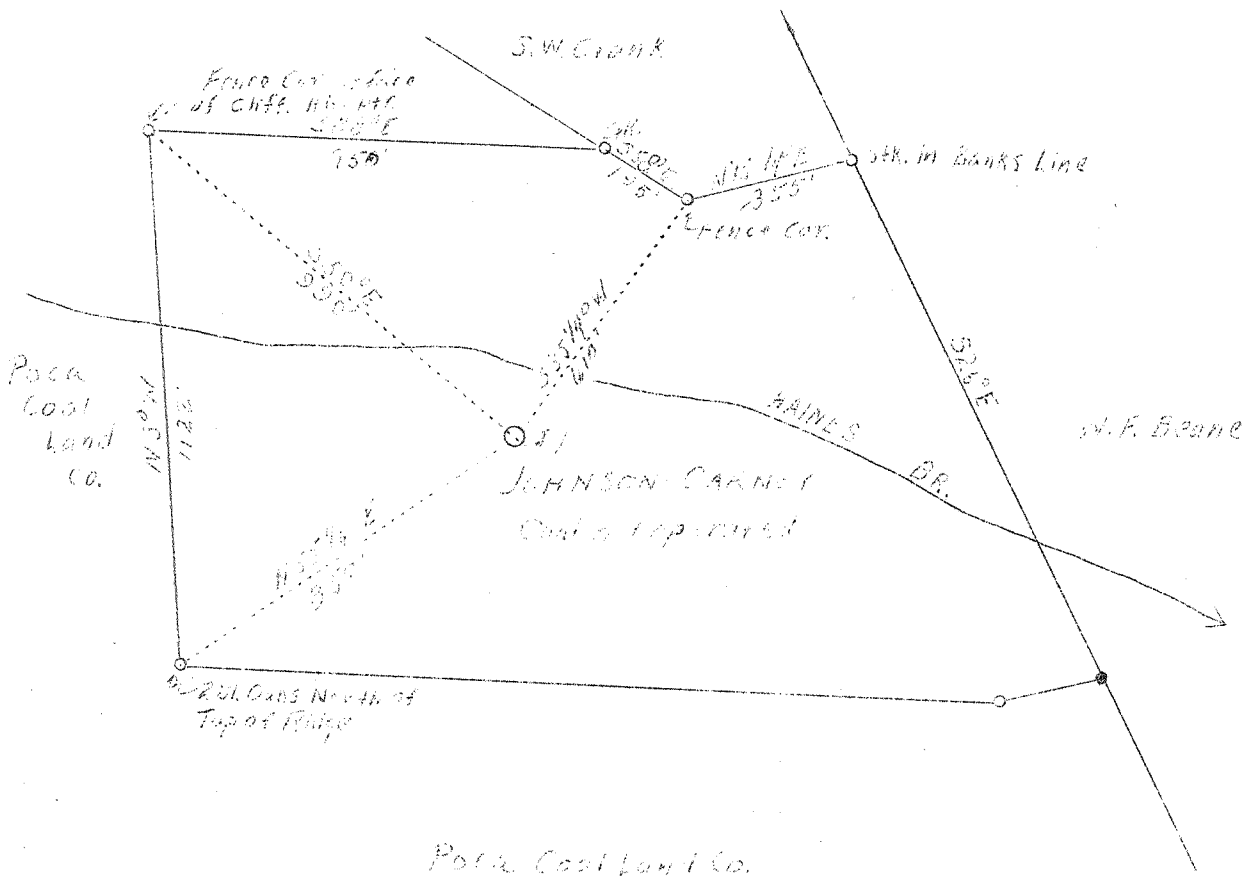

ABD
5/51

NEW LOCATION

Company Mullins Gas Co.
 Address Charleston, W.Va.
 Farm Johnson-Carney
 Tract
 Acres 46½
 Well (Farm) No. 1
 Elevation (S.L.) Not given
 Quadrangle Kenna
 County Kanawha
 District Poca
 Engineer G.A. Cunningham
 Engineer's Reg. #859
 File No. 60-73
 Date April 3, 1933
 Scale 1"=400'


STATE OF WEST VIRGINIA
 Department of Mines
 OIL AND GAS DIVISION
 CHARLESTON

WELL LOCATION MAP

File No. 1001-623

xDenotes location of well on United States Topographic Maps, scale 1 to 62,500, latitude and longitude lines being represented by border lines as shown.

-Denotes one inch spaces on border line of original tracing.

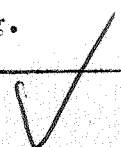

WEST VIRGINIA DEPARTMENT OF MINES

OIL & GAS DIVISION

WELL RECORD

Permit No. Kan-628

Gas Well

Konna Quad.

CASING & TUBING

Company	Mullins Gas Co.	16 Conductor	16
Address	Charleston, W. Va.	14	163 163
Farm	Johnson-Carney AGRES 46-1/4	10-3/4	643 643
Location	Haynes Br. of Poca River	8-5/8	1933 1933
Well No.	One ELEV. 754	7 O.D.	4894 4894
District	Poca - Kanawha County	2-3/8	5024 5024
Surface	E.M. Johnson, Sissonsville, W. Va.		
Mineral	1/2 J.P. Carney, 1/2 E.M. Johnson & 1/2 Ceclo Pearson	Packer - Parmaco Bot. Hole	
Commenced	4/27/39	Size - 8-5/8x10x12	20 sacks cement
Completed	7/29/39	Depth set - 1935	
Open Flow	200/10ths Water in 7" O.D.	7 1/2	
Volume	5,984,000 c.f.	32 half inch bull plugs	
Rock Pressure	1400 lbs. 12 hrs.	on bottom	
Fresh Water	125 and 150	200' csg. 7" cemented	
Salt Water	1310	July 15, 1939	

Formation Color ^{Mar} TOP Base Result				Formation Color ^{Mar} TOP Base Result			
Soil		0	6	Oriskany		4992	5028-5
Clay		6	30	Total Depth			5028-5
Slate		30	50	Gas at 2329 - test 2/10 W 1" O 1/2			
Red Rock		50	75	" " 4994 to 5002 - test 200/10 W 7"			
Lime		75	125	" " 5007 - test 2/10 M 7"			
Sand		125	167	" " 5016 to 5018 - test 10/10 W 7"			
Red Rock		167	350	Top Oriskany Sand 4992 (SLM)			
Blue Slate		350	370	Gas test at 4995 35/10 W 2" 10 PM 7/23/39			249000 ft.
Red Rock		370	390	Gas 4994 - 5002 (11:30 AM 35/10 W 2")			
Slate		390	435	(R.P. 610# 9:15 AM 7/24/39)			
Red Rock		435	450	Drilling at 5004 4:30 PM 7/24/39			
Slate		450	500	Gate leaking badly - 9:45 AM 660#			
Sand		500	522	Gate still leaking - casing & other			
Pink Rock		522	528	connections tight - 700# 10:15 AM			
Lime		528	540	Blown off at 10:21 to 10:24 AM			
Red Rock		540	565	Drilling resumed at 11:40 AM			
Sand		565	594	11:45 AM 100/10 W 2" 421,000 cf			
Slate		594	640	11:50 AM 3/10 W 7" OD 24#: 733,000 "			
Sand		640	705	12:05 PM 11/10 W 7" " : 1,404,000 "			
Slate & Shells		705	845	12:07 PM 16/10 W 7" " : 1,693,000 "			
Black Slate		845	860	12:10 PM 20/10 W 7" " : 1,892,000 "			
Sand		860	940	Depth 4998 - 12:45 PM 40/10 W 2,676,000 "			
Slate		940	1010	1:00 PM 60/10 W 7" 24#: 3,277,000 "			
Sand		1010	1058	1:15 PM 90/10 W 7" " : 4,014,000 "			
Slate & Shells		1058	1270	1:27 PM 106/10 W 7" " : 4,335,000 "			
Salt Sand		1270	1615	Depth 5000' 1:45 PM 130/10 W 7 4,825,000 "			
Break		1615	1618	2: PM 180/10 W 7" 24#: 5,677,000 "			
Maxon Sand		1618	1666	2:12 PM 200/10 W 7" " : 5,984,000 "			
Break		1666	1670	Depth 5002' 2:16 PM tested 180/10 W Tools			
Little Dime		1670	1699	out of hole, resumed drilling at 3:00 PM			
Break		1699	1700	3:30 PM 185/10 W 7" OD casing			
Lime Shell		1700	1712	4:30 PM 150/10 W 7" OD 5,182,000 cf			
Break		1712	1714	12' sand - depth 5204			
Big Lime		1714	1868	64/10 W was taken direct from 7" OD Nipple			
Injun Sand		1868	1913	in master gate. Well shut in 5 PM 7/29/39			
Slate		1913	1930	Well opened July 31, 1939 at 1:05 PM for			
Lime Shell		1930	1960	open flow test -			
Slate & Shells		1960	2321	15 min. after 70/10 W 7" OD 24#			
Berea Shells		2321	2345	30 " " 68/10 " "			
Slate & Shells		2345	3580	45 " " 67/10 W 7" "			
Brown Shale		3580	3640	60 " " 66/10 W " "			
Slate & Shells		3640	3935	75 " " 66/10 W " "			
Brown Shale		3935	4155	Shut in at 2:20 PM			
Slate		4155	4560				
Brown Shale		4560	4780				
Slate		4780	4830				
Coffee Shale		4830	4879				
Corniferous		4879	4992				