


LATITUDE 38°30'

75
0515 map
-135
.845

LONGITUDE 80°35'

81°37'30"

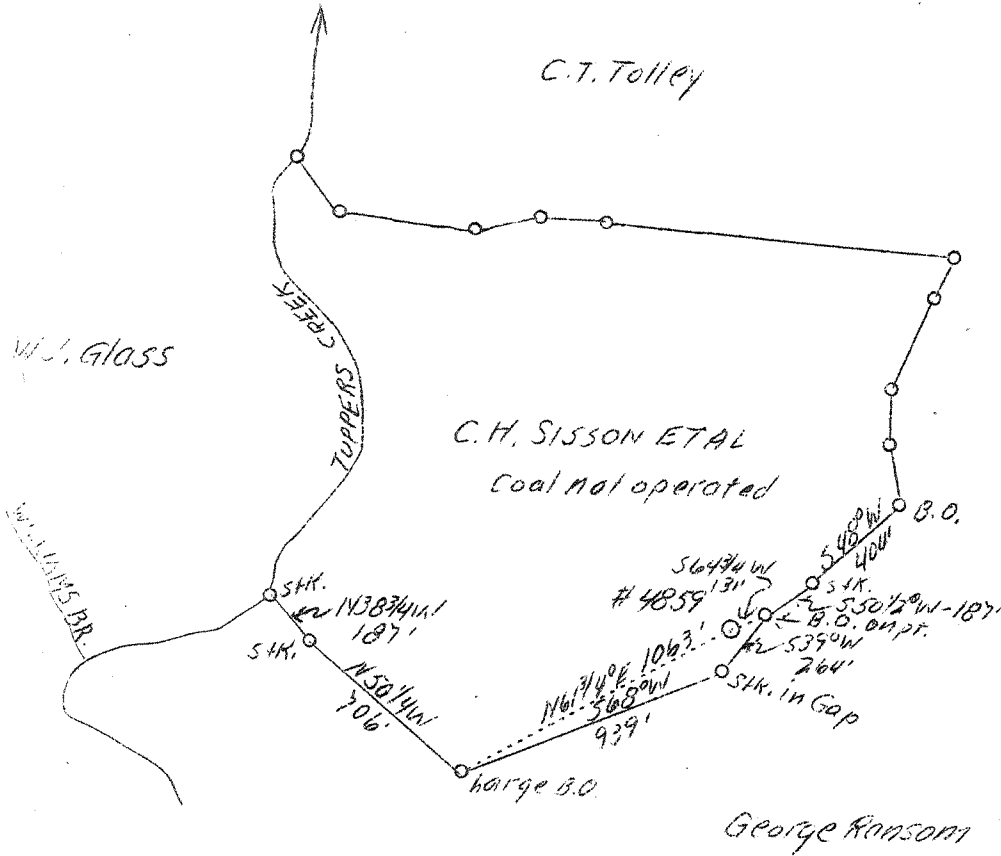

ABD
GLAS

S-0.13
W-3.20

New location

Company	United Fuel Gas Co.
Address	Charleston, W.Va.
Farm	C.H. Sisson, et al
Acres	76
Lease No.	43045
Serial No.	4859
Well (Farm) No.	1
Quadrangle	NC Charleston
County	Kanawha
District	Poca
Eng.	G.A. Cunningham
Eng. Reg. No.	659
File No.	60 - 69
Date	8/7/39
Scale	1" = 660'

STATE OF WEST VIRGINIA
 Department of Mines
 OIL AND GAS DIVISION
 Charleston

WELL LOCATION MAP
 File No. KAN-655

x Denotes location of well on U.S. Topographic Maps, scale 1 to 62,500, latitude and longitude lines being represented by border lines as shown.

- Denotes one inch spaces on border line of original tracing.

6-6-192

WEST VIRGINIA DEPARTMENT OF MINES

OIL & GAS DIVISION

WELL RECORD

Permit No. Kan-655
Charleston Quad.

Gas Well
CASING & TUBING

Company	United Fuel Gas Co.	Wood Cond.	16	16
Address	Charleston, W. Va.	8-5/8	1928	1928
Farm	G. H. Sisson, et al AGRIS 76	7	4930	4930
Location	Turners Creek			
Well No.	4859 ELEV. 937-6			
District	Poca - Kanawha County			
Surface & Mineral	Mary Elizabeth Sisson Agent			
Address	Sissonville, W. Va.			
Commenced	Sept. 11, 1939			
Completed	Dec. 6, 1939			
Shot	Not shot			
Volume	Gas Well 6981 mcf - Vol XVI			
Salt Water	1325			

Formation	Top	Base	Formation	Top	Base
Sand	0	30	Brown Shale	4820	4851
Slate	30	45	Black Slate	4851	4912
Red Rock	45	60	Corniferous Lime	4912	5009
Slate	60	145	Oriskany	5009	5034
Red Rock	145	225	Total Depth	5034	
Slate	225	245			
Sand	245	275			
Slate	275	280			
Red Rock	280	318			
Slate	318	322			
Sand	322	345			
Slate & Shells	345	400			
Red Rock	400	415			
Slate & Shells	415	468			
Sand	468	515			
Slate	515	530			
Sand	530	615			
Slate & Shells	615	715			
Sand	715	745			
Black Slate	745	775			
Sand	775	855			
Black Slate	855	940			
Slate & Shells	940	1010			
Sand	1010	1035			
Slate & Shells	1035	1136			
Salt Sand	1136	1525	HFV 1325		
Black Slate	1525	1562	Settling Sand 1315-1330		
Sand	1562	1575			
Slate & Shells	1575	1594			
Sand	1594	1673			
Slate	1673	1675			
Little Lime	1675	1695			
Slate	1695	1705			
Big Lime	1705	1870			
Injun Sand	1870	1909			
Slate	1909	1925			
Lime Shells	1925	1933			
Slate & Shells	1933	2320			
Berea	2320	2328			
Slate & Shells	2328	3550			
Brown Shale	3550	3595			
Slate & Shells	3595	3825			
Brown Shale	3825	3880			
White Slate	3880	3980			
Brown Shale	3980	4140			
White Slate	4140	4580			
Brown Shale	4580	4600			
White Slate	4600	4820			