


38° 22' 30" P
 Latitude 38 35

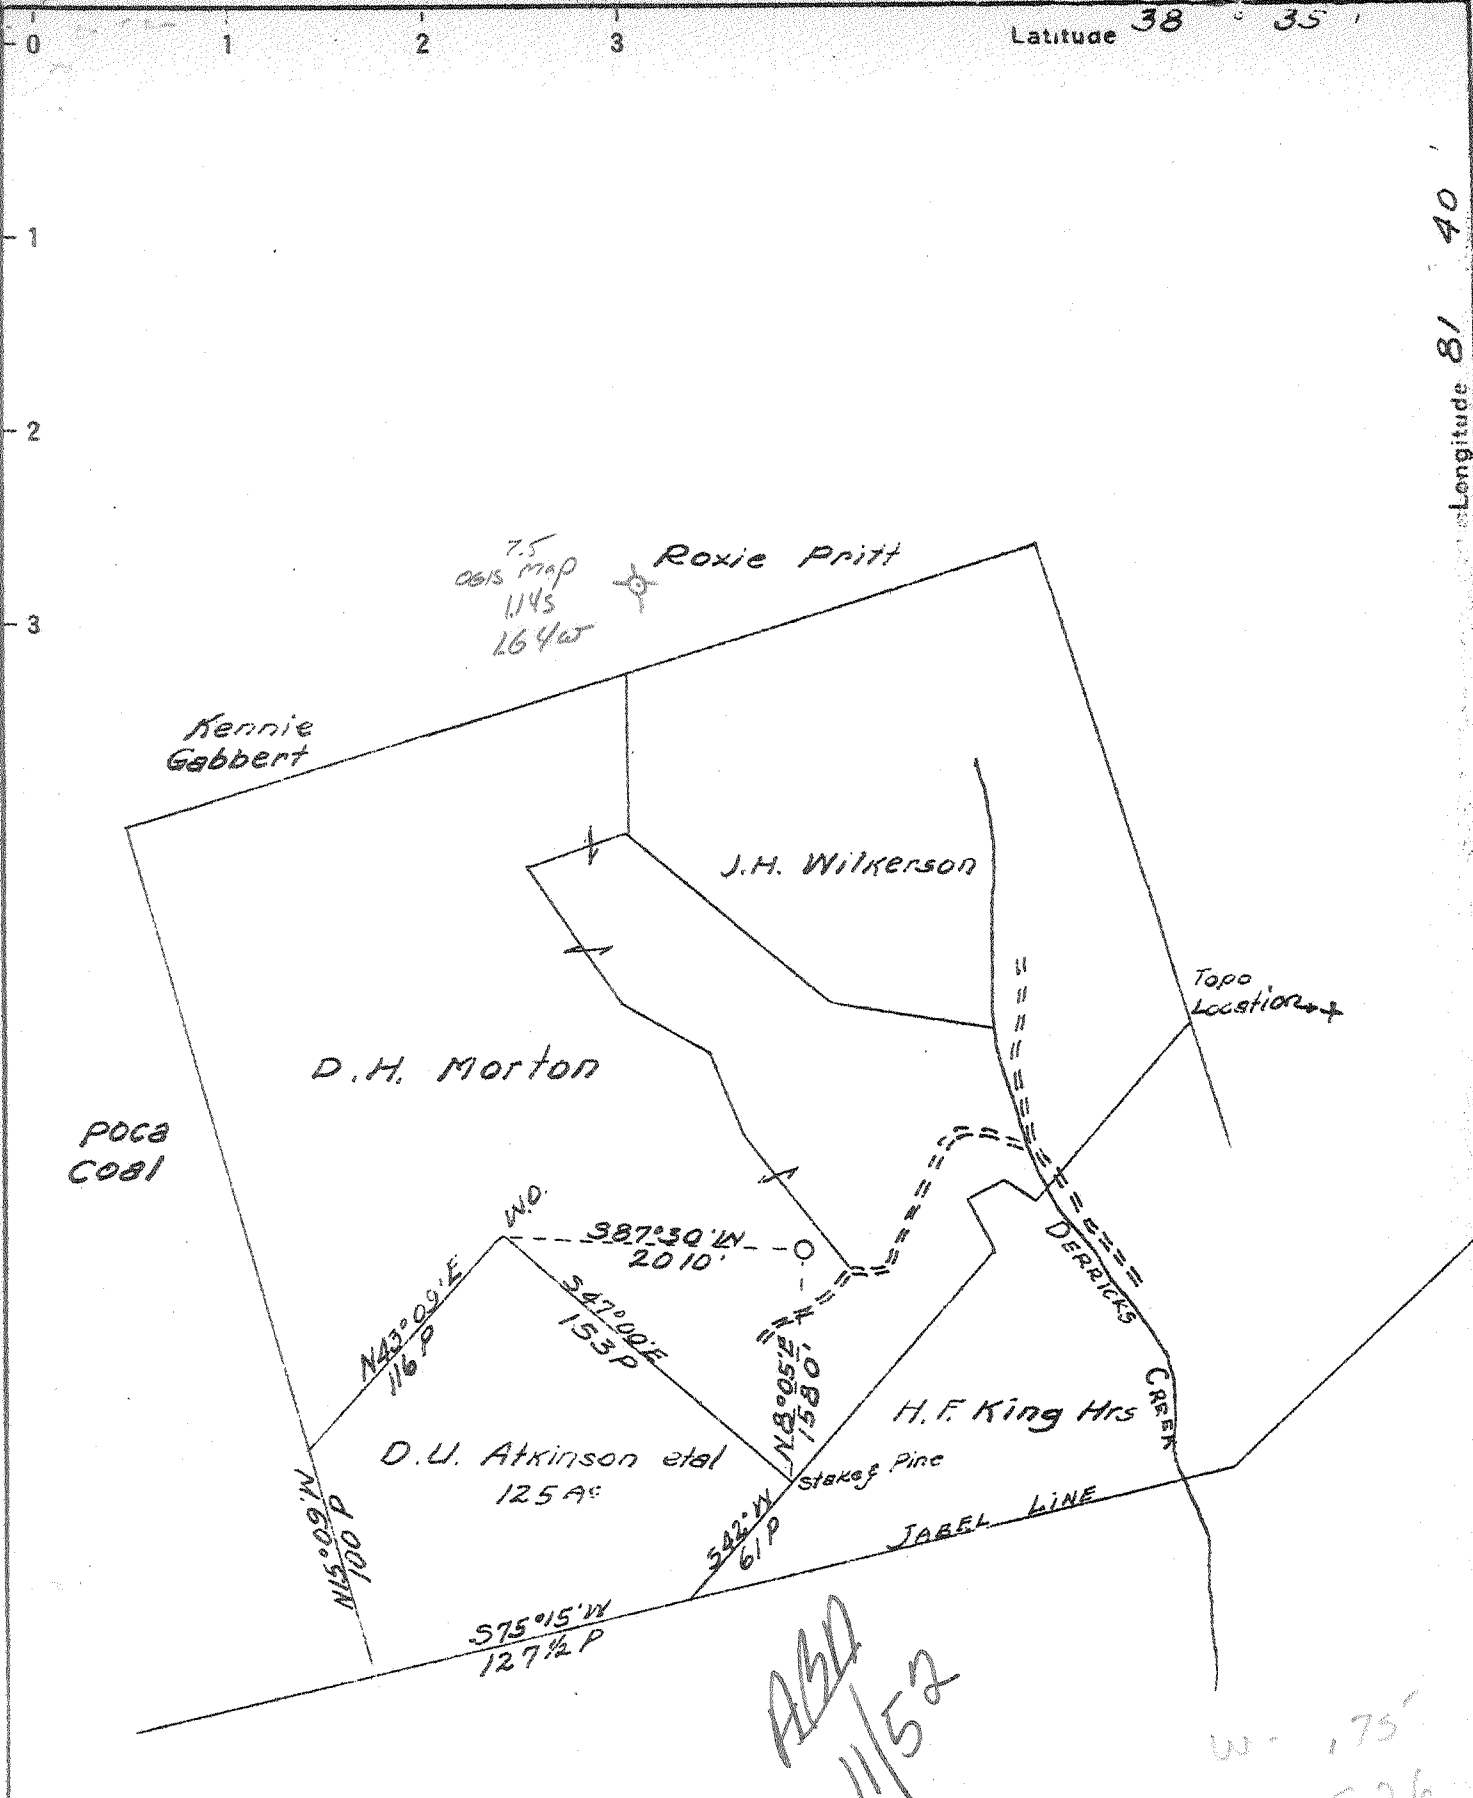

New Location +
 Drill Deeper □
 Abandonment ○

ASD
 11/52

W - .175
 S 5.26

Sheet # 3

Company GOODFREY L. CABOT INC.
 Address 600 UNION BLDG. CHARLESTON WVA.
 Farm D. Holmes Morton
 Tract _____ Acres 521.8 Lease No. 3-467
 Well (Farm) No. 5 Serial No. 961
 Elevation (Spirit Level) 982.7' VOK - 7.5'
 Quadrangle KENNA SW SSaaville
 County KANAWHA District POCA
 Engineer Charles N. Sturm
 Engineer's Registration No. 275
 File No. _____ Drawing No. _____
 Date JULY 29 1940 Scale 1" = 1320'

STATE OF WEST VIRGINIA
 DEPARTMENT OF MINES
 OIL AND GAS DIVISION
 CHARLESTON

WELL LOCATION MAP
 FILE NO. KAN-734

+ Denotes location of well on United States Topographic Maps, scale 1 to 62,500, latitude and longitude lines being represented by border lines as shown.
 - Denotes one inch spaces on border line of original tracing.

Deep Well.

WEST VIRGINIA DEPARTMENT OF MINES
OIL & GAS DIVISION
W E L L R E C O R D

Permit No. Kan-734
Kenna Quad.

Gas Well

		CASING & TUBING	
Company	Godfrey L. Cabot, Inc.,	10-3/4	798
Address	Charleston, W. Va.	8-5/8	2024
Farm	D. Holmes Morton ACRES -	7	4906
Well No.	5 (Serial 961) ELEV. 990	2-3/8	-
District	Poca - Kanawha County 82777 <i>As completed OKH.</i>		
Surface & Mineral	-	882.7-OK-75 ^{top}	B.H. Packer
Commenced	-	<i>KLR 12/4/87</i>	
Completed	Nov. 20, 1940		
Shot	10/20/40 - depth 4994-5009 - 30 qts.		
Volume	852,000 c.f.		
Open Flow	30/10ths Merc. in 2" - 20 min. A.S.		
Rock Pressure	1545 lbs. 24 hrs. - Oriskany		
Water	-		

Surface	0	25	-Lime	1728	1739	
Red Rock	25	50	-Slate	1739	1741	
Sand	50	54	Little Lime	1741	1756	
Red Rock	54	100	Big Lime	1756	1938	Gas 1875
Slate	100	130	-Injun Sand	1938	1964	
Red Rock	130	145	Lime	1964	2050	SL 2024
Slate	145	150	Slate&Shells	2050	2405	
Sand	150	186	-Berca Sand	2405	2445	
Red Rock	186	212	Slate	2445	3620	
Sand	212	216	Brown Shale	3620	3640	
Slate	216	255	Lime	3640	3733	
Sand	255	260	Slate&Shells	3733	4049	
Slate	260	275	Brown Shale	4049	4190	
Red Rock	275	285	White Slate	4190	4620	
Slate	285	290	Brown Shale	4620	4815	
Red Rock	290	325	Gray Shale	4815	4831	
Sand	325	396	-Black Shale	4831	4885	
Red Rock	396	417	-Corniferous	4885	4986	
Slate	417	457	Oriskany Sand	4986	5020	
Red Rock	457	470	Oriskany Lime	5020	5041	
Sand	470	508	Oriskany Sand	5041	5054	
Slate	508	540	-Hilderberg Lime	5054	5062	
Red Rock	540	556	Total Depth		5062	
Slate	556	572				
Red Rock	572	590				
Slate	590	620				
Sand	620	658				
Slate	658	685				
Red Rock	685	695				
Sand	695	700				
Slate	700	713				
Sand	713	748				
Slate	748	788				
Sand	788	804				
Lime	804	810				
Slate	810	879				
Sand	879	899				
Slate	899	916				
Sand	916	1010				
Slate	1010	1050				
Sand	1050	1110				
Slate	1110	1167				
Sand	1167	1187				
Slate	1187	1242				
Black Lime	1242	1269				
Sand	1269	1305				
Slate	1305	1336				
Sand	1336	1352				
Slate Brake	1352	1354				
-Salt Sand	1354	1634				
-Maxon	1634	1728				

GAUGES IN ORISKANY SAND

5001	249M
5005	400M
5008	179M
5021	184M
5025	179M
5046	146M
5052	119M
5057	112M
5062	94M
Test before shot	103M
" 20 min.A.S.	852M

1728 S.W.1455 Hole filled up 600' of top