


38° 32' 30"

Latitude 38° 35'

Longitude 81° 40'

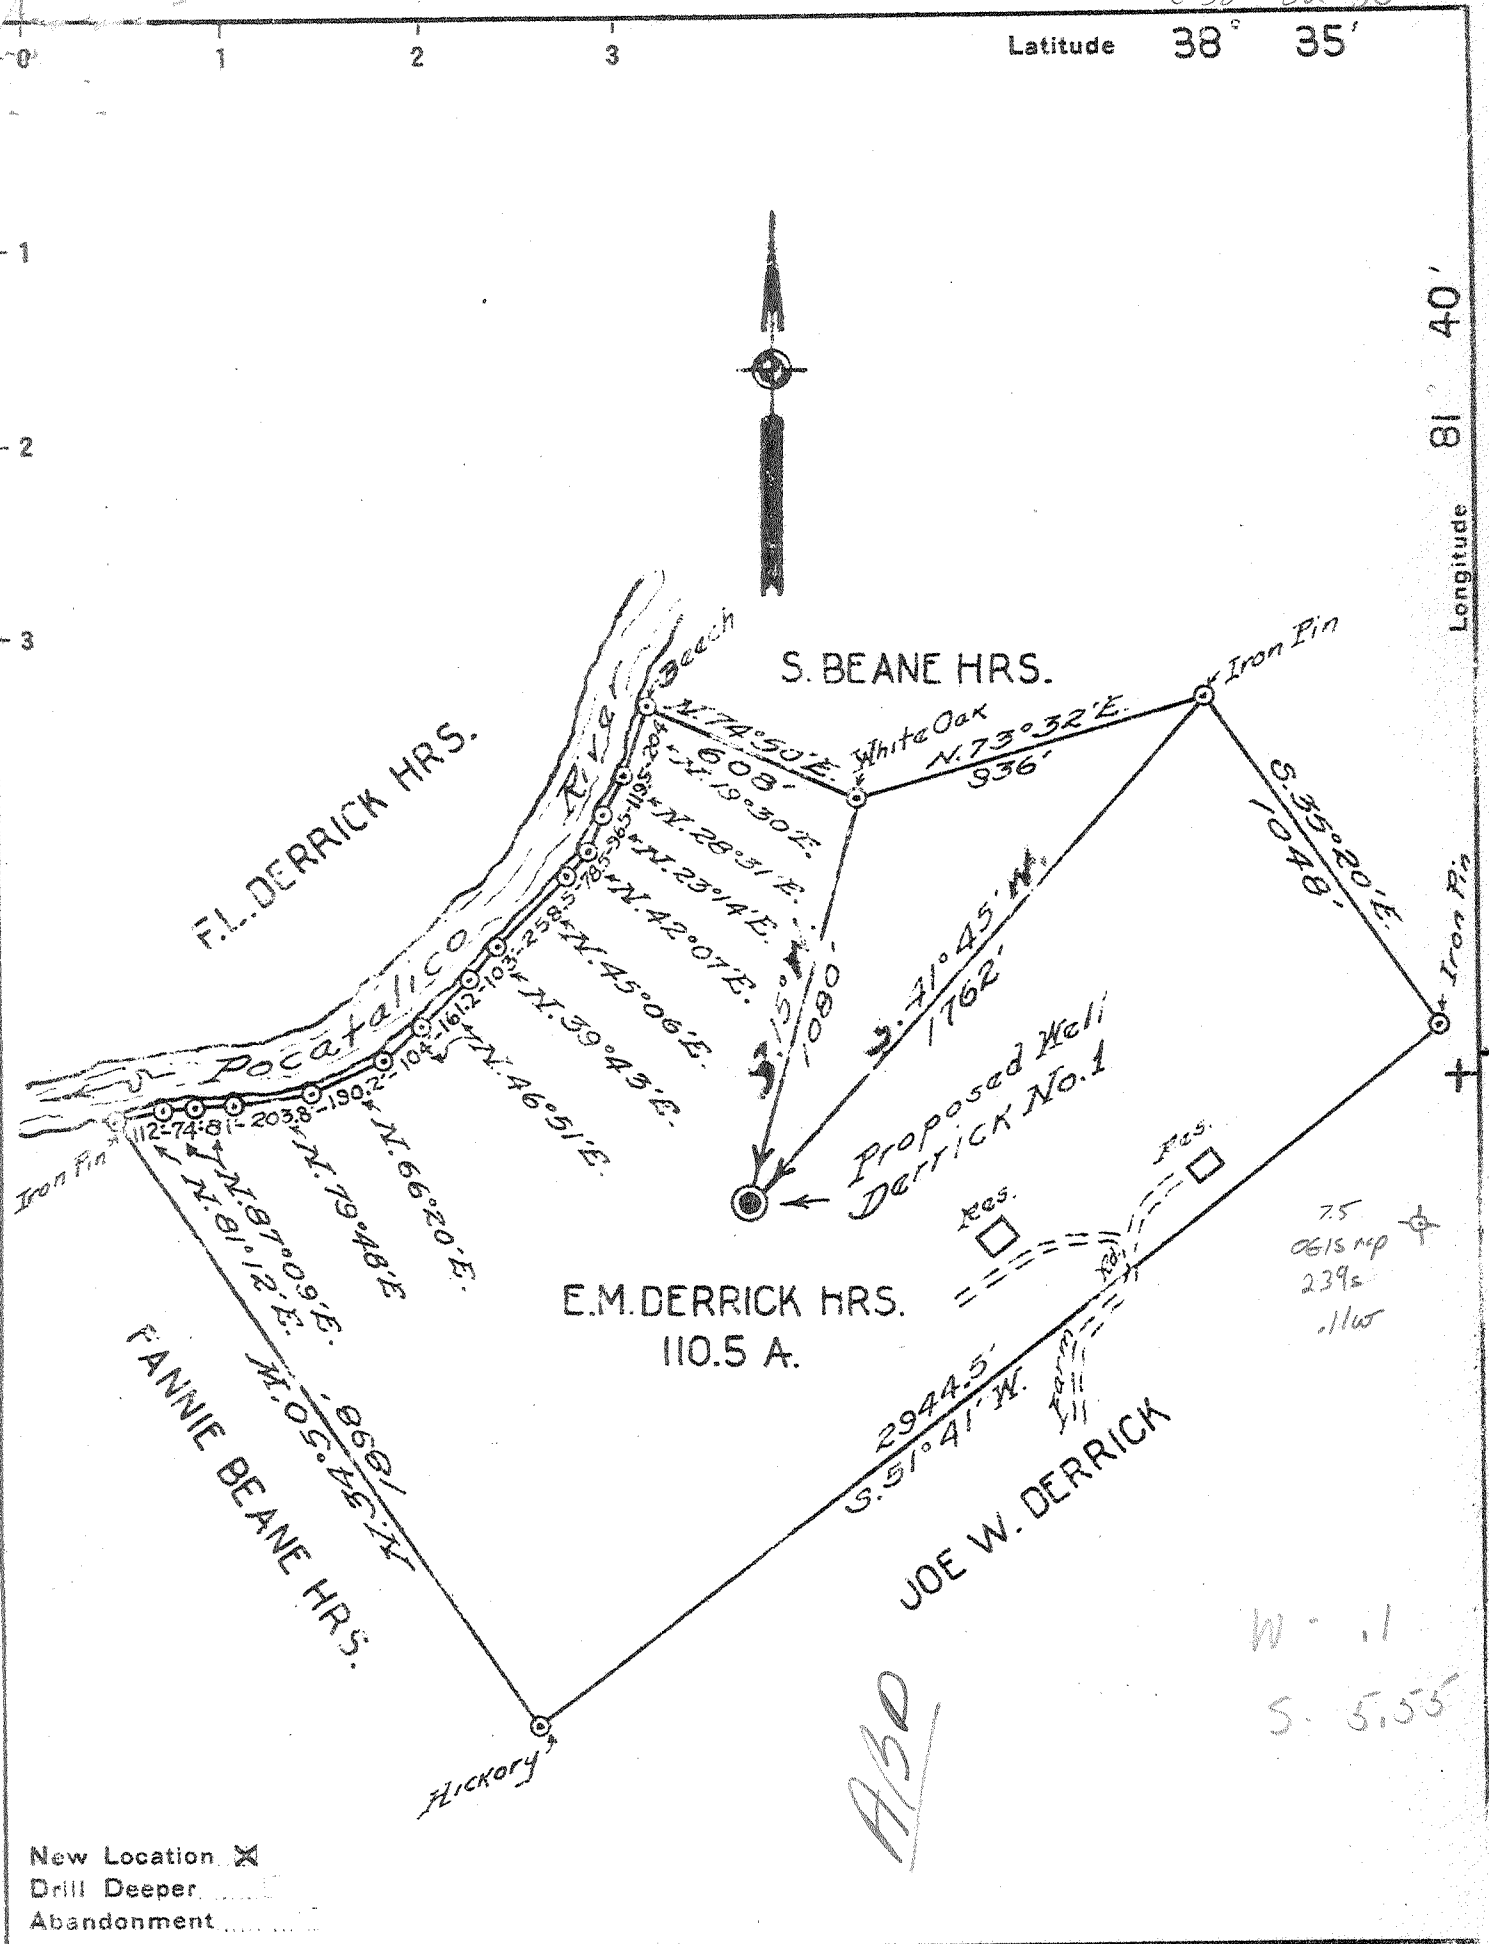

- New Location
- Drill Deeper
- Abandonment

Company JOE RUBIN
 Address 1900 19TH. ST. PARKERSBURG, W.VA.
 Farm E.M. DERRICK HRS.
 Tract 5 Acres 110.5 Lease No. _____
 Well (Farm) No. 1 Serial No. _____
 Elevation (Spirit Level) 855'
 Quadrangle KENNA Sissonville
 County KANAWHA District POCA
 Engineer J.E. ANDERSON
 Engineer's Registration No. _____
 File No. _____ Drawing No. _____
 Date SEPT. 29 1940 Scale 1" = 500'

STATE OF WEST VIRGINIA
 DEPARTMENT OF MINES
 OIL AND GAS DIVISION
 CHARLESTON

WELL LOCATION MAP
 FILE NO. KAN-753

- + Denotes location of well on United States Topographic Maps, scale 1 to 62,500, latitude and longitude lines being represented by border lines as shown.
- Denotes one inch spaces on border line of original tracing.

WEST VIRGINIA DEPARTMENT OF MINES
OIL & GAS DIVISION
W E L L R E C O R D

Permit No. Kan-753
Konna Quad.

Gas Well

Company Joe Rubin
Address 1900-19th St., Parkersburg, W. Va.
Farm E. M. Derrick Hrs. ACRES 110.5
Well No. 1 #ELEV. 855
District Poca - Kanawha County
Surface & Mineral J. W. Derrick, Charleston, W. Va.
Commenced Oct. 28, 1940
Completed Feb. 26, 1941
Shot - Vol XVI
Gas - 2463 Mcf - Vol XVI
Oil -
Rock Pressure -
Water -

CASING & TUBING

16	16	16
12	392	
10	958	
8-1/4	1736	
6-5/8	1976	1976
5-3/16	4917	4917
2	5068	

Red Clay	0	3	-Little Lime	1722	1745
Slate - brown	3	20	-Slate	1745	1747
Sandy Lime	20	24	-Big Lime	1747	1894
Red Rock	24	54	Slate	1894	1965
Slate - blue	54	130	Lime - black	1965	1984
Red Rock	130	164	Slate	1984	2040
Slate	164	310	Lime	2040	2050
Sand	310	330	Slate	2050	2060
Slate - blue	330	360	Lime	2060	2070
Lime - brown	360	360	Slate	2070	2085
Red Rock	380	395	Lime	2085	2095
Lime	395	440	Shale - blue	2095	2360
Blue Slate	440	455	*Coffee Shale	2360	2370
Sandy Lime	455	485	*Berea Sand	2370	2376
Blue Slate	485	495	Lime - black	2376	2390
Sandy Lime	495	533	Slate & Shells	2390	3875
Slate - black	533	540	Shale - brown	3875	4180
Slate - blue	540	575	Slate	4180	4574
Red Rock	575	585	Shale - brown	4574	4850
Slate - blue	585	610	-Shale - black	4850	4897
Lime	610	620	Lime	4897	5002
Sand	620	670	*Oriskany	5002	5032
Slate & Shells	670	750	Total Depth		5632
Lime	750	760			
Sand	760	822			
Slate - black	822	830			
Lime	830	845			
Sand	845	875			
Slate - black	875	895			
Sandy Shale	895	905			
Slate - black	905	915			
Slate - blue	915	965			
Sand	965	988			
Slate - blue	988	1075			
Sand	1075	1120			
Shale - blue	1120	1140			
Lime	1140	1165			
Sand	1165	1260			
Sandy Shale	1260	1275			
Lime	1275	1280			
*Salt Sand	1280	1665	HFV 1347		
Shale - blue	1665	1702			
-Little Lime	1702	1720			
Pencil Cavo	1720	1722			