


P

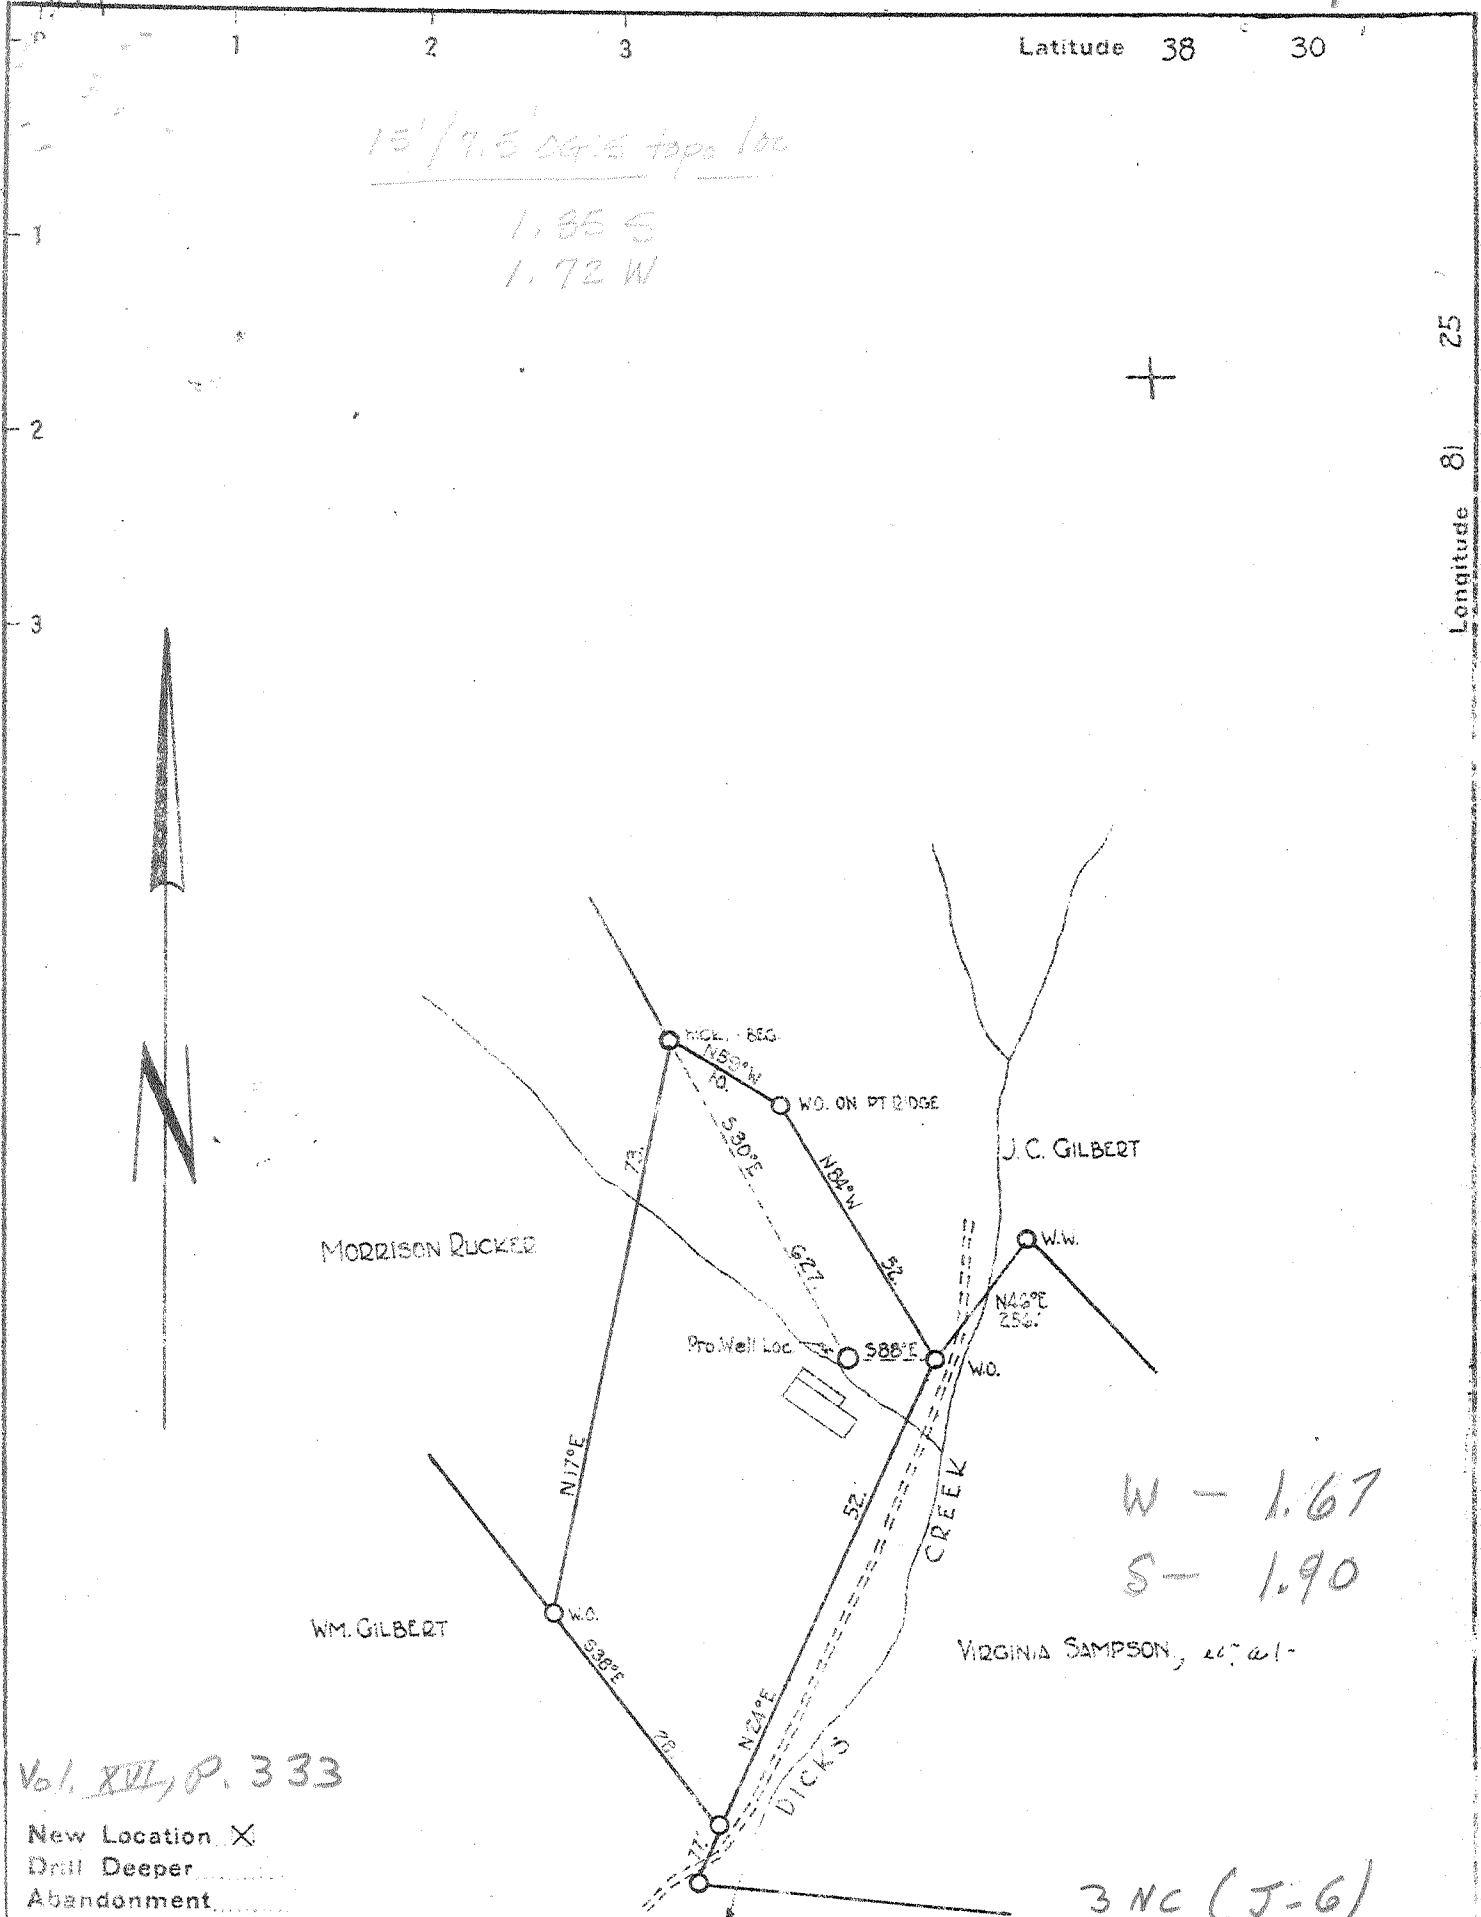

Vol. XVI, P. 333

New Location X
 Drill Deeper
 Abandonment

Company	J. E. HAFFER
Address	ELKVIEW, W. VA.
Farm	VIRGINIA SAMPSON
Tract	Acres 10 Lease No.
Well (Farm) No.	ONE Serial No.
Elevation (Spirit Level)	730
Quadrangle	CLENDENIN - NW
County	KANAWHA District ELK
Engineer	A. E. PRICE
Engineer's Registration No.	819
File No.	Drawing No.
Date	10/4/40 Scale 1" = 200'

STATE OF WEST VIRGINIA
 DEPARTMENT OF MINES
 OIL AND GAS DIVISION
 CHARLESTON

WELL LOCATION MAP
 FILE NO. **KAM-754**

+ Denotes location of well on United States Topographic Maps, scale 1 to 62,500, latitude and longitude lines being represented by border lines as shown.

- Denotes one inch spaces on border line of original tracing.

3-0 217

Deep Well

WEST VIRGINIA DEPARTMENT OF MINES
OIL & GAS DIVISION
WELL RECORD

Permit No. Kan-754

Company	J.E. Hooper	<u>Dry Hole</u>	
Address	Elkview, W.Va.	Casing & Tubing	
Farm	Virginia Sampson Acres 25	13	22
Location	Riley Branch	8 1/2	418' 8"
Well No	1 Elev. 730	6 5/8	1760
District	Elk Kanawha County	5 3/16	5090'
Surface	Virginia Sampson, Blue Creek, W.Va.		
Mineral	Same	Casing Cemented:	
Commenced	Oct. 10, 1940	5 3/16	40' -- 3 -- 22 -- 41
Completed	Sept. 9, 1941		
Fresh Water	75'	Coal at 360' -- 366'	
Salt Water	1055' -- 5204'	" 400' 404' 6' 4'	

Surface		5	5	.Maxon Sand	Gr	1460	1490
Rock	Red	5	20	Slate	Bl	1490	1530
Sand	Quick	20	23	.L.Lime	Gr	1530	1555
Rock	Red	23	30	.Pencil Cave	Bk	1555	1560
Slate	Bl	30	50	.Dig Limo	Wh	1560	1700
Sand	Wh	50	110	.Dig Injun	Gr	1700	1750
Slate	Bl	110	300	Slate & Shells	Bl	1750	1910
Sand	Wh	300	360	.Squaw Sand	Gr	1910	1914
Coal	Bk	360	366	Slate & Lime	Bl	1914	3370
Slate	Bl	366	376	Brown Shale	Dr	3370	3390
Sand	Wh	376	400	Slate Shells	Bl	3390	3885
Coal	Bk	400	404	Shale & Shells	Bk	3885	4025
Sand	Wh	404	490	Slate	Wh	4025	4640
Slate	Bl	490	505	Shale	Dr	4640	4850
Lime	Bk	505	520	Shale	Bk	4850	4890
Slate & Sand	Mixed	520	575	Shale	Dr	4890	4940
Sand	Wh	575	655	Shale	Bk	4940	4970
Slate	Bl	655	810	Slate	Wh	4970	5008
Sand	Wh	810	850	Shale	Dr	5008	5053
Slate	Bl	850	870	.Shale	Bk	5053	5082
Sand	Wh	870	890	.Corniferous Limo	Gr	5082	5198
Slate	Bl	890	910	.Oriskany Sand	Gr	5198	5218
Lime	Bk	910	923				
Slate	Bl	923	933	Show Oil, Gas, and Water		1715'	
Lime	Bk	933	968	Show Oil & Gas		1912'	
Slate	Bl	968	1030	Water 5205 -- Filled up 2500'			
. Salt Sand	Gr	1030	1390	W. 1055 H.F.			
Slate	Bl	1390	1396				
Lime	Bk	1396	1407				
Rock	Red	1407	1425				
Lime	Bk	1425	1445				
Slate	Bl	1445	1460				