


1 2 3

Latitude 38° 30'

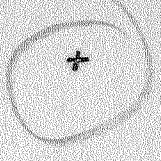


Longitude 81° 40'

1

2

3

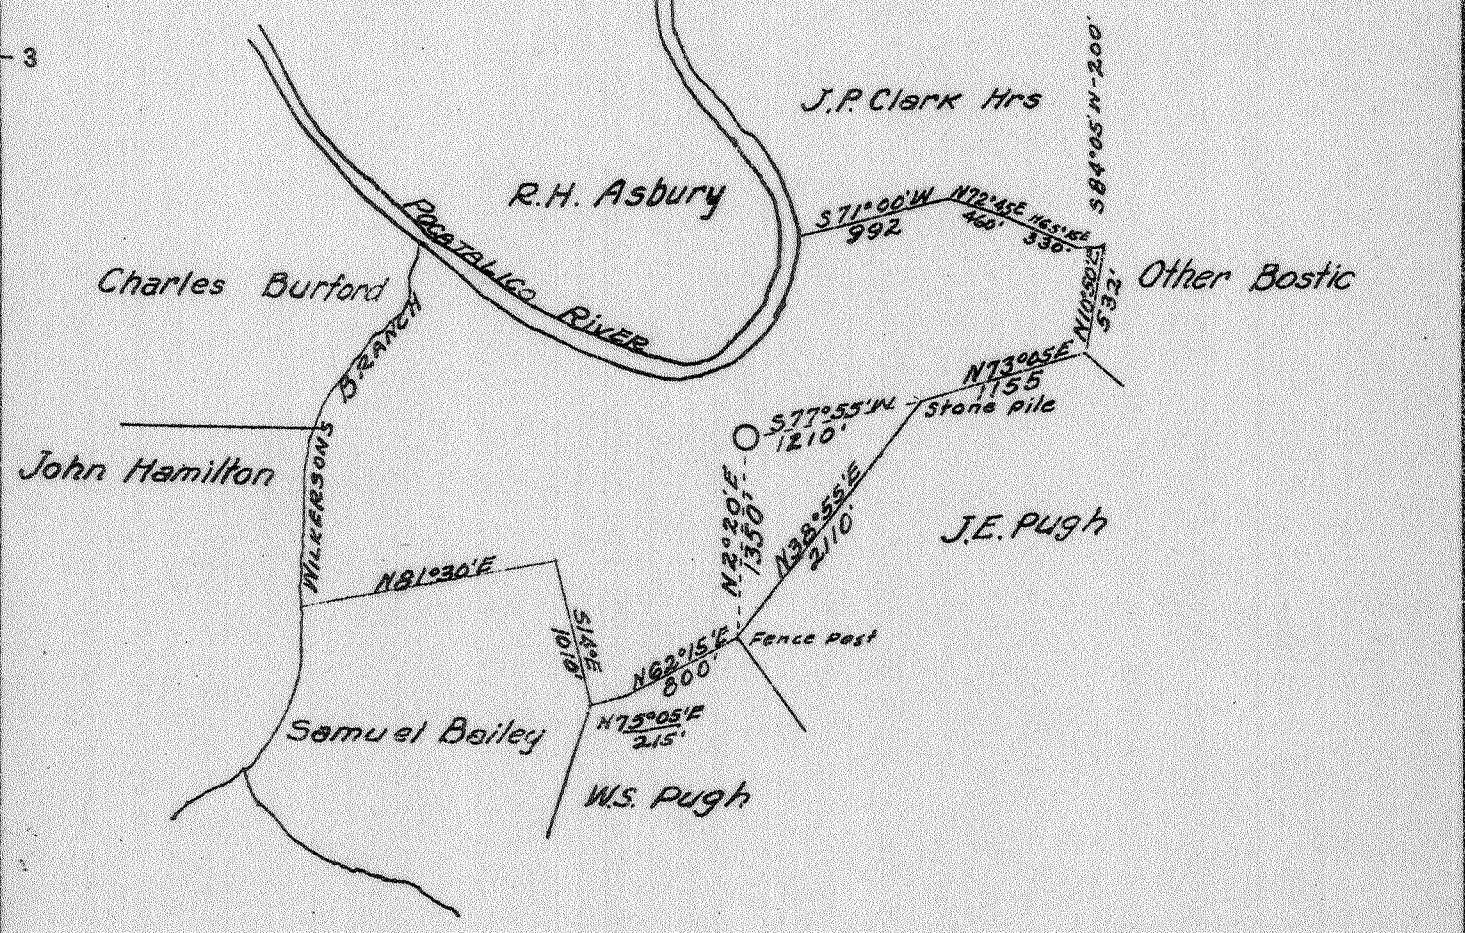

W-.95
S-.6

- New Location
- Drill Deeper
- Abandonment

Company	<u>GODFREY L. CABOT INC.</u>
Address	<u>600 Union Bldg Charleston W. Va.</u>
Farm	<u>Edna V Bailey</u>
Tract	Acres <u>22.24</u> Lease No. <u>3-518</u>
Well (Farm) No.	<u>1</u> Serial No. <u>970</u>
Elevation (Spirit Level)	
Quadrangle	<u>Charleston N.W.</u>
County	<u>Kanawha</u> District <u>Union</u>
Engineer	
Engineer's Registration No.	<u>975</u>
File No.	Drawing No.
Date	<u>March 27 1941</u> Scale <u>1" = 1320'</u>

STATE OF WEST VIRGINIA
 DEPARTMENT OF MINES
 OIL AND GAS DIVISION
 CHARLESTON

WELL LOCATION MAP
 FILE NO. KAN-801

- + Denotes location of well on United States Topographic Maps, scale 1 to 62,500, latitude and longitude lines being represented by border lines as shown.
- Denotes one inch spaces on border line of original tracing.

6-6-192 deep well

WEST VIRGINIA DEPARTMENT OF MINES
OIL & GAS DIVISION
W E L L R E C O R D

Permit No. Kan-801
Charleston NW. Quad.

Gas Well

Company Godfrey L. Cabot, Inc.
Address Charleston, W. Va.
Farm Edna V. Bailey
Well No. 1 Serial No. 970 Elev. 859
District Union Kanawha County
Commenced April 17, 1941
Completed July 25, 1941
Shot July 25, 1941 Depth 4908 to 4915
4920 to 4927
Flow 35 Min after shot
Volume 298M. Big Lime; 2834 M. Oriskany

Casing & Tubing
1 3/8 653 653
10 1/2 1669 1669
8-5/8 1912 1912
7 4882 4882
2-3/8 5000 4967
Tubed & shut in 7-30-41
Perf. top 4924
Perf. bot. 4930
Perf. top 4961
Perf. bot. 4967

Sand	0	35
Blue Shale	35	45
Sand	45	50
Blue Slate	50	55
Lime	55	85
Blue Shale	85	90
Sand	90	110
Red Rock	110	130
Lime	130	180
Red Rock	180	200
Lime	200	265
Red Rock	265	270
Lime	270	315
Sand	315	370
Lime	370	421
Red Rock	421	445
Sand	445	510
Slate & Shell	510	540
Lime	540	591
Slate	591	700
Sand	700	810
Slate	810	970
Lime	970	980
Shale	980	1036
Slate & Shell	1036	1096
Sand	1096	1150
Slate & Shell	1150	1200
Salt Sand	1200	1566
Slate	1566	1575
Black Lime	1575	1636
Little Lime	1636	1647
Pencil Cave	1647	1649
Big Lime	1649	1830
Slate	1830	1835
Injun Sand	1835	1890
Black Lime	1890	1930
Slate	1930	1997
Lime	1997	2027
Slate & Shells	2027	2272
Brown Shale	2272	2282
Lime Shell	2282	2290
Berea Grit	2290	2300
Lime	2300	2350
Slate & Shells	2350	3487
Brown Shale	3487	3547
Slate & Shells	3547	3910
Brown Shale	3910	4145
White Slate	4145	4445
Shale	4445	4810
Corniferous Lime	4810	4906
Oriskany Sand	4906	4949
Black Lime	4949	4960
Corniferous Lime	4960	4965
Oriskany Sand	4965	4976
Lime - A	4976	4979

GAUGES IN ORISKANY BEFORE SHOT

7-21	4908	4912	158M
7-21	4915		112M
7-21	4917		112M
7-21	4919		112M
7-21	4921		127M
7-21	4922		446M
7-21	4923		600M
7-21	4924		736M
7-21	4925		848M
7-21	4926		900M
7-22	4927		942M
7-22	4928		900M
7-22	4935		703M
7-23	4942		537M
7-23	4942		445M
7-24	4953		424M
7-24	4959		424M
7-24	4967		424M
7-24	4975		424M

GAUGES IN ORISKANY AFTER SHOT

7-25-41 Gauge before shot 424M
35 Min. After shot 2834M

Homewood?

1566S 1225'
18PM

203M Show of Oil at 1865