


4 M

38° 27' 30" P

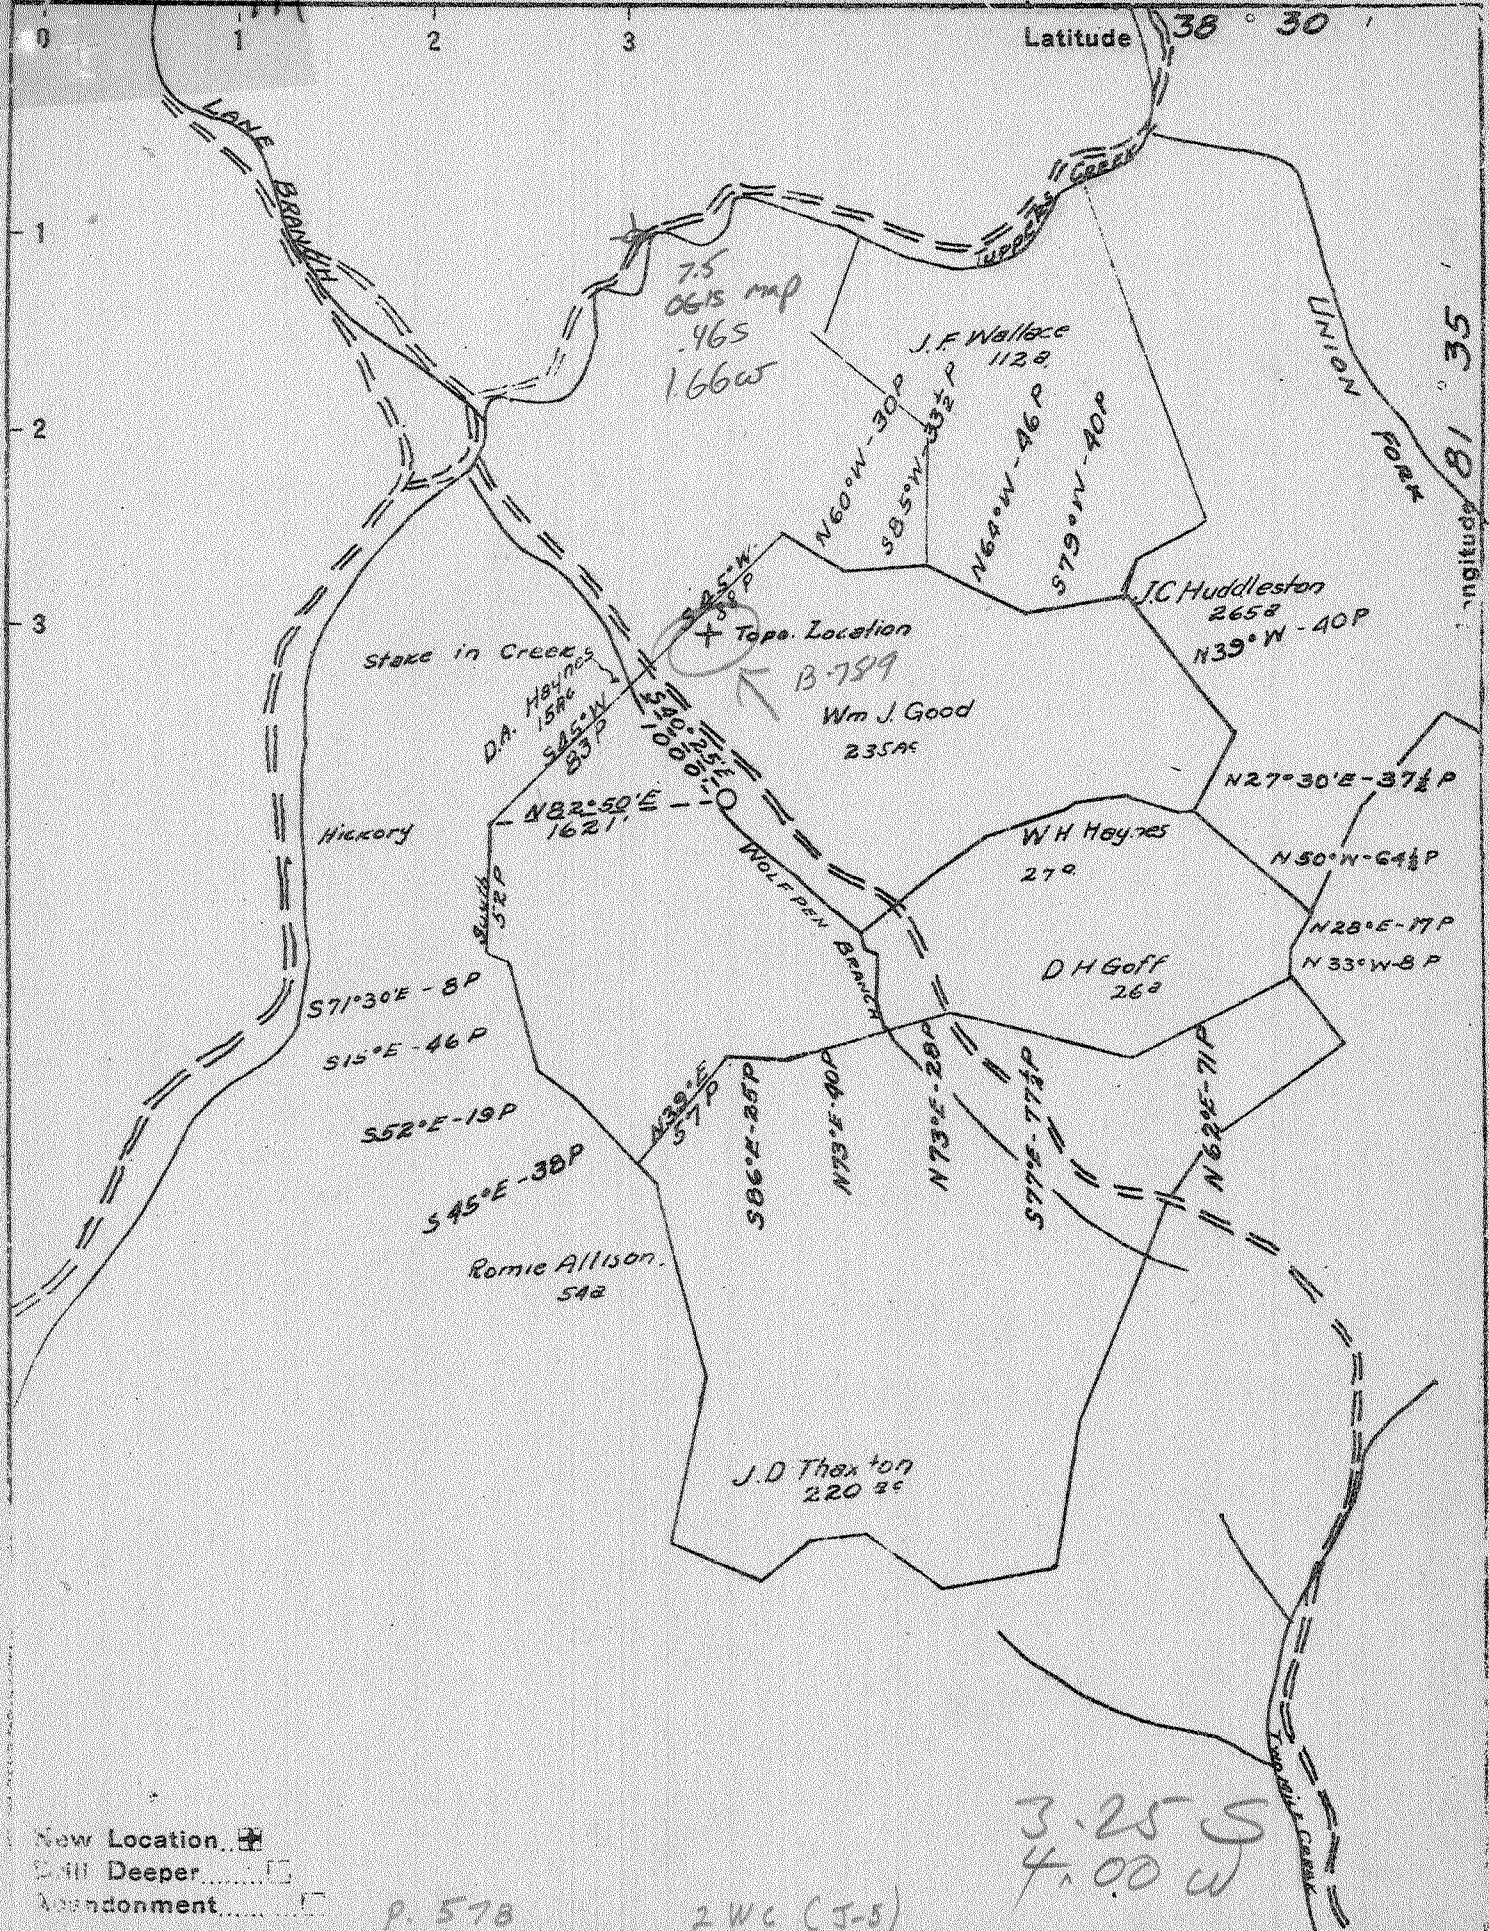

P. 578 2 WC (T-5)

3.25 S
 4.00 W

Company GODFREY L. CABOT INC.
 Address 900 UNION BLDG. CHARLESTON W.V.
 Farm Wm. J. Good et al.
 Tract _____ Acres 235 Lease No. 3-526
 Well (Farm) No. 1 Serial No. 1037
 Elevation (Spirit Level) 711.13
 Quadrangle Charleston
 County Kanawha District Union
 Engineer Roy Boston
 Engineer's Registration No. _____
 File No. _____ Drawing No. _____
 Date 3-13-42 Scale 1" = 1320'

STATE OF WEST VIRGINIA
 DEPARTMENT OF MINES
 OIL AND GAS DIVISION
 CHARLESTON

WELL LOCATION MAP
 FILE NO. KAN-926

+ Denotes location of well on United States Topographic Maps, scale 1 to 62,500, latitude and longitude lines being represented by border lines as shown.
 - Denotes one inch spaces on border line of original tracing.

6-6192 Deep

WEST VIRGINIA DEPARTMENT OF MINES
OIL & GAS DIVISION
WELL RECORD

Dry Hole
CASING & TUBING

Permit No. Kan 926
Charleston Quad.

Company Godfrey L. Cabot, Inc.
Address Charleston, W.Va.
Farm W.J. Good Acres --
Location --
Well No. 1 Ser. 1037 Elev. 711' 13'
District Union Kanawha County
Surface --
Mineral --
Commenced 4-9-42
Completed 6-29-42
Not shot
Volume Dry Hole
Fresh Water 176 H.F.
Salt Water 4850'

16 43
10 520 Shoe
8 1781 Packer
7 4767 Spec.
Oriskany Packer

Gravel	0	48
Grey Sand	48	68
Red Rock	68	108
Grey Slate	108	128
Red Rock	128	210
Slate	210	340
Sand	340	400
Grey Slate	400	442
Sand	442	465
Slate	465	500
Sand	500	530
Slate	530	545
Sand	545	565
Slate & Shells	565	615
Coal	615	627 <i>stockton?</i>
Sand	627	660
Sand	660	704
Slate & Shells	704	795
Sand	795	810
Slate	810	889
Sand	889	920
Slate	920	940
Sand	940	995
Slate	995	1010
Salt Sand	1010	1477
Slate	1477	1489
Sand	1489	1507
Slate Break	1507	1510
Big Lime - 1 1/2' zone	1510	1540
Red Rock	1540	1548
Injun Sand	1720	1763
Slate	1763	1778
Lime Shell	1778	1795
Slate & Shells	1795	3423
Black Shale	3423	3540
White Slate & Shells	3540	3715
Brown Shale	3715	3750
White Slate	3750	3765
Brown Shale	3765	3815
Slate & Shells	3815	3830
Brown Shale	3830	3980
White Slate	3980	4450
Brown Shale	4450	4673
White Slate	4673	4698
Black Shale	4698	4749
Corniferous Lime	4749	4847
Oriskany Sand	4847	4886
Lime	4886	4890
Sand	4890	4900
Lime	4900	4902
Sand	4902	4911
Lime	4911	4942
TOTAL DEPTH		4942

Show O & G 1726

Gas 3910 not enough to gauge.