


BLACK BAND COAL #5252 LOCATION MAP

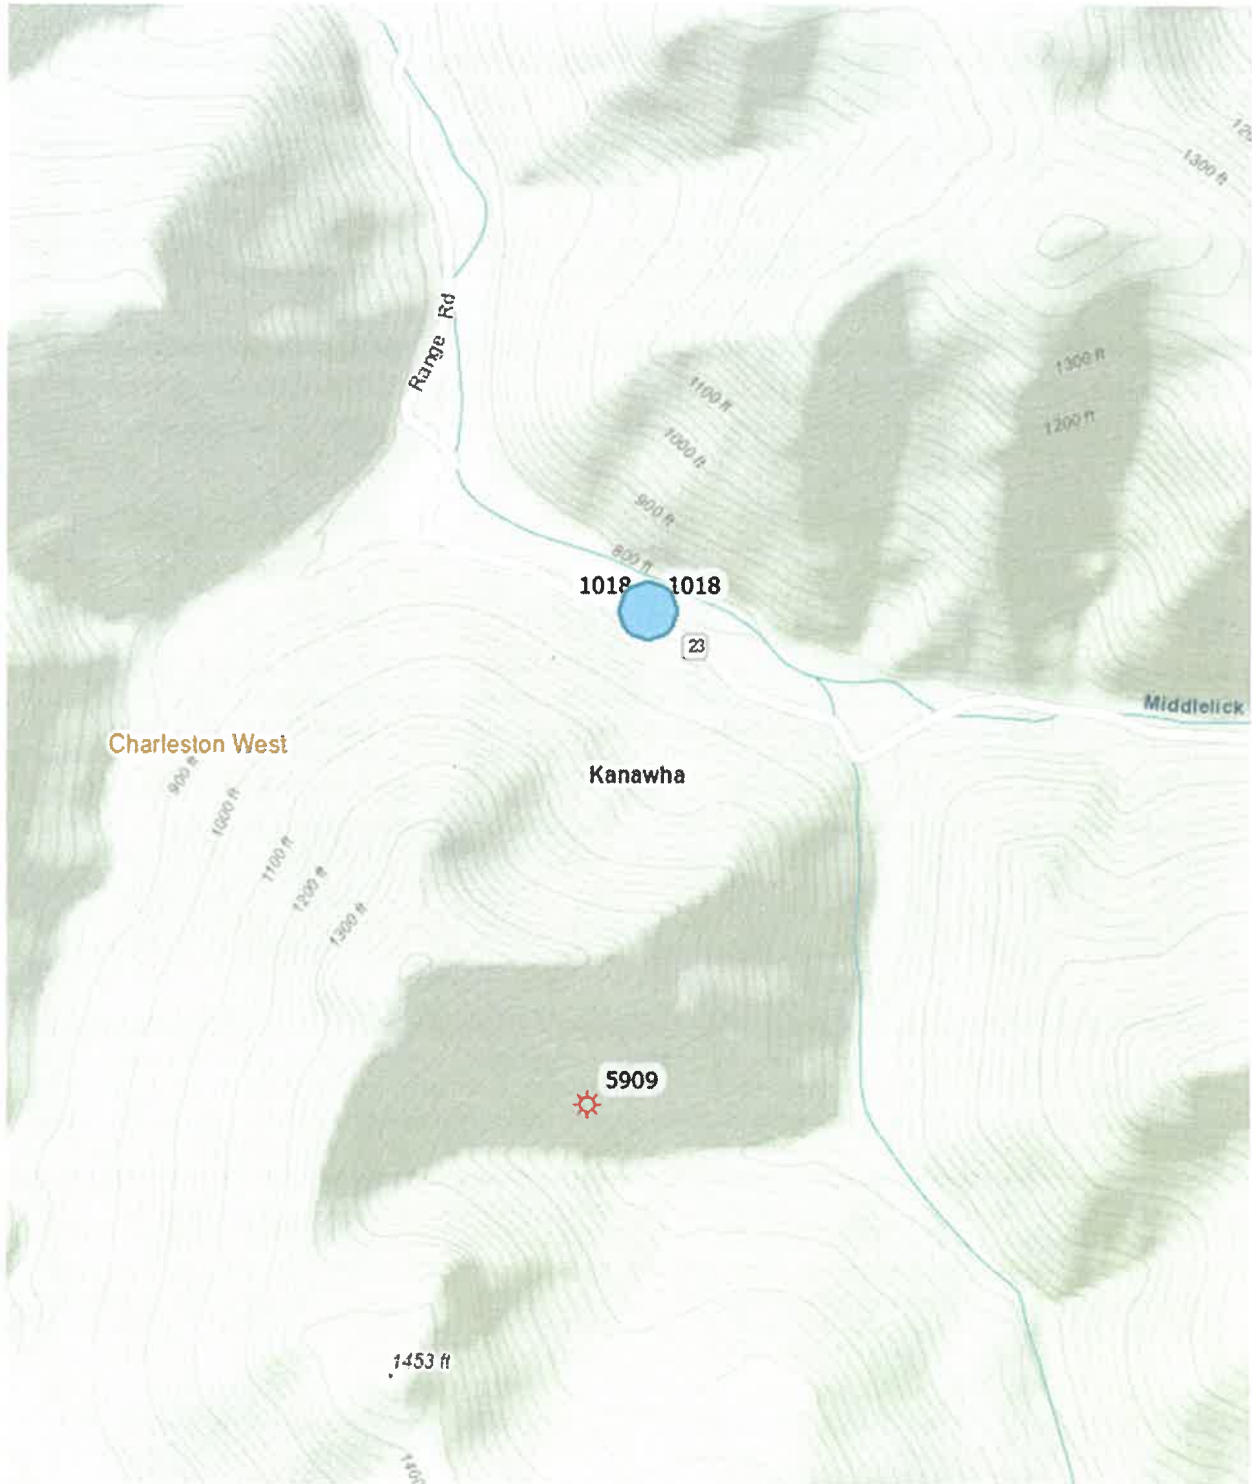

4703901018P

WW-7
8-30-06



West Virginia Department of Environmental Protection
Office of Oil and Gas

WELL LOCATION FORM: GPS

API: 47-039-01018 WELL NO.: BBC #5252

FARM NAME: Kanawha State Forest

RESPONSIBLE PARTY NAME: Pillar Energy LLC

COUNTY: Kanawha DISTRICT: Loudon

QUADRANGLE: Charleston West C6

SURFACE OWNER: Kanawha State Forest

ROYALTY OWNER: Hardy Oil & Gas LLC, PFR WV Holdings LLC

UTM GPS NORTHING: 4234706.60

UTM GPS EASTING: 444463.70 GPS ELEVATION: 800'

The Responsible Party named above has chosen to submit GPS coordinates in lieu of preparing a new well location plat for a plugging permit or assigned API number on the above well. The Office of Oil and Gas will not accept GPS coordinates that do not meet the following requirements:

1. Datum: NAD 1983, Zone: 17 North, Coordinate Units: meters, Altitude: height above mean sea level (MSL) – meters.
2. Accuracy to Datum – 3.05 meters
3. Data Collection Method:

Survey grade GPS ____: Post Processed Differential ____

Real-Time Differential ____

Mapping Grade GPS ____: Post Processed Differential ____

Real-Time Differential ____

4. Letter size copy of the topography map showing the well location.

I the undersigned, hereby certify this data is correct to the best of my knowledge and belief and shows all the information required by law and the regulations issued and prescribed by the Office of Oil and Gas.


Signature

CEO
Title

3-23-26
Date

05/29/2026