


P

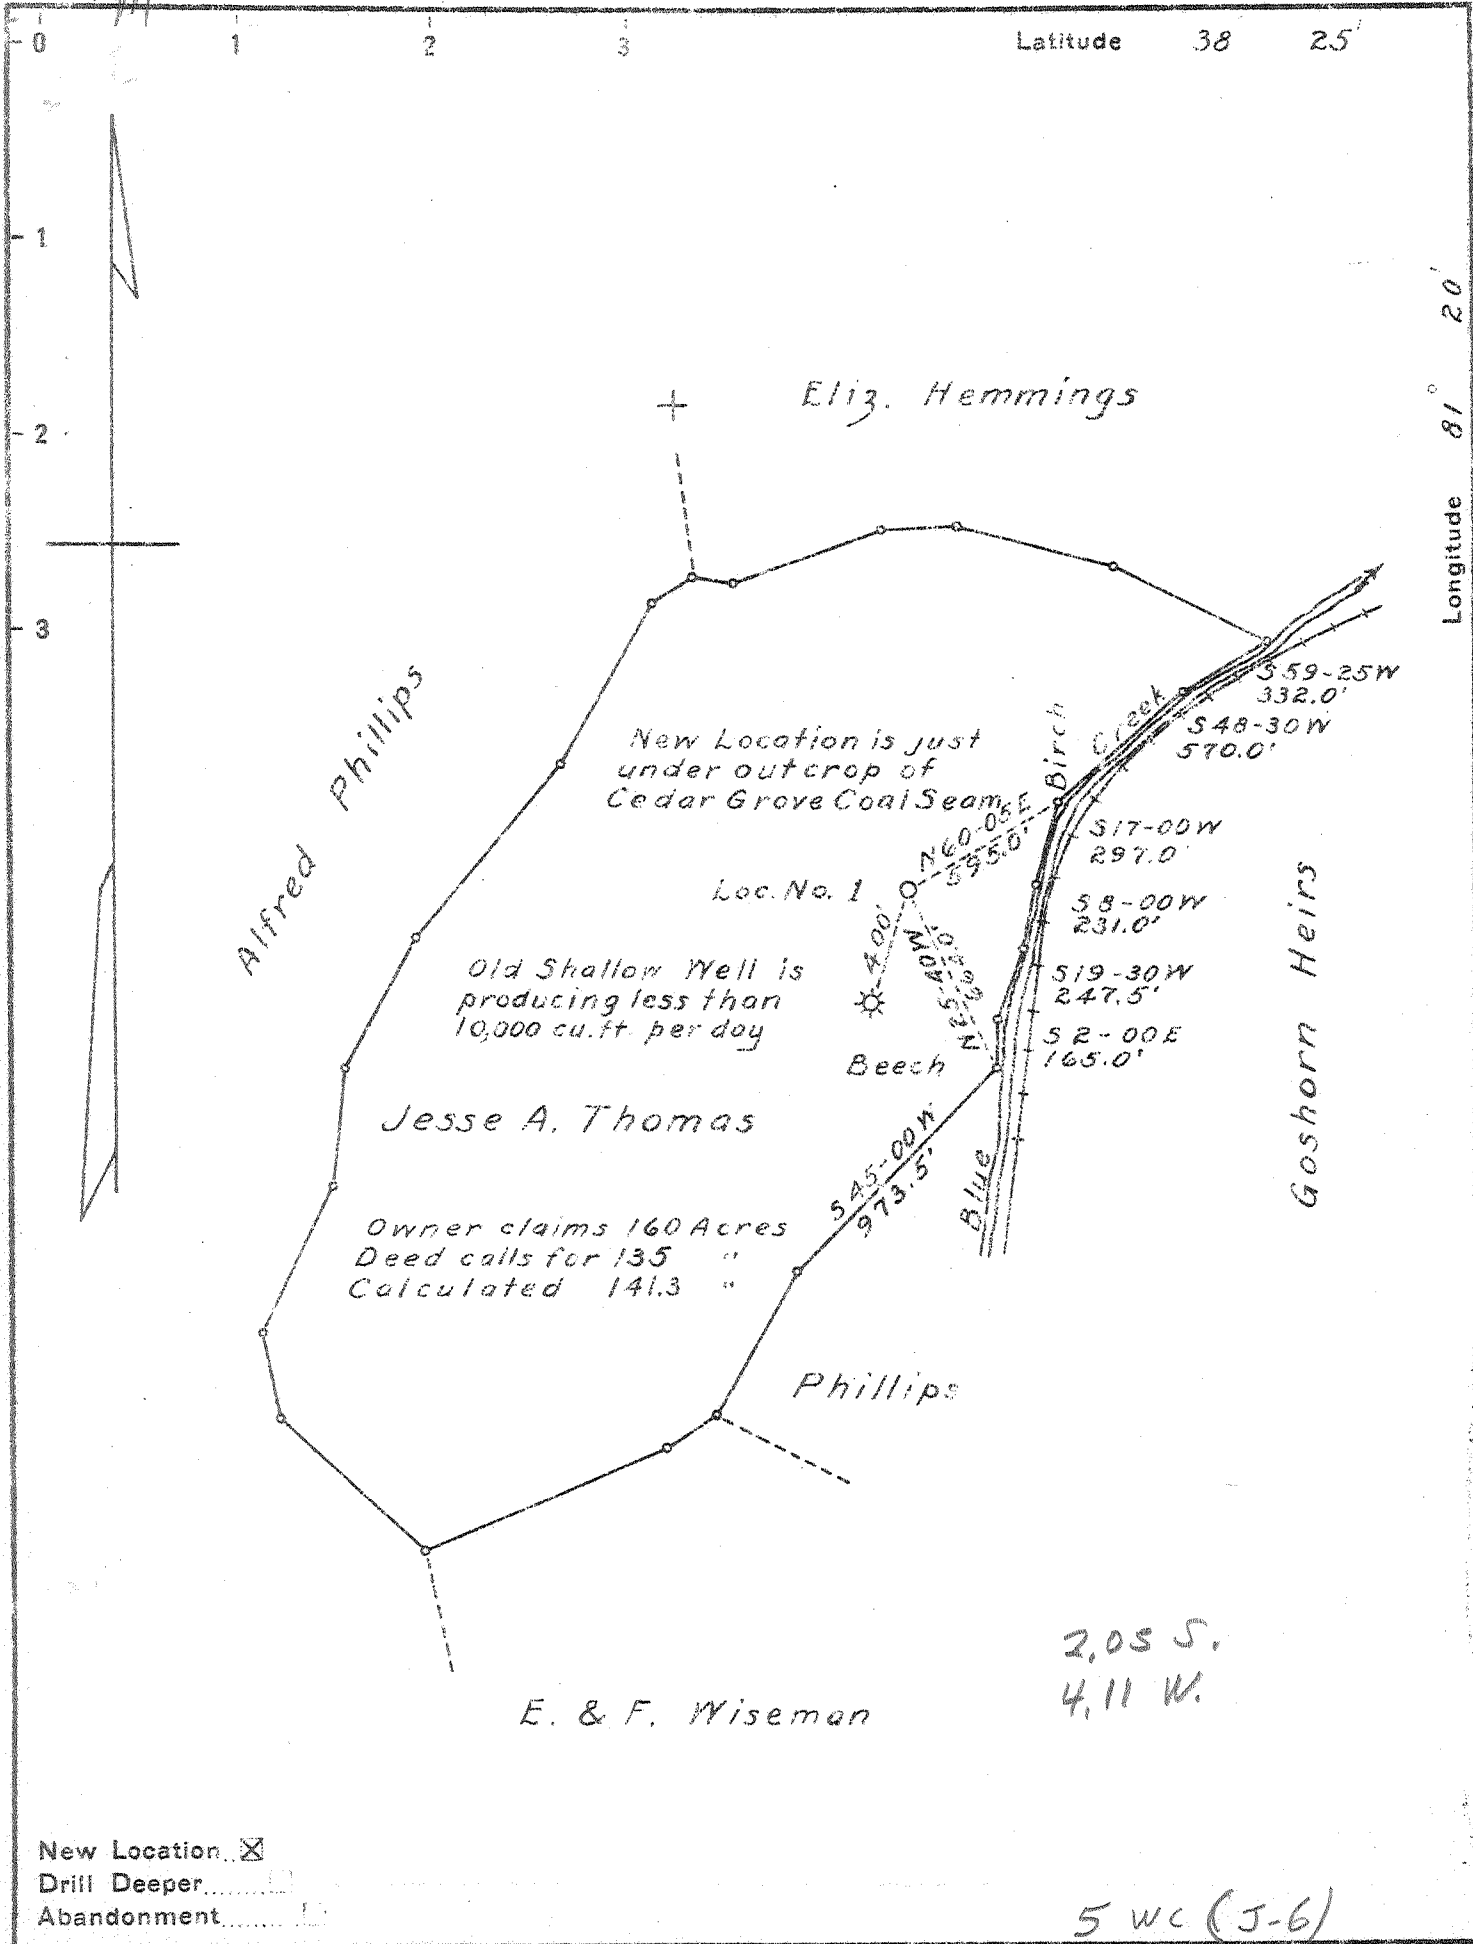

New Location
 Drill Deeper
 Abandonment

2.05 S.
 4.11 W.

5 WC (J-6)

Company R. E. McCabe
 Address Box 346 Charleston RR, W. Va.
 Farm Jesse A. Thomas
 Tract _____ Acres _____ Lease No. 1
 Well (Farm) No. 1 Serial No. _____
 Elevation (Spirit Level) 691.5'
 Quadrangle Clendenin - C
 County Kanawha District E1K
 Engineer W. L. Shaffer
 Engineer's Registration No. _____
 File No. _____ Drawing No. _____
 Date Feb. 3, 1945 Scale 1" = 660'

STATE OF WEST VIRGINIA
 DEPARTMENT OF MINES
 OIL AND GAS DIVISION
 CHARLESTON

WELL LOCATION MAP
 FILE NO. KAN-1213

+ Denotes location of well on United States Topographic Maps, scale 1 to 62,500, latitude and longitude lines being represented by border lines as shown.

- Denotes one inch spaces on border line of original tracing.

Deep Well

WEST VIRGINIA DEPARTMENT OF MINES
OIL & GAS DIVISION
WELL RECORD

Gas Oil Show

~~Casing~~
CASING & TURING

Permit No. Kan 1213	R.E. McCabe		
Glendenin Quad.	Box 346, Charleston 22, W.Va.	16	39
Company	Jesse Thomas Acres 135	13	296 Pld .
Address	Blue Creek	10 1/2	1231
Farm	1 Elev. 691	8 5/8	1608
Location	Elk Kanawha County	7	4856
Well No.	Jesse Thomas, Quick, W.Va.		
District	Alfred A. Phillips Heirs		
Surface	c/o W.A. Phillips, Marmet, W.Va.		
Coal *	May 1, 1945		Casing cemented 7"
Commenced	Aug. 30, 1945		4855' 8-17-45
Completed	2/10 W 1"		20 sacks 10" Aguagel
Volume	400 lbs. 3 days		6-15-45)
Rock Pressure	5 bbl. hr. 48'		
Fresh Water	3 bbl. hr. 395'		
Salt Water	682' H.F.		
Salt Water			

* Oil & Gas by the Winifrede Co., Kanawha Valley Bank Bldg., Charleston, W.Va.
and W.J. Reishman, 1215 Lewis St., Charleston, W.Va.

Soil	0	25	White Shale	4708	4755
Sand Gravel	25	62	Black Shale	4755	4833
Blue Slate	62	96	Corniferous	4833	4955
Black Slate	96	122	Oriskany	4955	4986
Blue Slate	122	219	Lime	4986	5001
Lime	219	247	Sand	5001	5015
Blue Slate	247	263	Lime	5015	5017
Sand	263	285	TOTAL DEPTH		5017
Black Slate	285	305	8-29-45		
Sand	305	342			
Black Slate	342	356	Gas show 3618'; 3690'		
Sand	356	373	S.L. 4855 22' in Conif.		
Blue Slate	373	386	Gas & Oil show 5008		
Sand	386	420	Just enough to show---oil -5017		
Blue Slate	420	470			
Sand	470	501			
Black Slate	501	518			
Sand	518	550			
Black Slate	550	592			
Salt Sand	592	844			
Black Slate	844	883			
Sand	883	918			
Grey Slate	918	965			
Sand	965	1006			
Red Rock	1006	1023			
Slate Shells	1023	1103			
Red Rock	1103	1109			
Slate	1109	1131			
Maxon Sand	1131	1164			
Slate	1164	1174			
Little Lime	1174	1199			
Slate	1199	1205			
Lime Shell	1211	1222			
Big Lime	1222	1395			
Injun Sand	1395	1428			
Slate Shells	1428	1442			
Squaw Sand	1442	1544			
Weir Sand	1544	1608			
Slate Shells	1608	1960			
Brown Shale	1960	1975			
Slate Shells	1975	2983			
Brown Shale	2983	3020			
Slate Shells	3020	3596	Gas show 3618 - 3690'		
Brown Shale	3596	3841			
Slate Shells	3841	4315			
Brown Shale	4315	4708			