


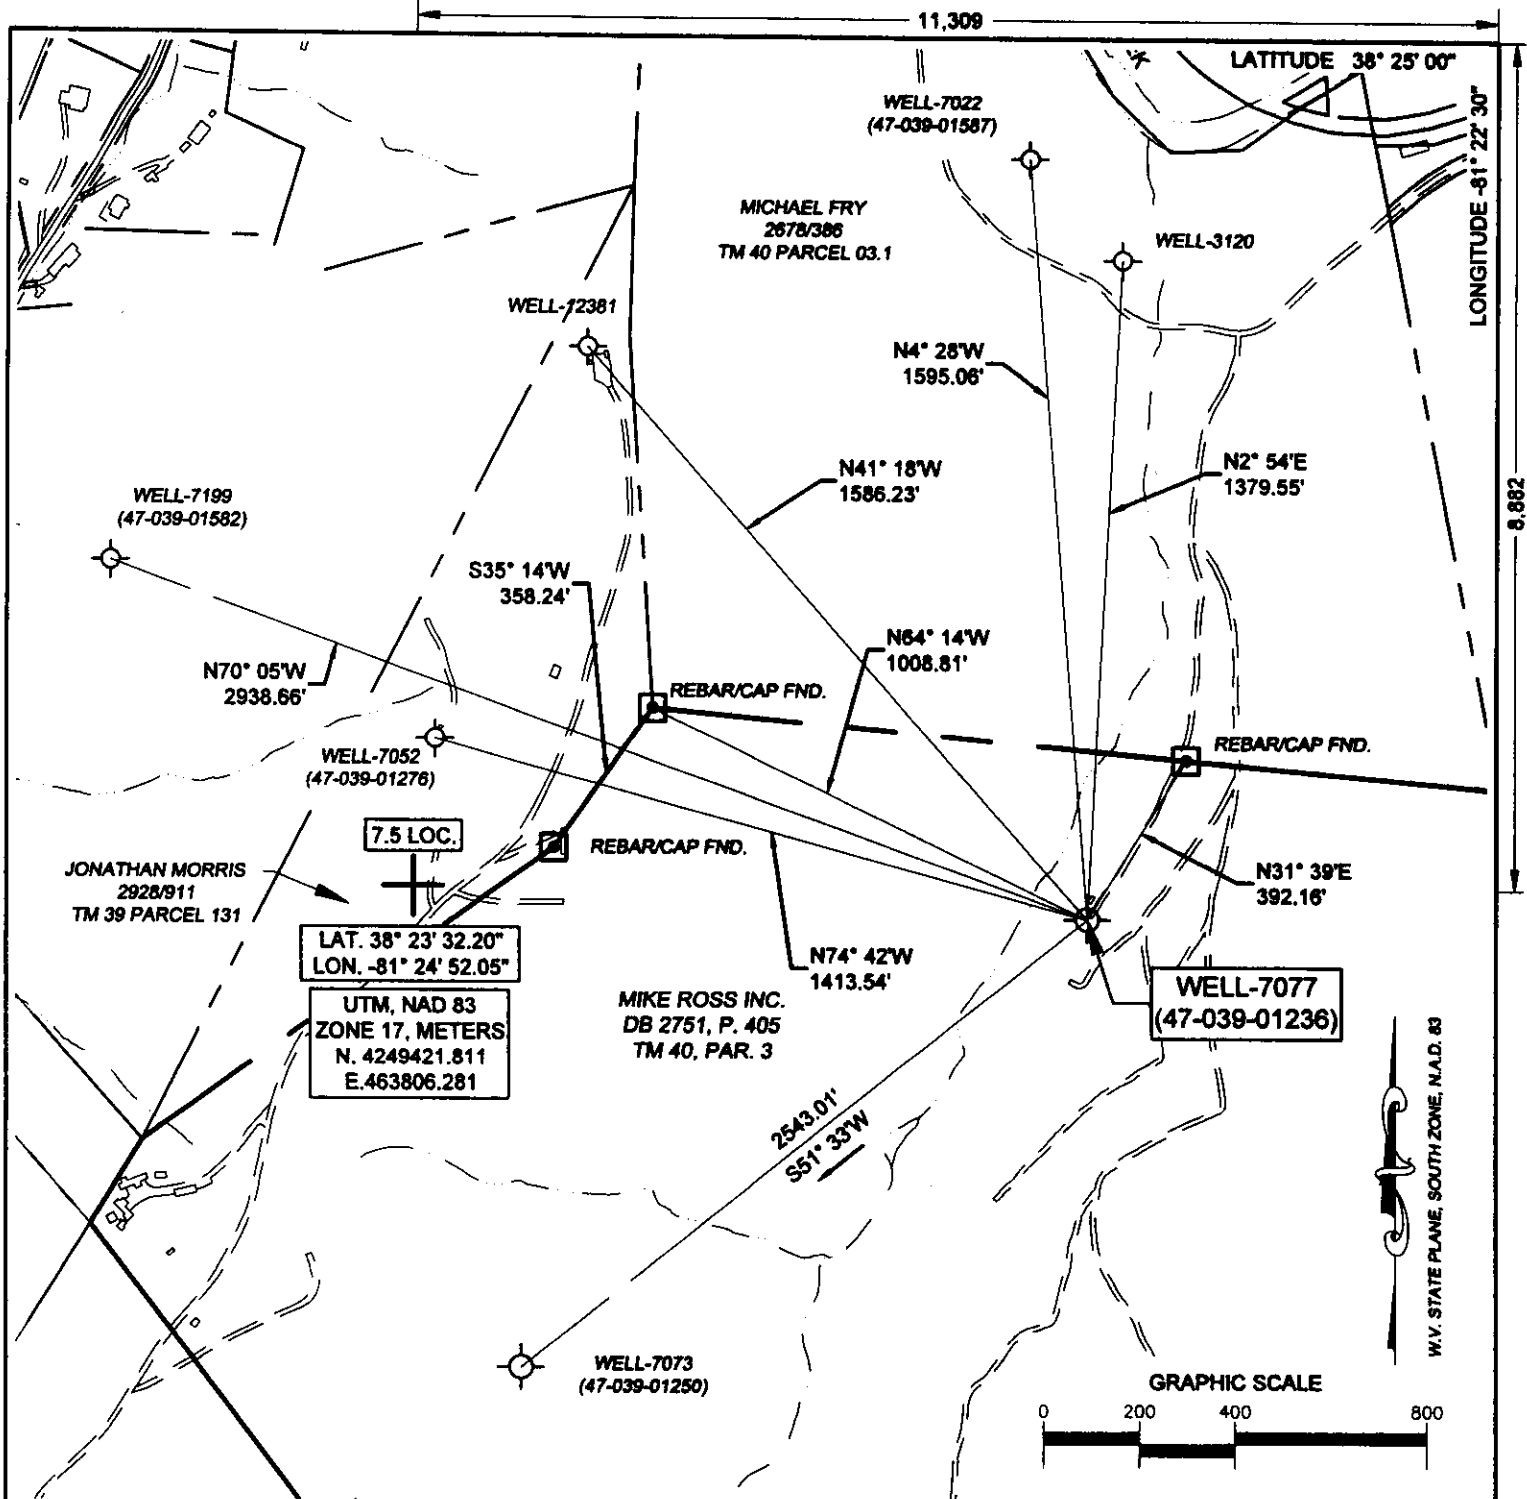

(+) DENOTES LOCATION OF WELL ON UNITED STATES TOPOGRAPHIC MAPS

FILE No. 2601-3079-001-001

DRAWING No. COCO A 7077


SCALE 1"=400'

MINIMUM DEGREE OF
ACCURACY 1:200

PROVEN SOURCE OF
ELEVATION TRIMBLE R10
GPS UNIT

I THE UNDERSIGNED, HEREBY CERTIFY THAT
THIS PLAT IS CORRECT TO THE BEST OF MY
KNOWLEDGE AND BELIEF AND SHOWS ALL THE
INFORMATION REQUIRED BY LAW AND THE
REGULATIONS ISSUED AND PRESCRIBED BY THE
DIVISION OF ENVIRONMENTAL PROTECTION.

(SIGNED) *Richard B. Henline*
RICHARD B. HENLINE PS #1984

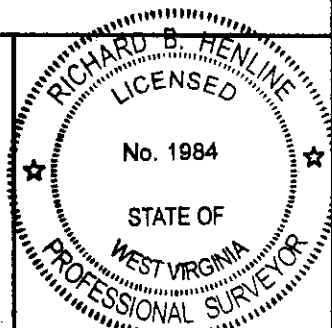

STATE OF WEST VIRGINIA
DIVISION OF ENVIRONMENTAL PROTECTION
OFFICE OF OIL AND GAS
NITRO, WV



DATE AUGUST 5 2026
OPERATOR'S WELL No. 7077
API WELL No.

WELL TYPE: OIL ☐ GAS ☒ LIQUID INJECTION ☐ WASTE DISPOSAL ☐
(IF "GAS") PRODUCTION ☐ STORAGE ☒ DEEP ☒ SHALLOW ☐

LOCATION: ELEVATION 778.3' WATER SHED BLUE CREEK
DISTRICT ELK COUNTY KANAWHA
QUADRANGLE BLUE CREEK, WV

SURFACE OWNER MIKE ROSS INC. ACREAGE 142

OIL & GAS ROYALTY OWNER W.A. PHILLIPS, ET AL

LEASE ACREAGE 300 LEASE NO. 1014335-000

PROPOSED WORK: DRILL ☐ CONVERT ☐ DRILL DEEPER ☐ REDRILL ☐ FRACTURE ☐
STIMULATE ☒ PLUG OFF OLD FORMATION ☐ PERFORATE NEW FORMATION ☐
OTHER PHYSICAL CHANGE IN WELL (SPECIFY)
PLUG AND ABANDON ☐ CLEAN OUT AND REPLUG ☐

TARGET FORMATION ORISKANY ESTIMATED DEPTH 5105
WELL OPERATOR COLUMBIA GAS TRANSMISSION, LLC DESIGNATED AGENT MARIA MEDVEDEVA
ADDRESS PO BOX 1273, CHARLESTON, WV ADDRESS 1700 MACCORKLE AVE., S.E.
25325-1273 CHARLESTON, WV 25314


FORM IV-6 (8-78)

(ROMANCE)

mytopo
A Trimble Company

BLUE CREEK QUADRANGLE
WEST VIRGINIA
TOPOGRAPHIC SERIES

(CLIO)

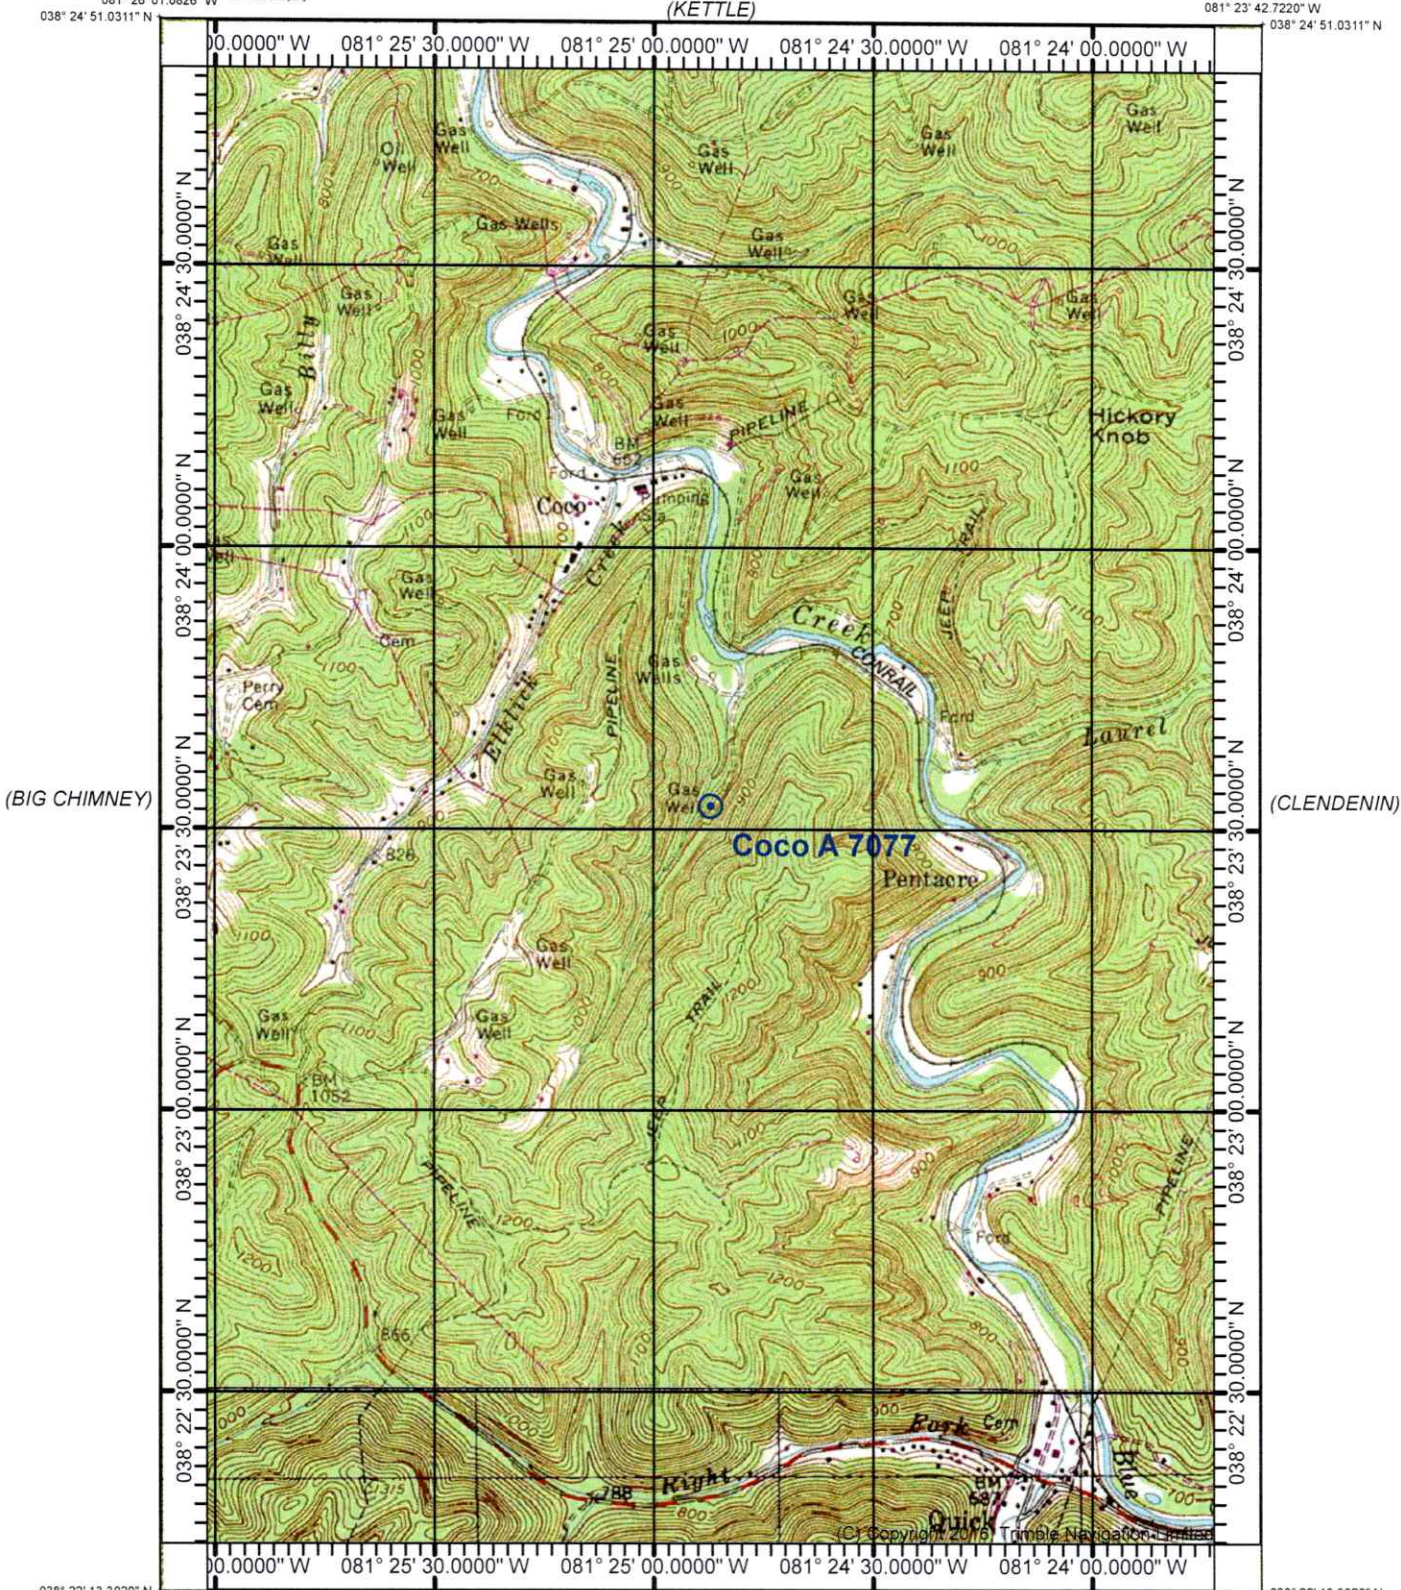

(CHARLESTON EAST)

Produced by Trimble Terrain Navigator Pro
Topography based on USGS 1:24,000
Maps

North American 1983 Datum (NAD83)

To place on the predicted North American
1927 move the projection lines 11M N and
14M E

Declination

GN 0.26° W
MN 7.91° W

(QUICK)

SCALE 1:24000

0 Mile 1
0 Yards 1000
0 Kilometer 1

CONTOUR INTERVAL 20 FT

(MAMMOTH)

38081-D3-TM-024
BLUE CREEK, WV
JAN 1, 1977

09/25/2026