


Latitude 38 30

Longitude 81 20

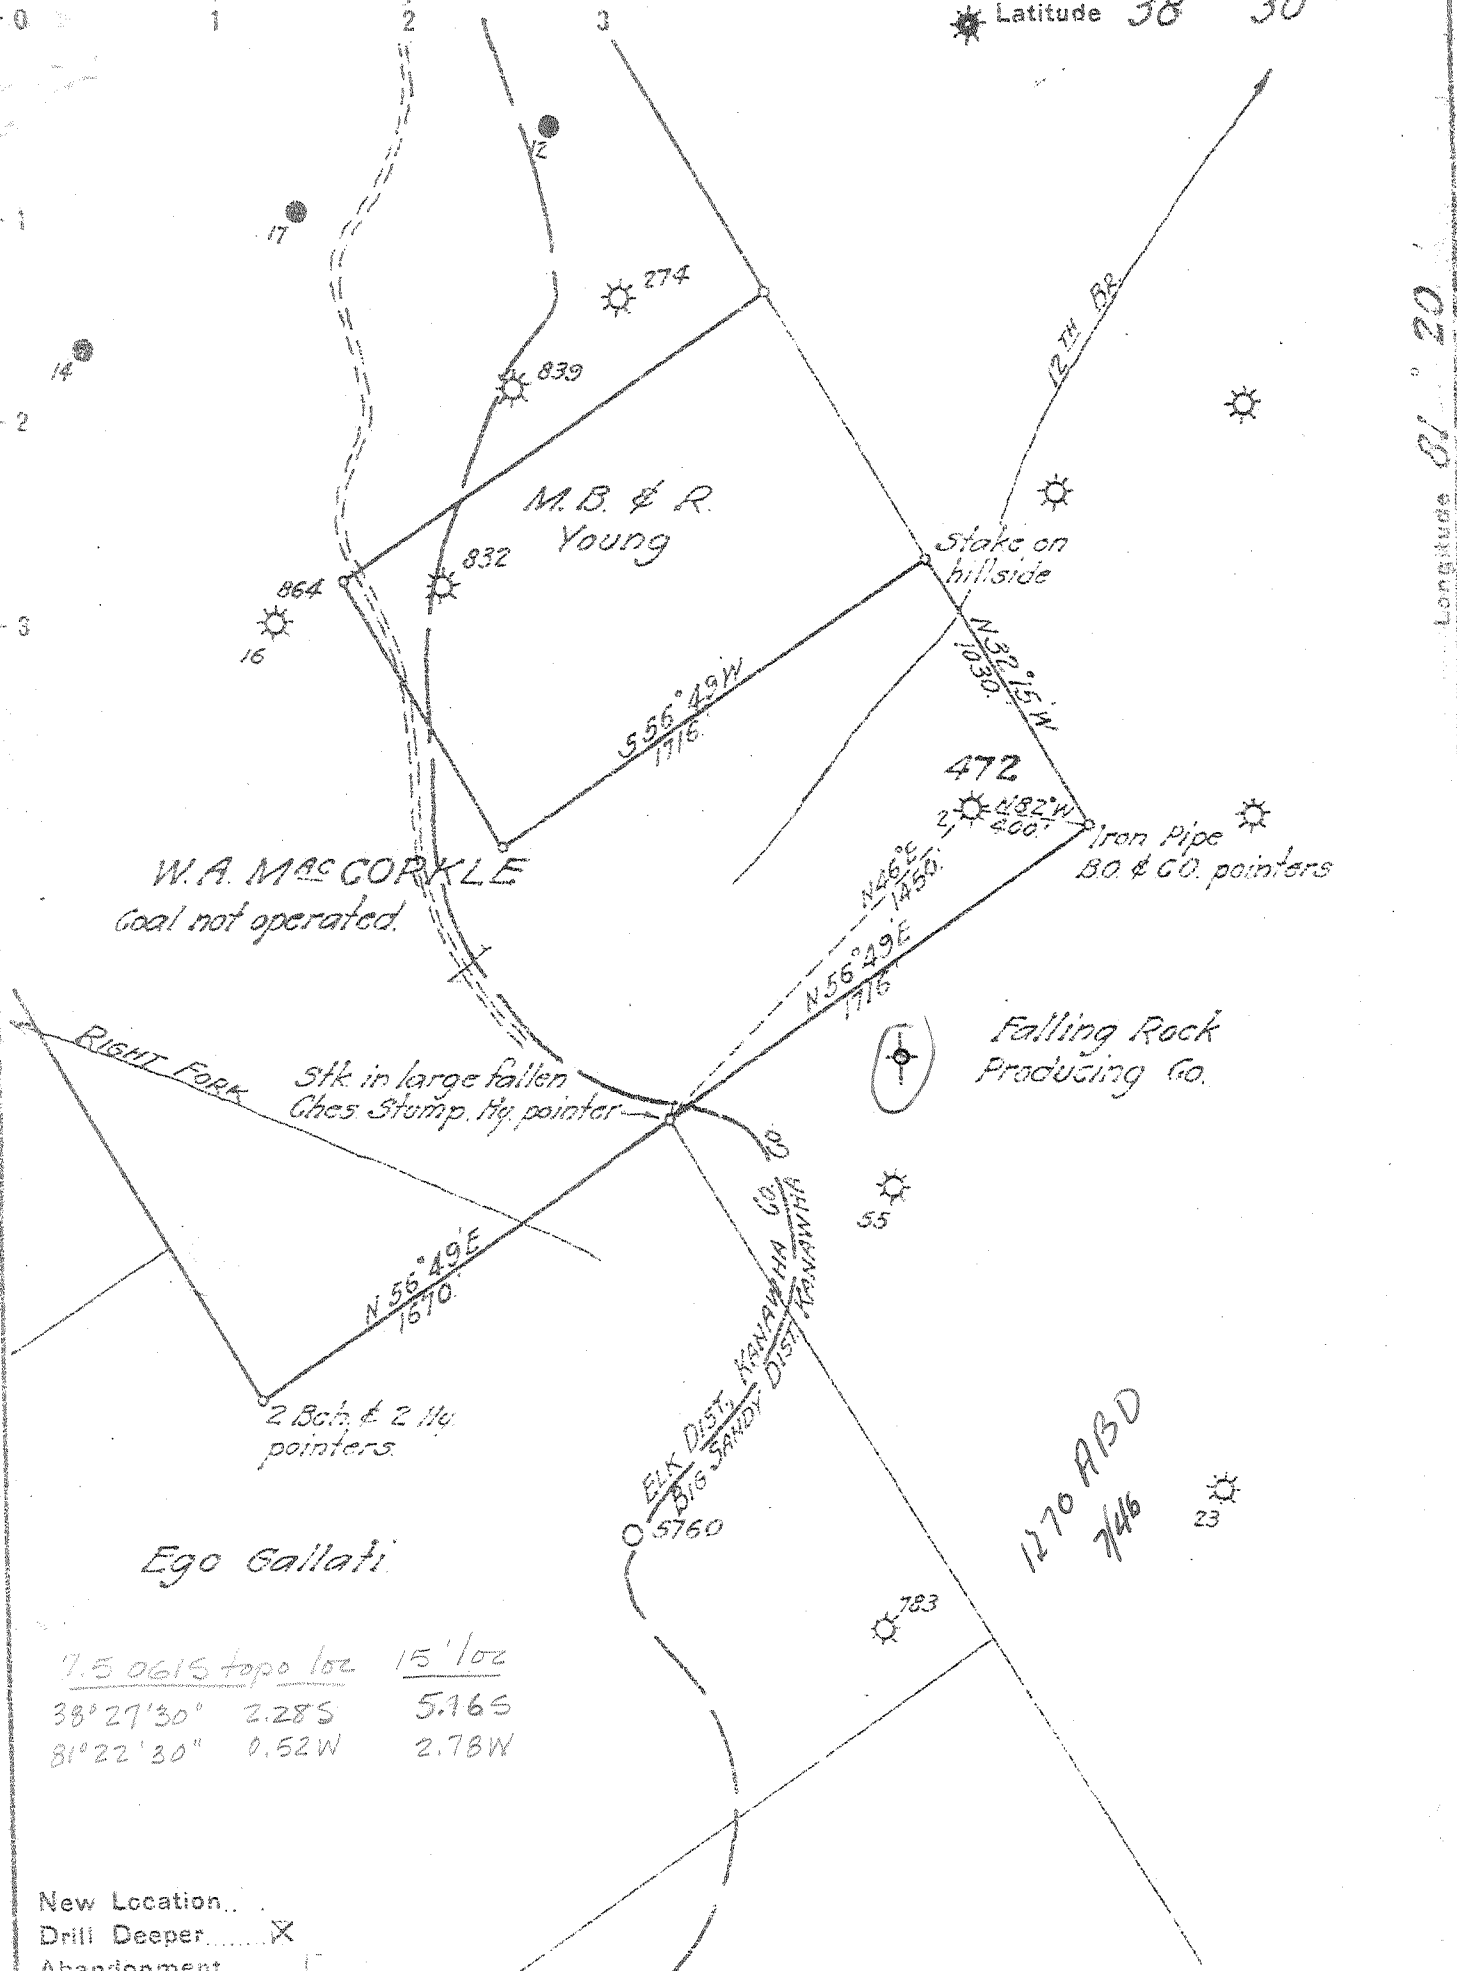

7.5 0615 topo loc 15' 10z  
 38° 27' 30" 2.28S 5.16S  
 81° 22' 30" 0.52W 2.78W

New Location...  
 Drill Deeper... X  
 Abandonment

Company UNITED FUEL GAS CO.  
 Address CHARLESTON W.VA  
 Farm W.A. MAC CORKLE  
 Tract \_\_\_\_\_ Acres 338 Lease No. 4832  
 Well (Farm) No. 2 Serial No. 472  
 Elevation (Spirit Level) 1006.8  
 Quadrangle GLENDENIN  
 County KANAWHA District BIG SANDY  
 Engineer J.H. Moore  
 Engineer's Registration No. 662  
 File No. 74-63 Drawing No \_\_\_\_\_  
 Date April 5, 1946 Scale 1"=660'

STATE OF WEST VIRGINIA  
 DEPARTMENT OF MINES  
 OIL AND GAS DIVISION  
 CHARLESTON

WELL LOCATION MAP  
 FILE NO. KAN-1270-D

+ Denotes location of well on United States Topographic Maps, scale 1 to 62,500, latitude and longitude lines being represented by border lines as shown.

- Denotes one inch spaces on border line of original tracing

6-6-46

WEST VIRGINIA DEPARTMENT OF MINES  
OIL & GAS DIVISION  
W E L L R E C O R D

Permit No. Kan 1270-D  
Clendenin Quad.  
Company  
Address  
Farm  
Location  
Well No.  
District  
Surface  
Mineral  
Commenced  
Completed  
Open flow  
Volume  
Salt Water

United Fuel Gas Company  
Charleston, W.Va.  
W.A. MacCorkle Acres 338  
Falling Rock Creek  
472 Elev. ---  
Big Sandy Kanawha County  
  
Monroe Company, Charleston, W.Va..  
9-20-12  
11-19-12  
2/10ths M in 6 5/8"  
2,262,000 C.F.  
1090'

Gas Well  
CASING & TUBING

6 5/8            1619  
3                2030  
  
Anchor Packer  
Size 3 x 6 5/8  
Depth 1701'  
  
Coal at 200' 24"  
400' 60"; 520' 60"

ABANDONMENT

Conductor		12	
Sand Lime	12	80	
Sand	80	130	
Sandy Lime	130	200	
Coal	200	202	✓
Slate	202	220	
Lime	220	300	
Slate	300	310	
Sand	310	400	
Coal	400	405	✓
Slate	405	415	
Sand	415	495	
Slate	495	520	
Coal	520	525	✓
Slate & Shells	525	610	
Lime	610	715	
Slate & Shells	715	750	
Sand	750	790	
Slate	790	810	
Sandy Lime	810	870	Gas 750
Slate	870	875	
Salt Sand	875	1370	Gas 980
Show of oil	1050		
Slate	1370	1390	
Red Rock	1390	1410	
Lime	1410	1480	
Maxon Sand	1480	1520	
Slate	1520	1535	
Little Lime	1535	1585	
Pencil Cave	1585	1595	
Big Lime	1595	1770	
Slate	1770	1775	
Wier Sand	1775	2000	
Gas	1880		
Big Gas	1985		
Total depth		2006	

1770  
1595  
-----  
1175

1770  
1007  
-----  
763