

Latitude 38° 25'


P

Longitude 81° 25'

PERRY STARCHER
10A

formerly
E. B. SLACK
200 A.

John Ramsey
20 A.

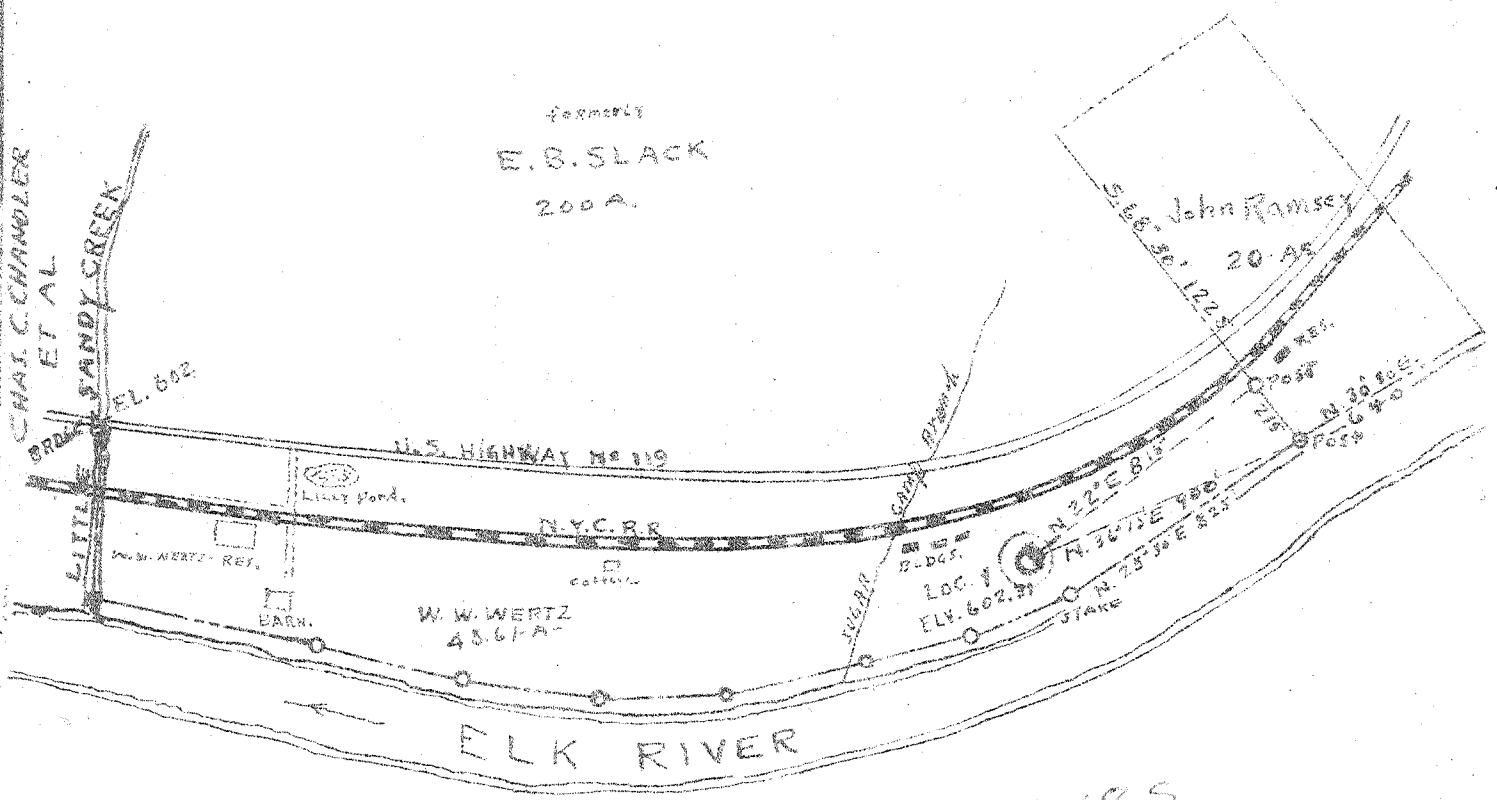

GOSHORN HRS.

0.185
4.3 W

New Location
 Drill Deeper
 Abandonment

4 NW 15-6

Company A. C. RADFORD
 Address 918 BIGLEY AVE. Charleston, W.VA.
 Farm W. W. WERTZ
 Tract _____ Acres 45.61 Lease No. _____
 Well (Farm) No. 1 Serial No. _____
 Elevation (Spirit Level) 602.31
 Quadrangle CLENDENIN - WC
 County KANAWHA District ELK
 Engineer J. M. Moore
 Engineer's Registration No. 159
 File No. _____ Drawing No. _____
 Date 6-1-46 Scale 1" = 600'

STATE OF WEST VIRGINIA
 DEPARTMENT OF MINES
 OIL AND GAS DIVISION
 CHARLESTON

WELL LOCATION MAP
 FILE NO. KAN-1285

+ Denotes location of well on United States Topographic Maps, scale 1 to 62,500, latitude and longitude lines being represented by border lines as shown.
 - Denotes one inch spaces on border line of original tracing.

Deep Well

WEST VIRGINIA DEPARTMENT OF MINES
OIL & GAS DIVISION
W E L L R E C O R D

Permit No. Kan 1285
Clendenin Quad.

Dry Hole
CASING & TUBING

Company	A.C. Radford		
Address	918 Bigley Ave., Charleston 2, W.Va.	16	57
Farm	W.W. Wertz Acres 105 (plus)	13	227
Location	Elk River	10	1209
Well No.	One Elev. 602.31	80 1/2	1353
District	Elk Kanawha County	6 5/8	4839
Surface	W.W. Wertz, Charleston, W.Va.		
Mineral	W.W. Wertz et al, Charleston, W.Va.		
Commenced	6-12-46		
Completed	12-7-46		
Fresh Water	70' H.F.; 350' H.F.		
Salt Water	1258 3 BPH		

Casing cemented
7" 150'

Soil	0	55
Sand Rock	55	75
Slate	75	87
Sand	87	133
Slate	133	138
Sand	138	160
Slate	160	255
Sand	255	295
Slate	295	319
Sand	319	355
Slate	355	363
Sand	363	370
Slate	370	406
Sand	406	445
Slate	445	460
Lime	460	505
Slate	505	512
Gritty Lime	512	550
Sand	550	555
Slate	555	560
Sand	560	575
Slate	575	607
Sand	607	620
Lime	620	640
Slate	640	650
Lime	650	670
Slate	670	688
Sand	688	1279
Slate	1279	1292
Sand	1292	1328
Slate	1328	1332
Lime	1332	1355
Slate	1355	1359
Lime	1359	1363
Slate	1363	1375
Big Lime	1375	1381
Break	1381	1386
Big Lime	1386	1565
Injun Sand	1565	1600
Lime	1600	1655
Sand	1655	1705
Slate & Shells	1705	1770
Weir Sand	1770	1830
Slate	1830	1837
Lime	1837	1850
Slate-Lime Shells	1850	3710
Brown Shale	3710	3825
White Sand	3825	4434
Brown Shale	4434	4725
White Slate	4725	4788
Brown Shale	4788	4828
Gornif. Lime	4828	4951
Sand - <i>Orisk.</i>	4951	4987
Lime	4987	4996
Sand	4996	5010
Lime	5010	5014
Gritty Lime	5014	5024
Black Lime	5025	5029

Little Gas at 1670 no test

Little gas in Lime shell no test

4828	4951	5010
602	602	602
<u>4226</u>	<u>4349</u>	<u>4408</u>