


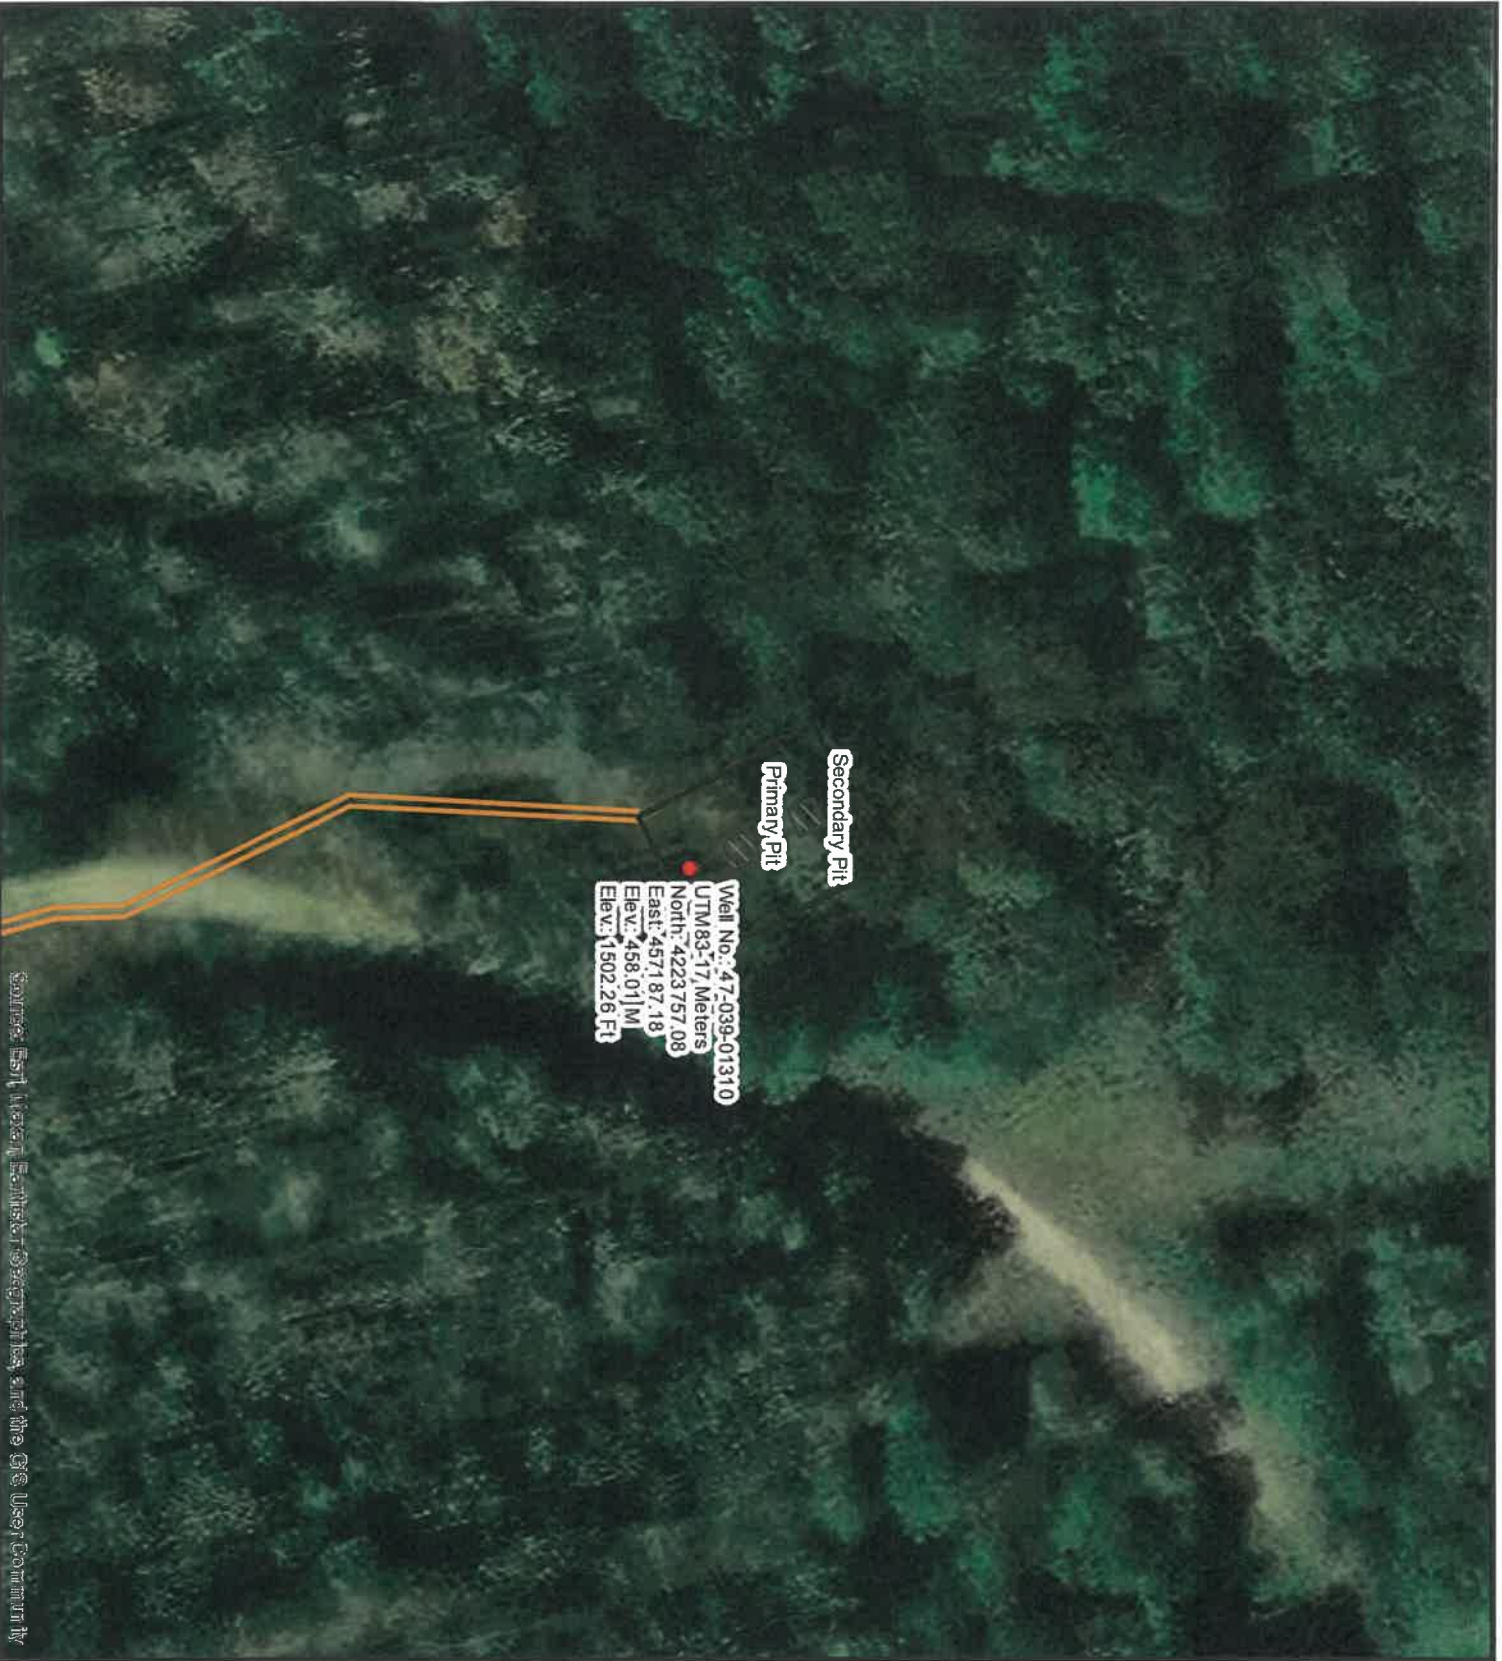

Source: Esri, DeLorme, GeoEye, and the Geo User Community



Diversified Gas & Oil
Corporation
100 Diversified Way
Pikeville KY, 41051

06/12/2026


47-039-01310


Well Plugging Map

Legend

- Well
- Pits
- Pad
- Access Road
- Public Roads

RECEIVED
Office of Oil and Gas
MAY 14 2026
WV Department of
Environmental Protection

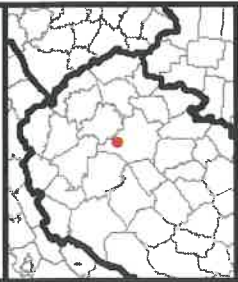

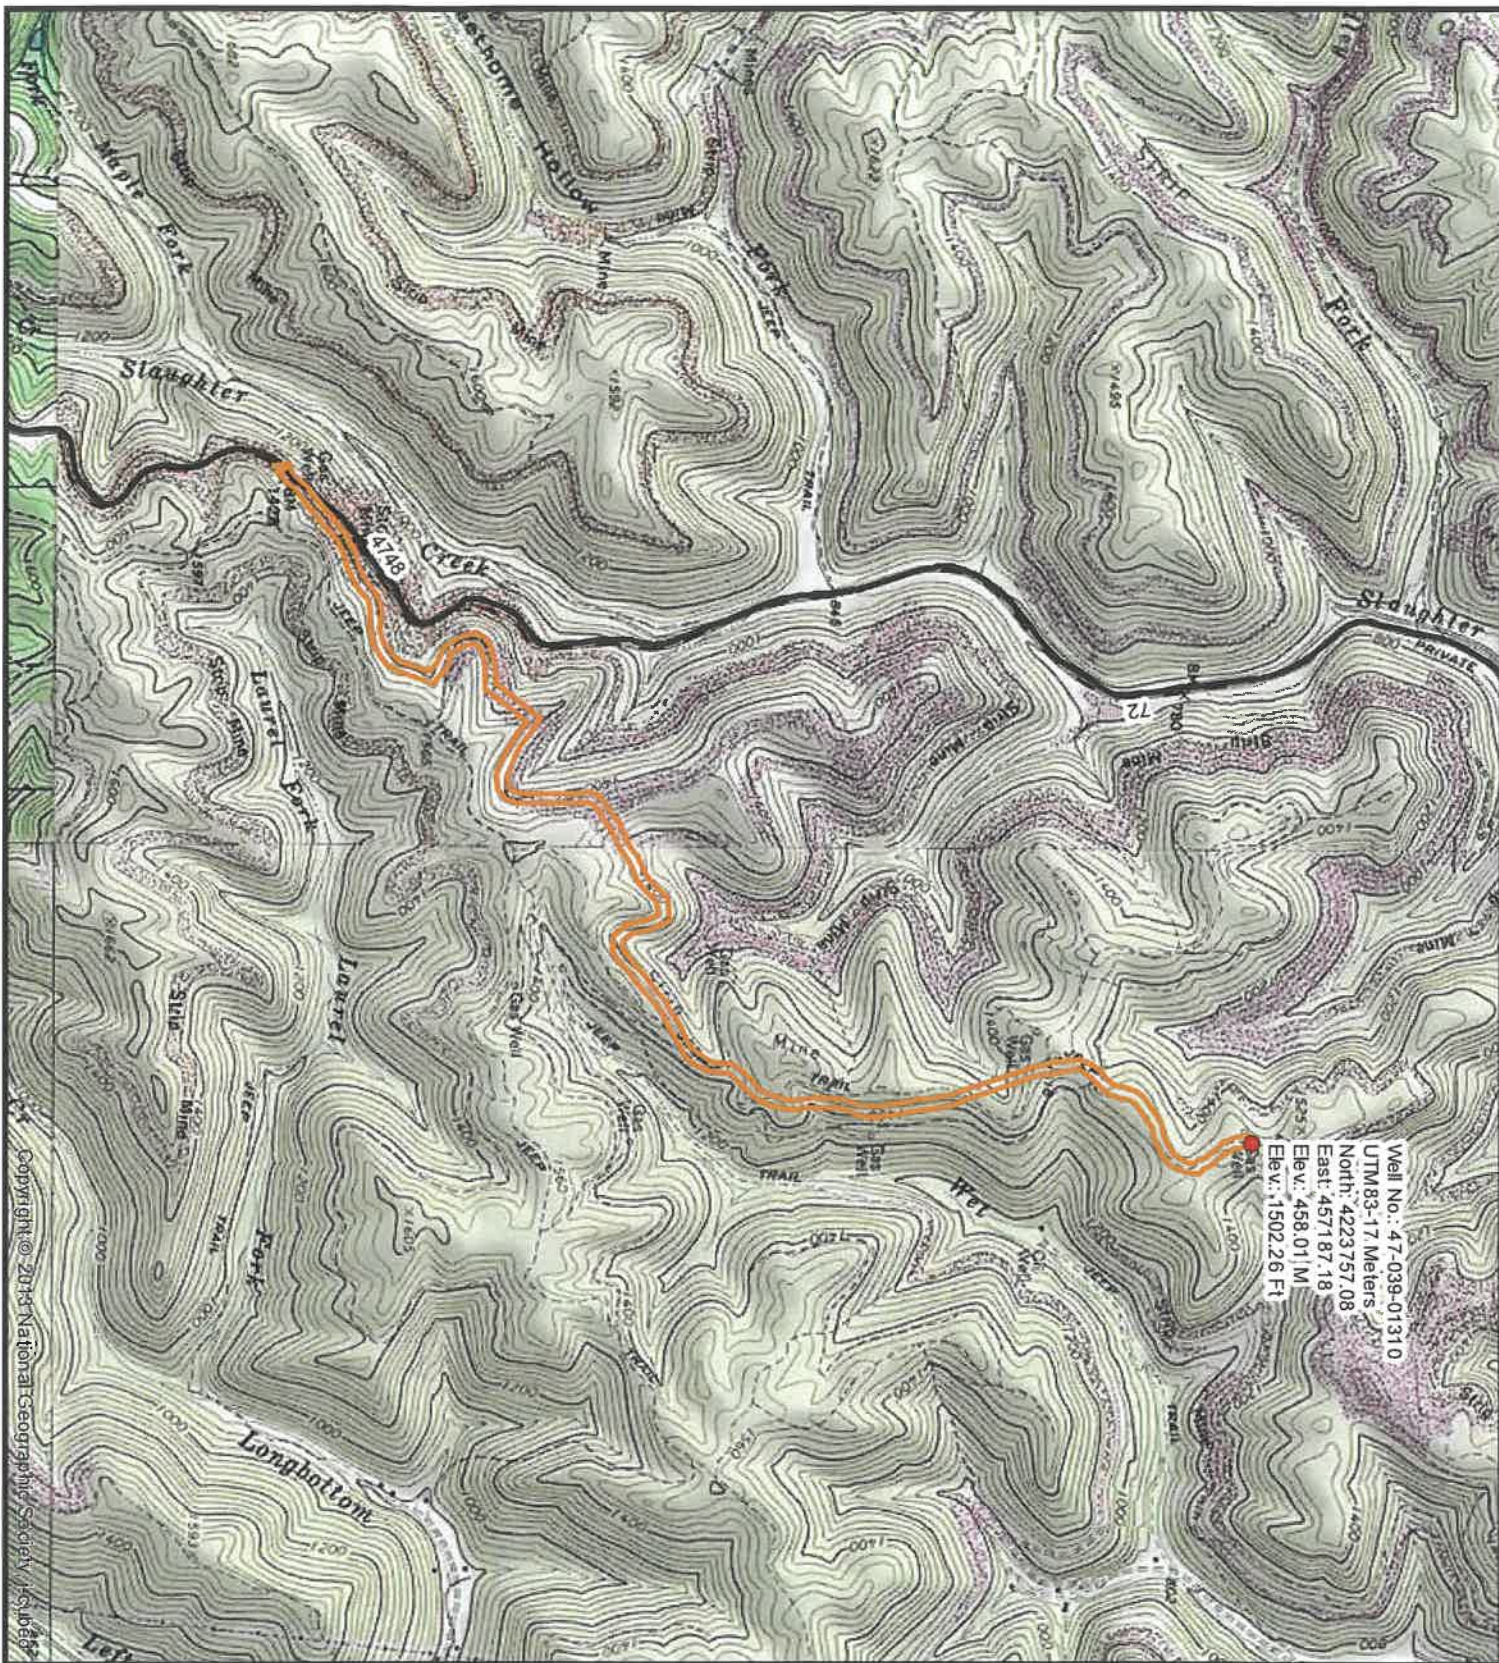

1" = 2,000' 0 2500 1,000		RECEIVED Office of Oil and Gas MAY 14 2026 WV Department of Environmental Protection	Legend - Well - Pits - Pad - Access Road - Public Roads	Well Plugging Map 47-039-01310	Diversified Gas & Oil Corporation 100 Diversified Way Pikeville KY, 41051 06/12/2026
--	--	---	---	--	---

WW-7
8-30-06



West Virginia Department of Environmental Protection
Office of Oil and Gas
WELL LOCATION FORM: GPS

API: 4703901310 WELL NO.: SLAUGHTERS CREEK 13
FARM NAME: Slaughters Creek Coal & Land Co.
RESPONSIBLE PARTY NAME: Diversified Production, LLC
COUNTY: Kanawha DISTRICT: Cabin Creek
QUADRANGLE: Cedar Gove 7.5'
SURFACE OWNER: Blackhawk Land & Resources, LLC
ROYALTY OWNER: Blackhawk Land & Resources, LLC
UTM GPS NORTHING: 4223757.08
UTM GPS EASTING: 457187.18 GPS ELEVATION: 1502.26'

The Responsible Party named above has chosen to submit GPS coordinates in lieu of preparing a new well location plat for a plugging permit or assigned API number on the above well. The Office of Oil and Gas will not accept GPS coordinates that do not meet the following requirements:

1. Datum: NAD 1983, Zone: 17 North, Coordinate Units: meters, Altitude: height above mean sea level (MSL) – meters.
2. Accuracy to Datum – 3.05 meters
3. Data Collection Method:

Survey grade GPS ____: Post Processed Differential ____

Real-Time Differential ____

Mapping Grade GPS X: Post Processed Differential X

Real-Time Differential ____

4. Letter size copy of the topography map showing the well location.

I the undersigned, hereby certify this data is correct to the best of my knowledge and belief and shows all the information required by law and the regulations issued and prescribed by the Office of Oil and Gas.


Signature

Chris Veazey - Director of Administration
Title

5/5/2006
Date

RECEIVED
Office of Oil and Gas
MAY 14 2006
WV Department of
Environmental Protection

06/12/2026