


Latitude 38° 30'

7.5 0615 topo loc
38° 27' 30"
81° 25' 00"

Longitude 81° 25'

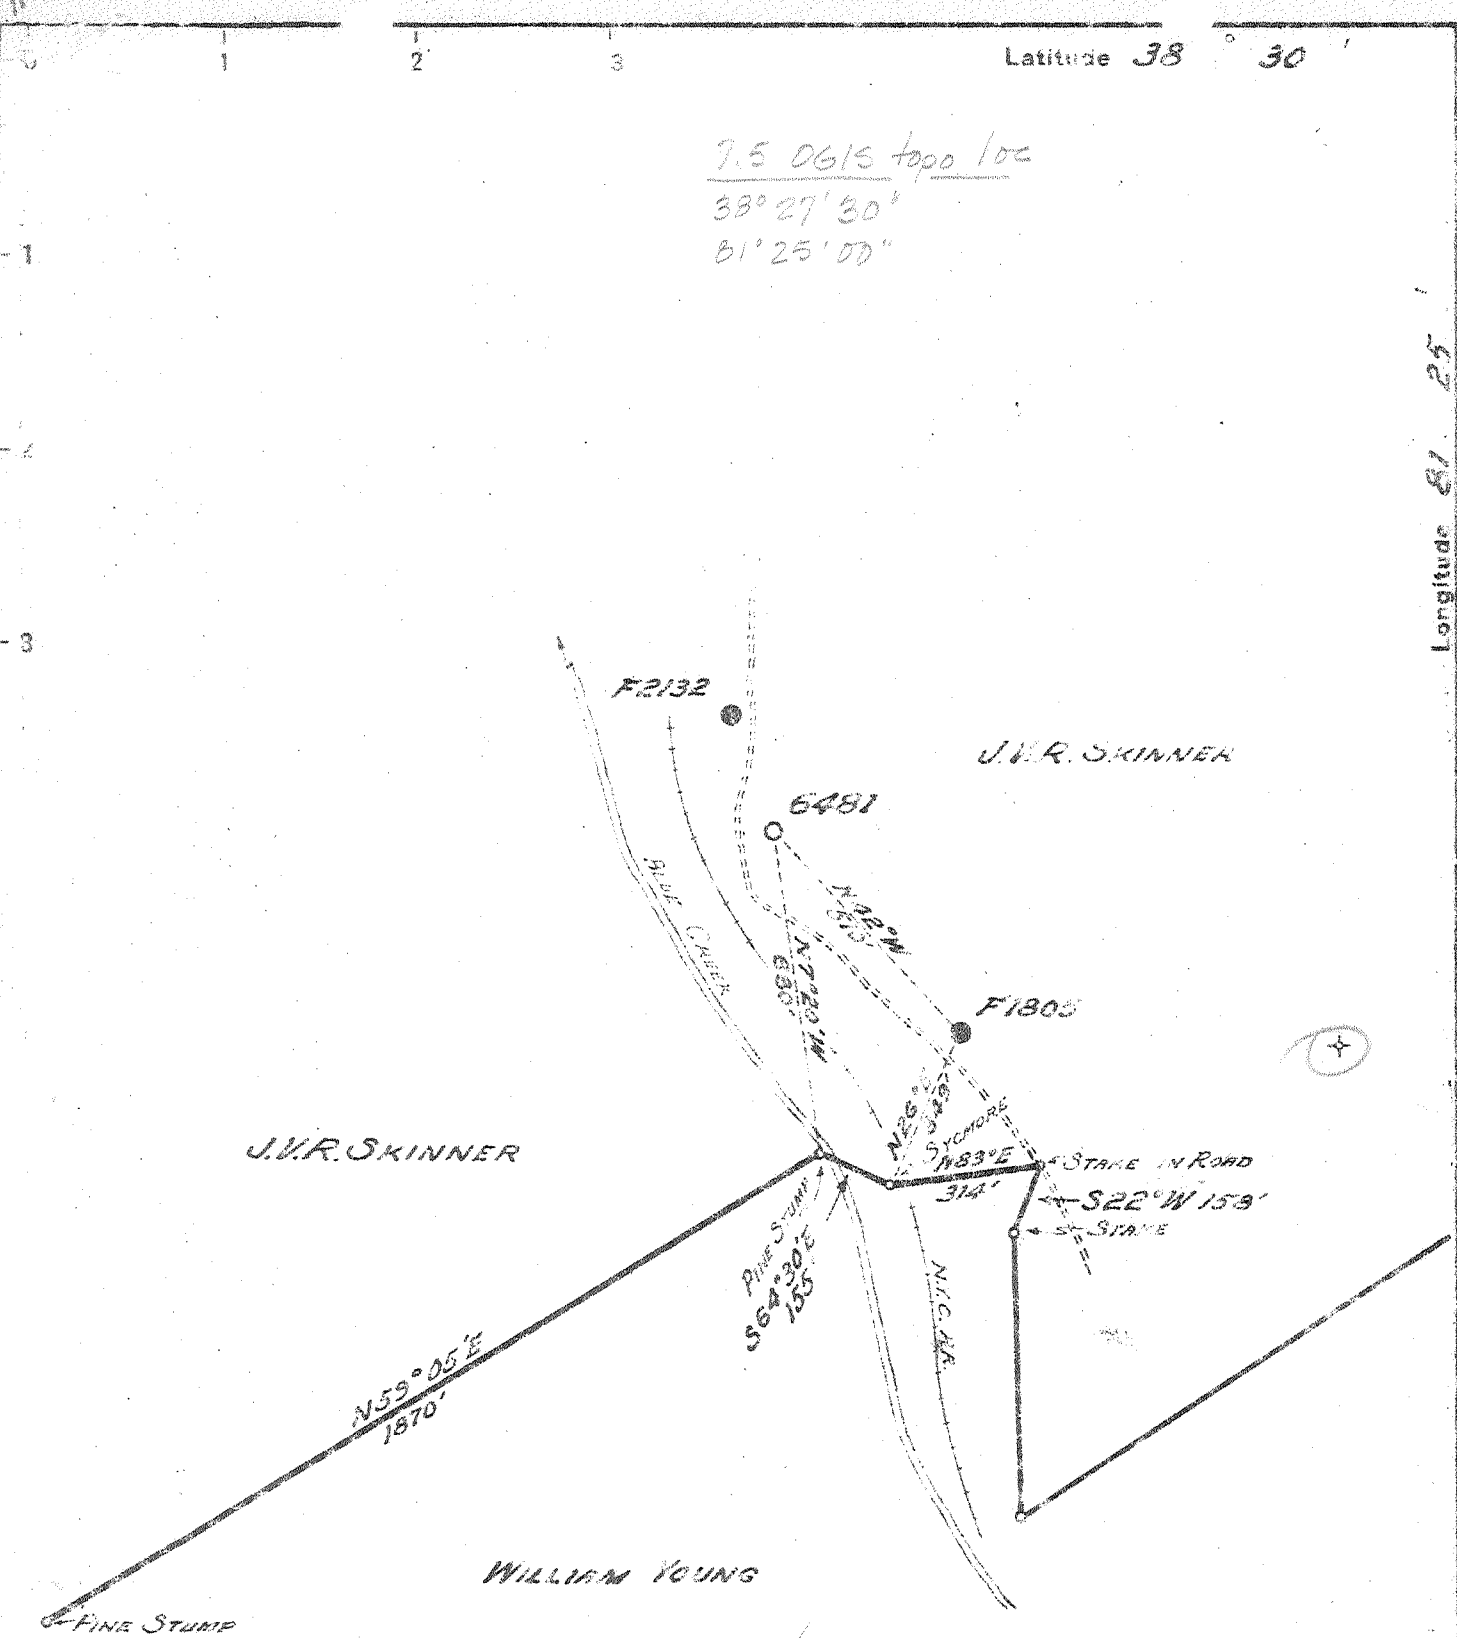

7.5 0615 topo loc 15' loc
38° 27' 30" 2.36S 5.24S
81° 25' 00" 0.54W 0.54W

(Handwritten circled 'W')

(Handwritten '0.6 W')

(Handwritten '5.3 S')

(Handwritten '200 00 1948')

New Location

Drill Deeper

Abandonment

Company	UNITED FUEL GAS CO.
Address	CHARLESTON, W.VA.
Farm	J.V.R. SKINNER
Tract	Acres 260. Lease No. 4816
Well (Farm) No.	1 Serial No. 6481
Elevation (Spirit Level)	717.65
Quadrangle	CLENDENIN <i>(Handwritten 'W')</i>
County	KANAWHA District <i>(Handwritten 'ELK')</i>
Engineer	
Engineer's Registration No.	662
File No.	72-63 Drawing No.
Date	11-3-48 Scale 1" = 400'

STATE OF WEST VIRGINIA
DEPARTMENT OF MINES
OIL AND GAS DIVISION
CHARLESTON

WELL LOCATION MAP
FILE NO. KAN-1483

(Handwritten 'Deep Well')

+ Denotes location of well on United States Topographic Maps, scale 1 to 62,500, latitude and longitude lines being represented by border lines as shown.

- Denotes one inch spaces on border line of original tracing.

5.3 S. 38° 30'
 0.6 W. 81° 25'

P

WEST VIRGINIA DEPARTMENT OF MINES
 OIL & GAS DIVISION
 WELL RECORD

3 SE (J-6)

NW- Permit No. Kan 1483
 Clendenin Quad.

Dry Hole
 CASING & TUBING

Company	United Fuel Gas Company		
Address	P.O. Box 1273, Charleston 25, W.Va.		
Farm	J.V.R. Skinner	Acres 260	10 1/2 257 257
Location	Blue Creek		8 5/8 1371 1371
Well No.	6481	Elev. 717.65	7 OD 4937 4937
District	Elk Kanawha County		
Surface			
Mineral	J.V.R. Skinner, Agt., St. Albans, W.Va.		
Commenced	12-9-48		
Completed	3-30-49		
Not shot			
Volume	Dry Hole		
Fresh Water	240°H.F.		

Soil	0	14
Sand	14	60
Slate	60	75
Lime	75	100
Slate	100	120
Lime	120	140
Slate	140	160
Sand	160	177
Slate	177	209
Sand	209	268
Slate	268	295
Sand	295	333
Slate	333	360
Lime	360	400
Slate & Shells	400	485
Sand	485	510
Slate	510	550
Sand	550	575
Slate	575	640
Sand	640	905
Slate	905	934
Salt Sand	935	1175
Slate	1175	1190
Red Rock	1190	1230
Slate	1230	1310
Lime - 1. Lime	1310	1352
Slate	1352	1359
Lime	1359	1372
Slate	1372	1375
Big Lime	1375	1515
Sand - 306	1515	1538
Red Rock - 319	1538	1550
Gritty Lime	1550	1585
Weir Sand	1585	1800
Slate & Shells	1800	3580
Brown Shale	3580	3610
Lime	3610	3665
Brown Shale	3665	3930
White Slate	3930	4425
Brown Shale	4425	4760
White Slate	4760	4810
Dark Shale	4810	4925
Corniferous Lime	4925	5060
Oriskany Sand	5060	5087
Lime	5087	5107
Oriskany Sand	5107	5122
Lime	5122	5128
Total depth		5128

4925	5060	5122
718	718	718
<hr/>		
4207	4342	4404

Gas 490' show
 Gas 1645-1655 No test
 Gas 5082-5083 Show. Not enough to test

Deep Well