

9,740'


LATITUDE 38°27'30"

LONGITUDE 81°25'00"

UTM METERS (NAD83)
N-4255013.16
E-460682.56

LAT.=38°26'33.13"
LONG.=81°27'01.95"

7.5 LOC.

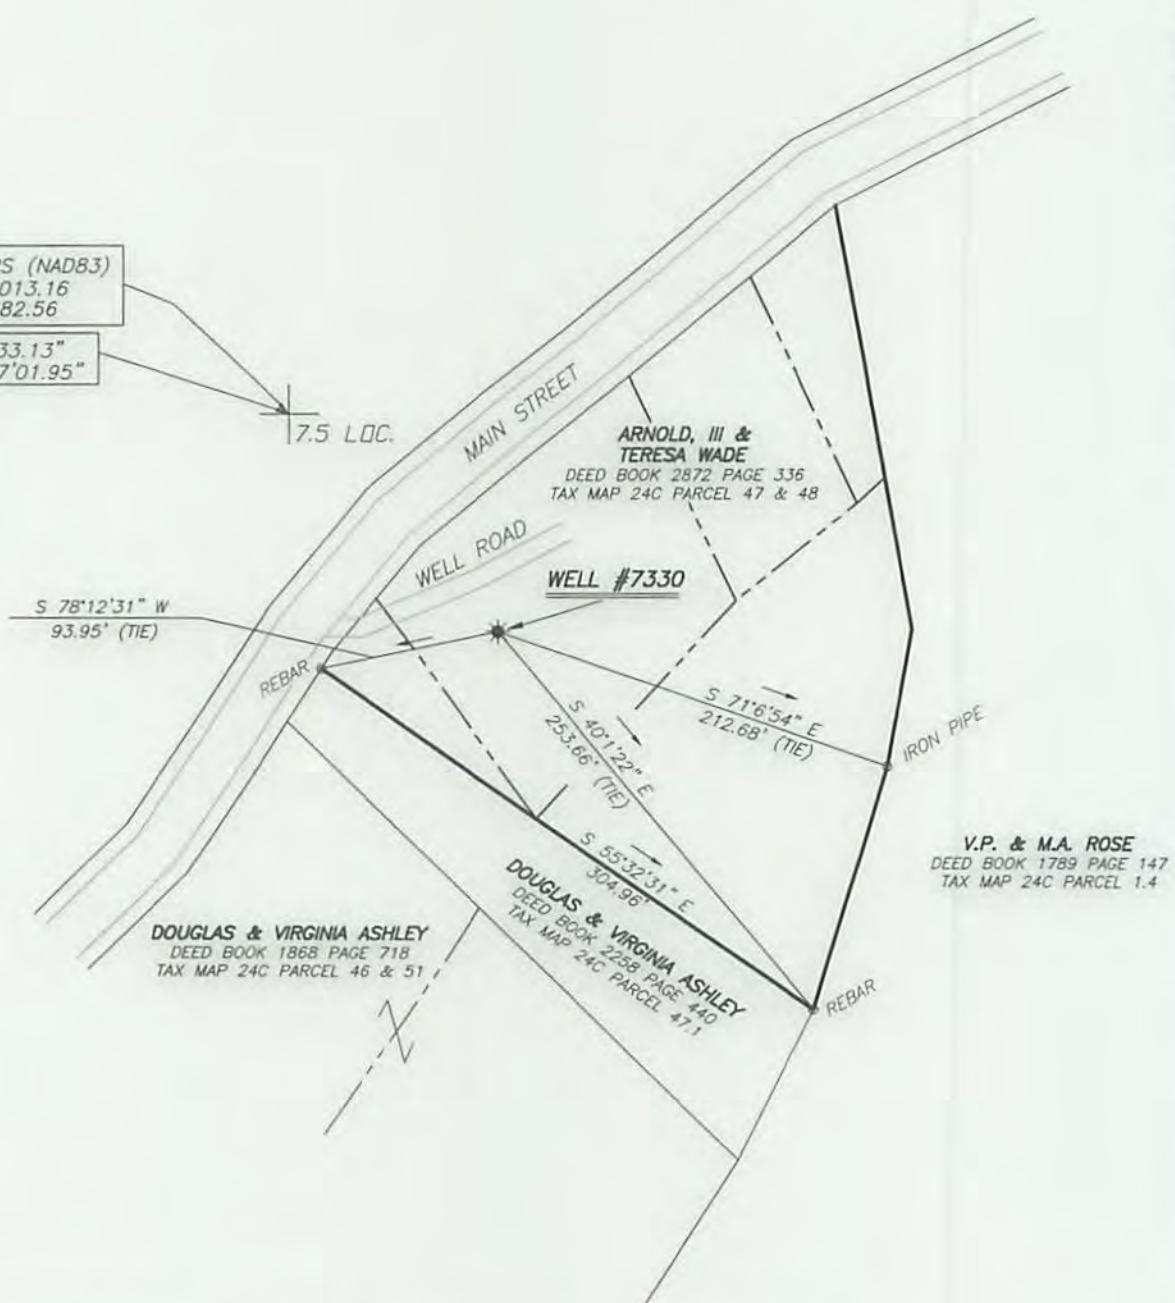

(+) DENOTES LOCATION OF WELL ON UNITED STATES TOPOGRAPHIC MAPS

FILE No 14-100-030
 DRAWING No. 14-100-030
 SCALE 1"=100'
 MINIMUM DEGREE OF ACCURACY 1:200
 PROVEN SOURCE OF ELEVATION TRIMBLE PRO XH GPS UNIT

I THE UNDERSIGNED, HEREBY CERTIFY THAT THIS PLAT IS CORRECT TO THE BEST OF MY KNOWLEDGE AND BELIEF AND SHOWS ALL THE INFORMATION REQUIRED BY LAW AND THE REGULATIONS ISSUED AND PRESCRIBED BY THE DIVISION OF ENVIRONMENTAL PROTECTION.

(SIGNED) *[Signature]*
 RICHARD J. PRINE PS #851



STATE OF WEST VIRGINIA
 DIVISION OF ENVIRONMENTAL PROTECTION
 OFFICE OF OIL AND GAS

NITRO, WV

DATE JANUARY 21 20 15

OPERATOR'S WELL No. 7330

API WELL No. 47 039 -01496 W

WELL TYPE: OIL GAS LIQUID INJECTION WASTE DISPOSAL STATE 47 COUNTY 039 PERMIT -01496 W

(IF "GAS") PRODUCTION STORAGE DEEP SHALLOW

LOCATION: ELEVATION 735 WATER SHED ONE MILE FORK OF BLUE CREEK OF ELK RIVER

DISTRICT ELK COUNTY KANAWHA

QUADRANGLE BLUE CREEK

SURFACE OWNER ARNOLD, III & TERESA WADE ACREAGE 1.42

OIL & GAS ROYALTY OWNER CHLOE COPENHAVER, ET UX LEASE ACREAGE 97

LEASE No. 7425

PROPOSED WORK: DRILL CONVERT DRILL DEEPER REDRILL FRACTURE OR STIMULATE PLUG OFF OLD FORMATION PERFORATE NEW FORMATION OTHER PHYSICAL CHANGE IN WELL (SPECIFY) ACID TREATMENT

PLUG AND ABANDON CLEAN OUT AND REPLUG

TARGET FORMATION ORISKANY ESTIMATED DEPTH 5225

WELL OPERATOR COLUMBIA GAS TRANSMISSION, LLC DESIGNATED AGENT PAUL AMICK

ADDRESS PO BOX 1273, CHARLESTON, WV ADDRESS P.O. BOX 1273, CHARLESTON W.V.

25325-1273 25325-1273

04/24/2015

FORM IV-6 (8-78)



WV DEP Reclamation Plan - Site Detail
 Coco C 7330 Rework

- Elk Estate road to be clear of debris, mud, etc.
- existing access surface material to be maintained
- BMPs to be utilized per WV DEP guidelines



Google earth

Received
 MAR 4 2015
 Office of Oil and Gas
 WV Dept. of Environmental Protection