

(+) DENOTES LOCATION OF WELL ON UNITED STATES TOPOGRAPHIC MAPS


FILE No 1901-2345-001-005
DRAWING No. 1901-2345-001-005
SCALE 1"=400'
MINIMUM DEGREE OF ACCURACY 1:200
PROVEN SOURCE OF ELEVATION TRIMBLE R10 GPS UNIT

I THE UNDERSIGNED, HEREBY CERTIFY THAT THIS PLAT IS CORRECT TO THE BEST OF MY KNOWLEDGE AND BELIEF AND SHOWS ALL THE INFORMATION REQUIRED BY LAW AND THE REGULATIONS ISSUED AND PRESCRIBED BY THE DIVISION OF ENVIRONMENTAL PROTECTION.

(SIGNED)

ROBERT F. THAW

PS #965

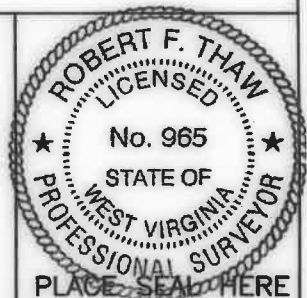

STATE OF WEST VIRGINIA
DIVISION OF ENVIRONMENTAL PROTECTION
OFFICE OF OIL AND GAS
NITRO, WV



DATE FEBRUARY 20 2020
OPERATOR'S WELL No. 7325
API WELL No. 47 039 - 01575W

WELL TYPE: OIL GAS LIQUID INJECTION WASTE DISPOSAL STATE 47 COUNTY 039 PERMIT 01575W
(IF "GAS") PRODUCTION STORAGE DEEP SHALLOW

LOCATION: ELEVATION 899.4' WATER SHED WALNUT CREEK OF THE ELK RIVER
DISTRICT ELK COUNTY KANAWHA
QUADRANGLE BLUE CREEK, WV

SURFACE OWNER COLUMBIA FOREST PRODUCTS INC. ACREAGE 390
OIL & GAS ROYALTY OWNER JAMES F. BROWN LEASE ACREAGE 998

LEASE No. 1002274

PROPOSED WORK: DRILL CONVERT DRILL DEEPER REDRILL FRACTURE
STIMULATE PLUG OFF OLD FORMATION PERFORATE NEW FORMATION OTHER PHYSICAL CHANGE IN WELL (SPECIFY) _____

PLUG AND ABANDON CLEAN OUT AND REPLUG
TARGET FORMATION ORISKANY ESTIMATED DEPTH 5361

WELL OPERATOR COLUMBIA GAS TRANSMISSION, LLC DESIGNATED AGENT JIM AMOS
ADDRESS PO BOX 1273, CHARLESTON, WV ADDRESS 48 COLUMBIA GAS ROAD
25325-1273 SANDYVILLE, WV 25275

FORM IV-6 (8-78)