


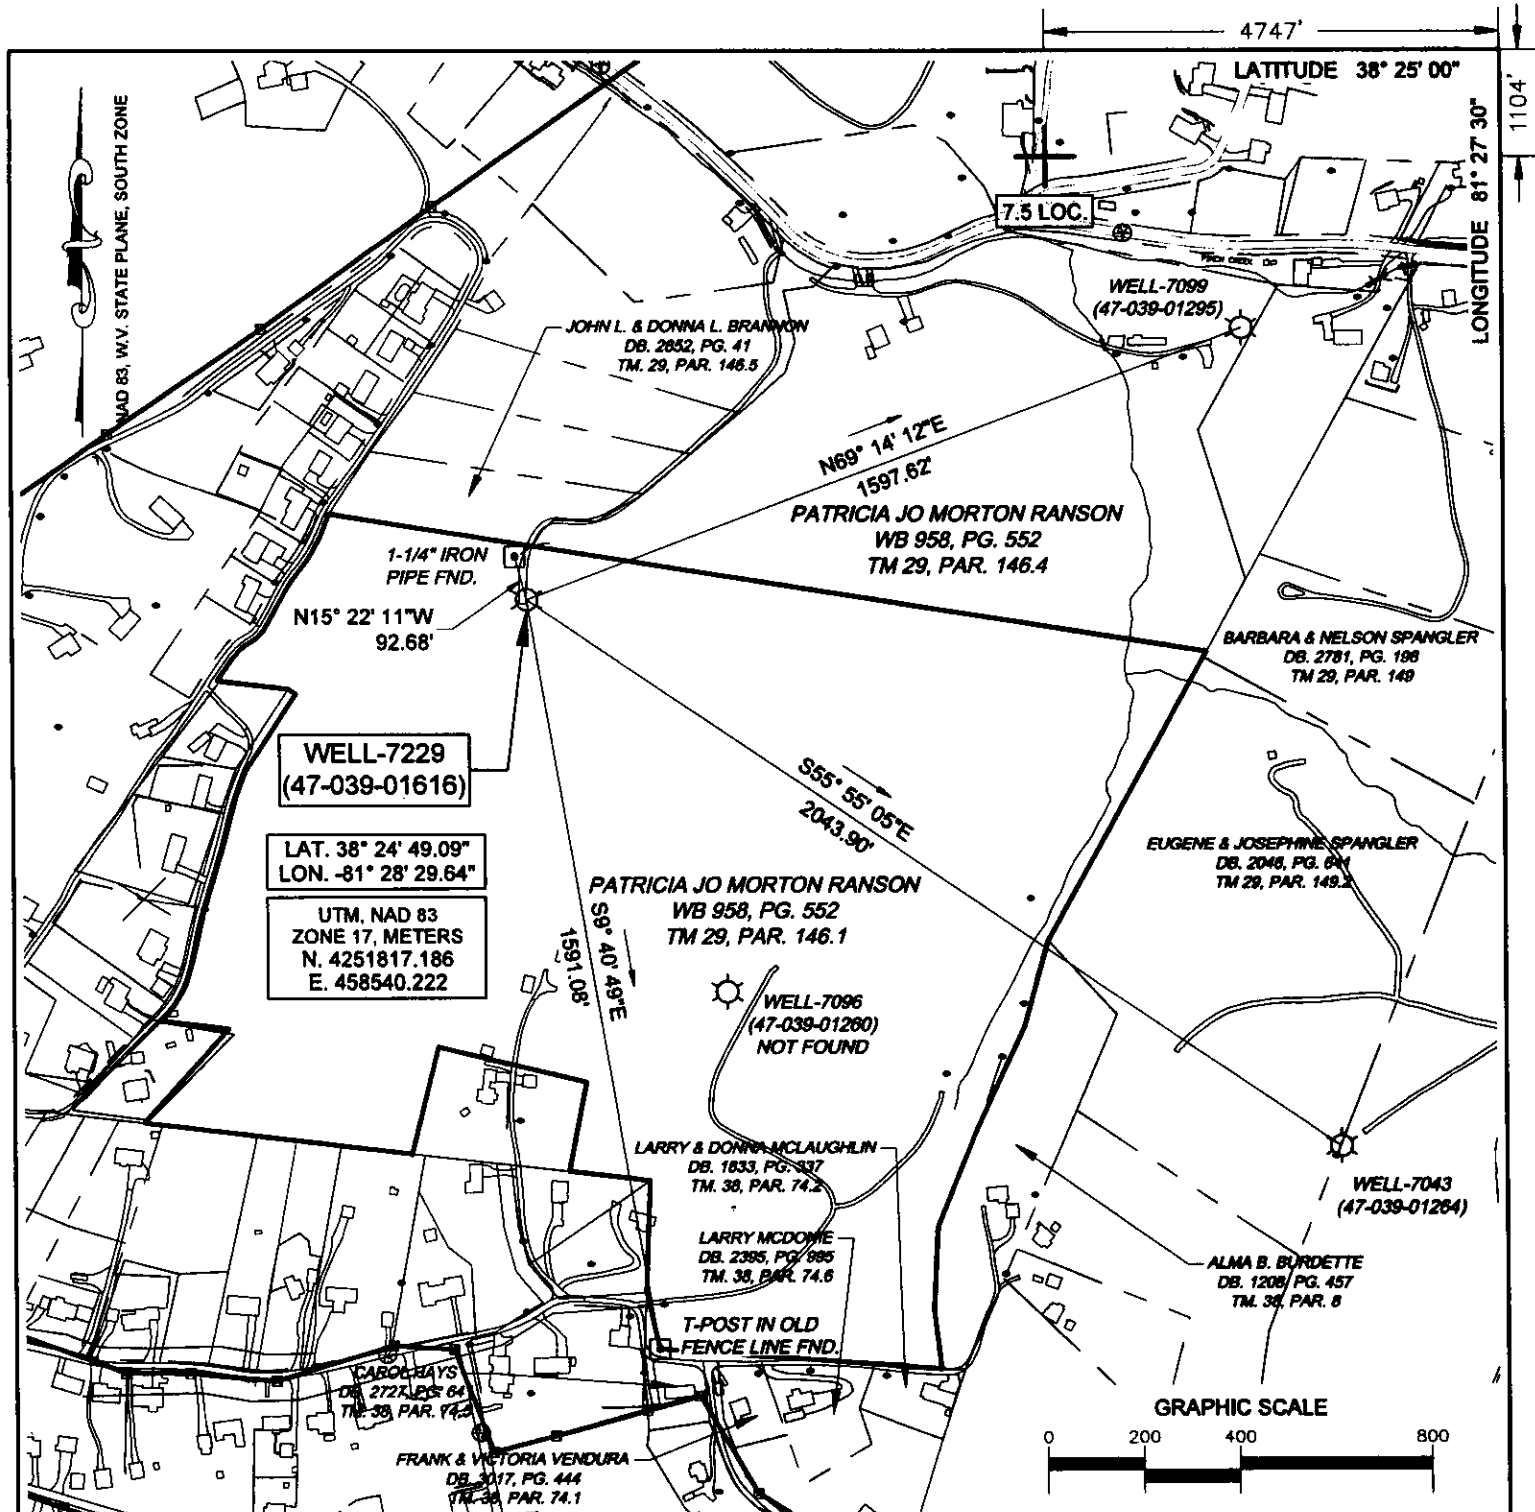

(+) DENOTES LOCATION OF WELL ON UNITED STATES TOPOGRAPHIC MAPS


FILE No 2501-3079-001-002
 DRAWING No. COCO B 7229
 SCALE 1"=400'
 MINIMUM DEGREE OF
 ACCURACY 1:200
 PROVEN SOURCE OF
 ELEVATION TRIMBLE R10
GPS UNIT

I THE UNDERSIGNED, HEREBY CERTIFY THAT
 THIS PLAT IS CORRECT TO THE BEST OF MY
 KNOWLEDGE AND BELIEF AND SHOWS ALL THE
 INFORMATION REQUIRED BY LAW AND THE REGU-
 LATIONS ISSUED AND PRESCRIBED BY THE
 DIVISION OF ENVIRONMENTAL PROTECTION.

(SIGNED)

RICHARD B. HENLINE

PS #1984

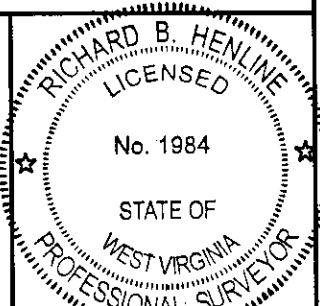

STATE OF WEST VIRGINIA
 DIVISION OF ENVIRONMENTAL PROTECTION
 OFFICE OF OIL AND GAS
 NITRO, WV



DATE AUGUST 5 2026
 OPERATOR'S WELL No. 7229
 API WELL No.

WELL TYPE: OIL ☐ GAS ☒ LIQUID INJECTION ☐ WASTE DISPOSAL ☐ STATE 47 COUNTY 039 PERMIT 01616
 (IF "GAS") PRODUCTION ☐ STORAGE ☒ DEEP ☐ SHALLOW ☐

LOCATION: ELEVATION 757.9' WATER SHED PINCH CREEK
 DISTRICT ELK COUNTY KANAWHA
 QUADRANGLE BLUE CREEK, WV

SURFACE OWNER PATRICIA JO MORTON RANSON ACREAGE 18.56
 OIL & GAS ROYALTY OWNER LUCILLE JARRETT, ET AL

LEASE ACREAGE 62.2 LEASE NO. 1049098-000

PROPOSED WORK: DRILL ☐ CONVERT ☐ DRILL DEEPER ☐ REDRILL ☐ FRACTURE ☐
 STIMULATE ☒ PLUG OFF OLD FORMATION ☐ PERFORATE NEW FORMATION ☐
 OTHER PHYSICAL CHANGE IN WELL (SPECIFY) _____
 PLUG AND ABANDON ☐ CLEAN OUT AND REPLUG ☐

TARGET FORMATION ORISKANY ESTIMATED DEPTH 5157
 WELL OPERATOR COLUMBIA GAS TRANSMISSION, LLC DESIGNATED AGENT MARIA MEDVEDEVA
 ADDRESS PO BOX 1273, CHARLESTON, WV ADDRESS 1700 MACCORKLE AVE., S.E.
25325-1273 CHARLESTON, WV 25314

(ROMANCE)



081° 28' 21.4278" W
038° 25' 01.6223" N

(KETTLE)

BLUE CREEK QUADRANGLE
WEST VIRGINIA
TOPOGRAPHIC SERIES

(CLIO)

081° 26' 03.0615" W
038° 25' 01.6223" N

(BIG CHIMNEY)

(CLEDENIN)

SEP 08 2026

(MAMMOTH)

(CHARLESTON
EAST)

Produced by Trimble Terrain Navigator Pro
Topography based on USGS 1:24,000
Maps

North American 1983 Datum (NAD83)


To place on the predicted North American
1927 move the projection lines 11M N and
14M E

Declination



GN 0.28° W
MN 7.88° W

SCALE 1:24000

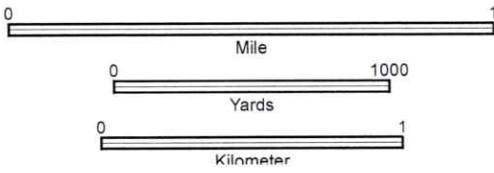

CONTOUR INTERVAL 20 FT

38081-D3-TM-024
BLUE CREEK, WV
JAN 1, 1977

09/25/2026