

WW-7  
8-30-06



West Virginia Department of Environmental Protection  
Office of Oil and Gas  
**WELL LOCATION FORM: GPS**

API: 47-039-01826 WELL NO.: WV 127511 (Hardy A-5-1360)

FARM NAME: Waller C. Hardy, Jr., et al.

RESPONSIBLE PARTY NAME: EQT Production Company

COUNTY: Kanawha DISTRICT: Loudon

QUADRANGLE: Charleston West 7.5'

SURFACE OWNER: WV DNR, Kanawha State Forest

ROYALTY OWNER: Hardy Oil & Gas LLC, et al.

UTM GPS NORTHING: 4237064

UTM GPS EASTING: 442913 GPS ELEVATION: 222 m (727 ft)

The Responsible Party named above has chosen to submit GPS coordinates in lieu of preparing a new well location plat for a plugging permit or assigned API number on the above well. The Office of Oil and Gas will not accept GPS coordinates that do not meet the following requirements:

1. Datum: NAD 1983, Zone: 17 North, Coordinate Units: meters, Altitude: height above mean sea level (MSL) – meters.
2. Accuracy to Datum – 3.05 meters
3. Data Collection Method:  
Survey grade GPS     : Post Processed Differential       
Real-Time Differential       
Mapping Grade GPS X: Post Processed Differential X  
Real-Time Differential

4. **Letter size copy of the topography map showing the well location.**

I the undersigned, hereby certify this data is correct to the best of my knowledge and belief and shows all the information required by law and the regulations issued and prescribed by the Office of Oil and Gas.

*Stacy Osborn*  
Signature

PS# 2180  
Title

9/30/15  
Date

Topo Quad: Charleston West 7.5'

Scale: 1" = 2000'

County: Kanawha

Date: September 14, 2015


District: Loudon

Project No: 52-14-00-07

Water

# 47-039-01826 WV 127511 (Hardy A-5-1360)

No Potential Water Sources within 1000'

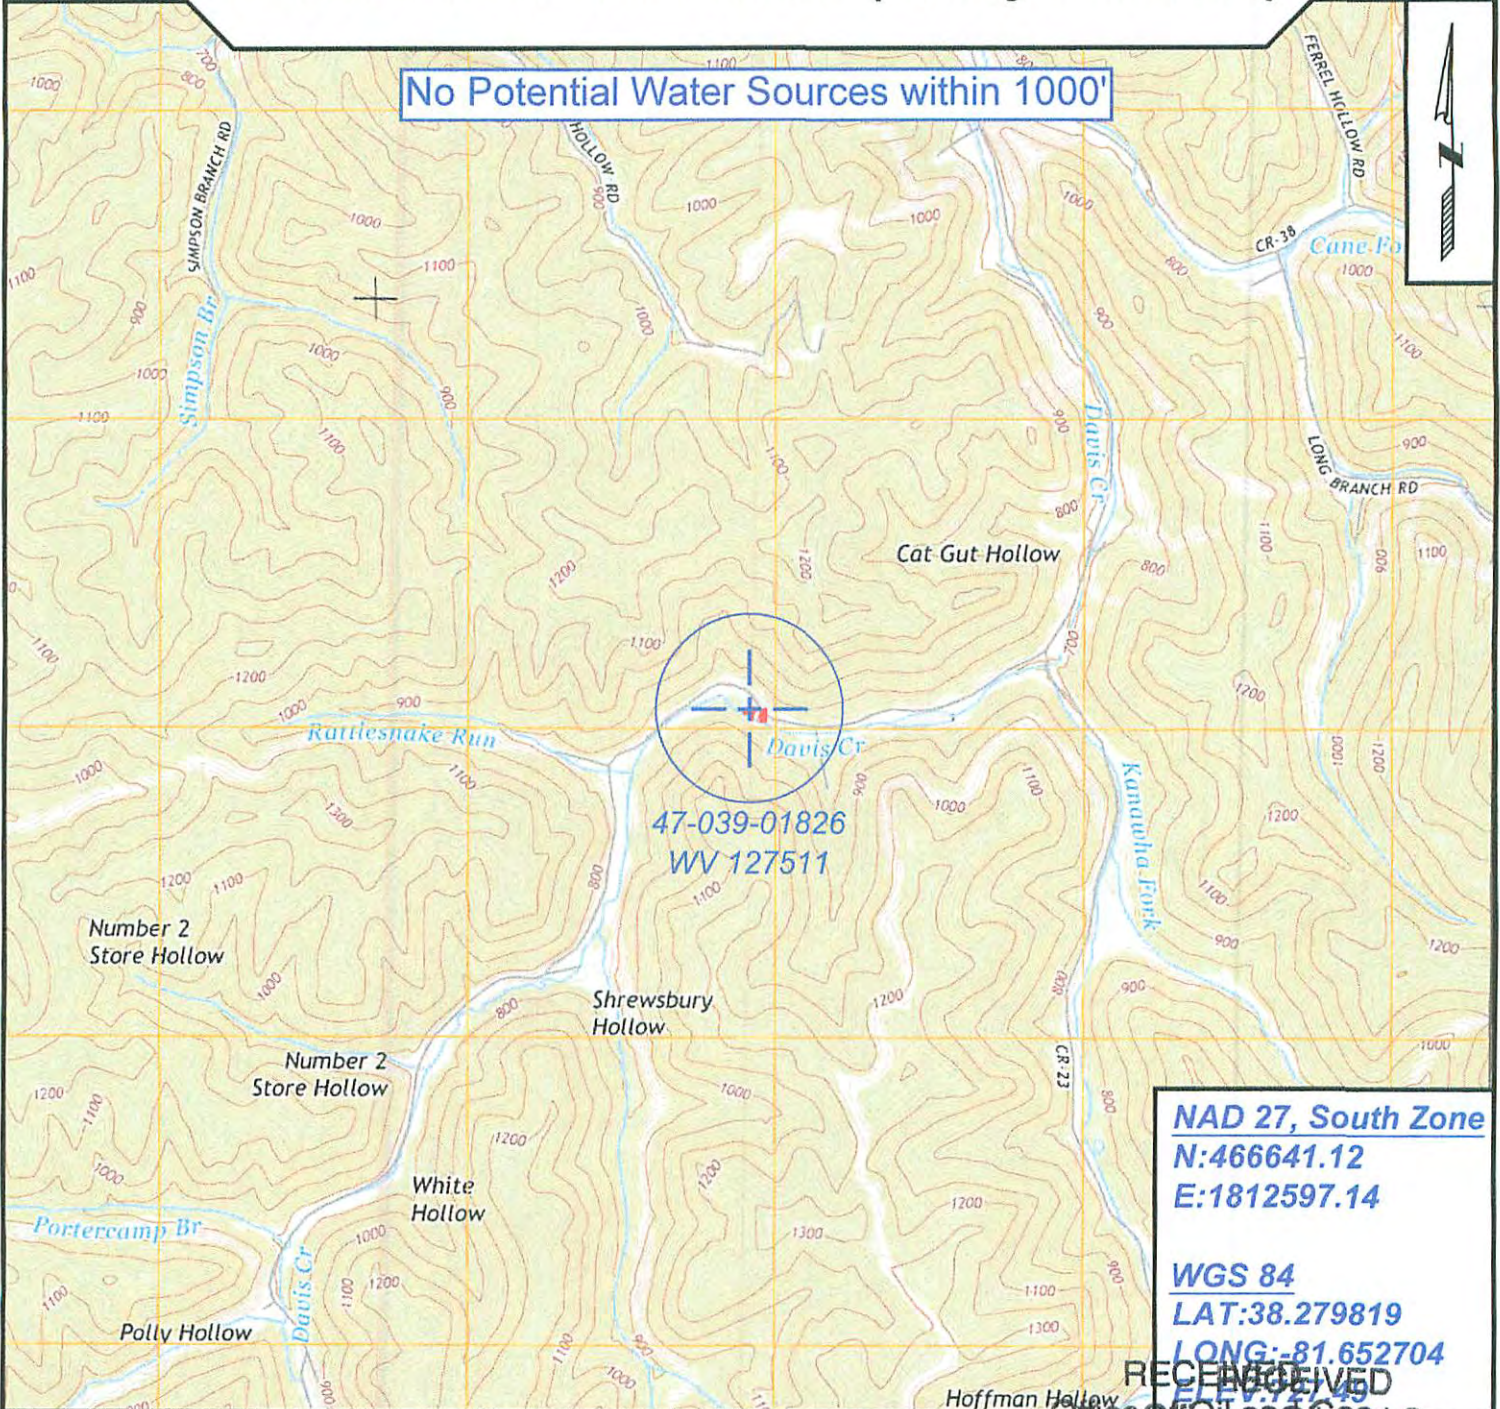

47-039-01826  
WV 127511

**NAD 27, South Zone**  
N:466641.12  
E:1812597.14

**WGS 84**  
LAT:38.279819  
LONG:-81.652704

RECEIVED  
Office of Oil and Gas



SURVEYING AND MAPPING SERVICES PERFORMED BY:

**ALLEGHENY SURVEYS, INC.**

1-800-482-8606  
237 Birch River Road  
Birch River, WV 26610  
PH: (304) 649-8606  
FAX: (304) 649-8608

PREPARED FOR:

**EQT Production Company**

RECEIVED  
Office of Oil and Gas  
DCT 8 2015  
P.O. Box 280  
WV Dept of Environmental Protection  
Environmental 4/20/2015