

WW-7  
8-30-06



West Virginia Department of Environmental Protection  
Office of Oil and Gas  
**WELL LOCATION FORM: GPS**

API: 47-39-01942 WELL NO.: 4 A

FARM NAME: Blue Creek Land and Coal Co.

RESPONSIBLE PARTY NAME: Steve Rubin - Blue Creek Gas Company

COUNTY: Kanawha DISTRICT: Elk

QUADRANGLE: Clerden

SURFACE OWNER: Union Carbide Co.

ROYALTY OWNER: Union Carbide Co.

UTM GPS NORTHING: 4243663

UTM GPS EASTING: 465233 GPS ELEVATION: 1080

The Responsible Party named above has chosen to submit GPS coordinates in lieu of preparing a new well location plat for a plugging permit or assigned API number on the above well. The Office of Oil and Gas will not accept GPS coordinates that do not meet the following requirements:

1. Datum: NAD 1983, Zone: 17 North, Coordinate Units: meters, Altitude: height above mean sea level (MSL) - meters.
2. Accuracy to Datum - 3.05 meters
3. Data Collection Method:

Survey grade GPS : Post Processed Differential

Real-Time Differential

Mapping Grade GPS : Post Processed Differential

Real-Time Differential

4. Letter size copy of the topography map showing the well location. I the undersigned, hereby certify this data is correct to the best of my knowledge and belief and shows all the information required by law and the regulations issued and prescribed by the Office of Oil and Gas.

Steve Rubin  
Signature

Contractor  
Title


2-26-16  
Date

Office of Oil and Gas  
West Virginia Department of Environmental Protection

03/11/2016



39-01942

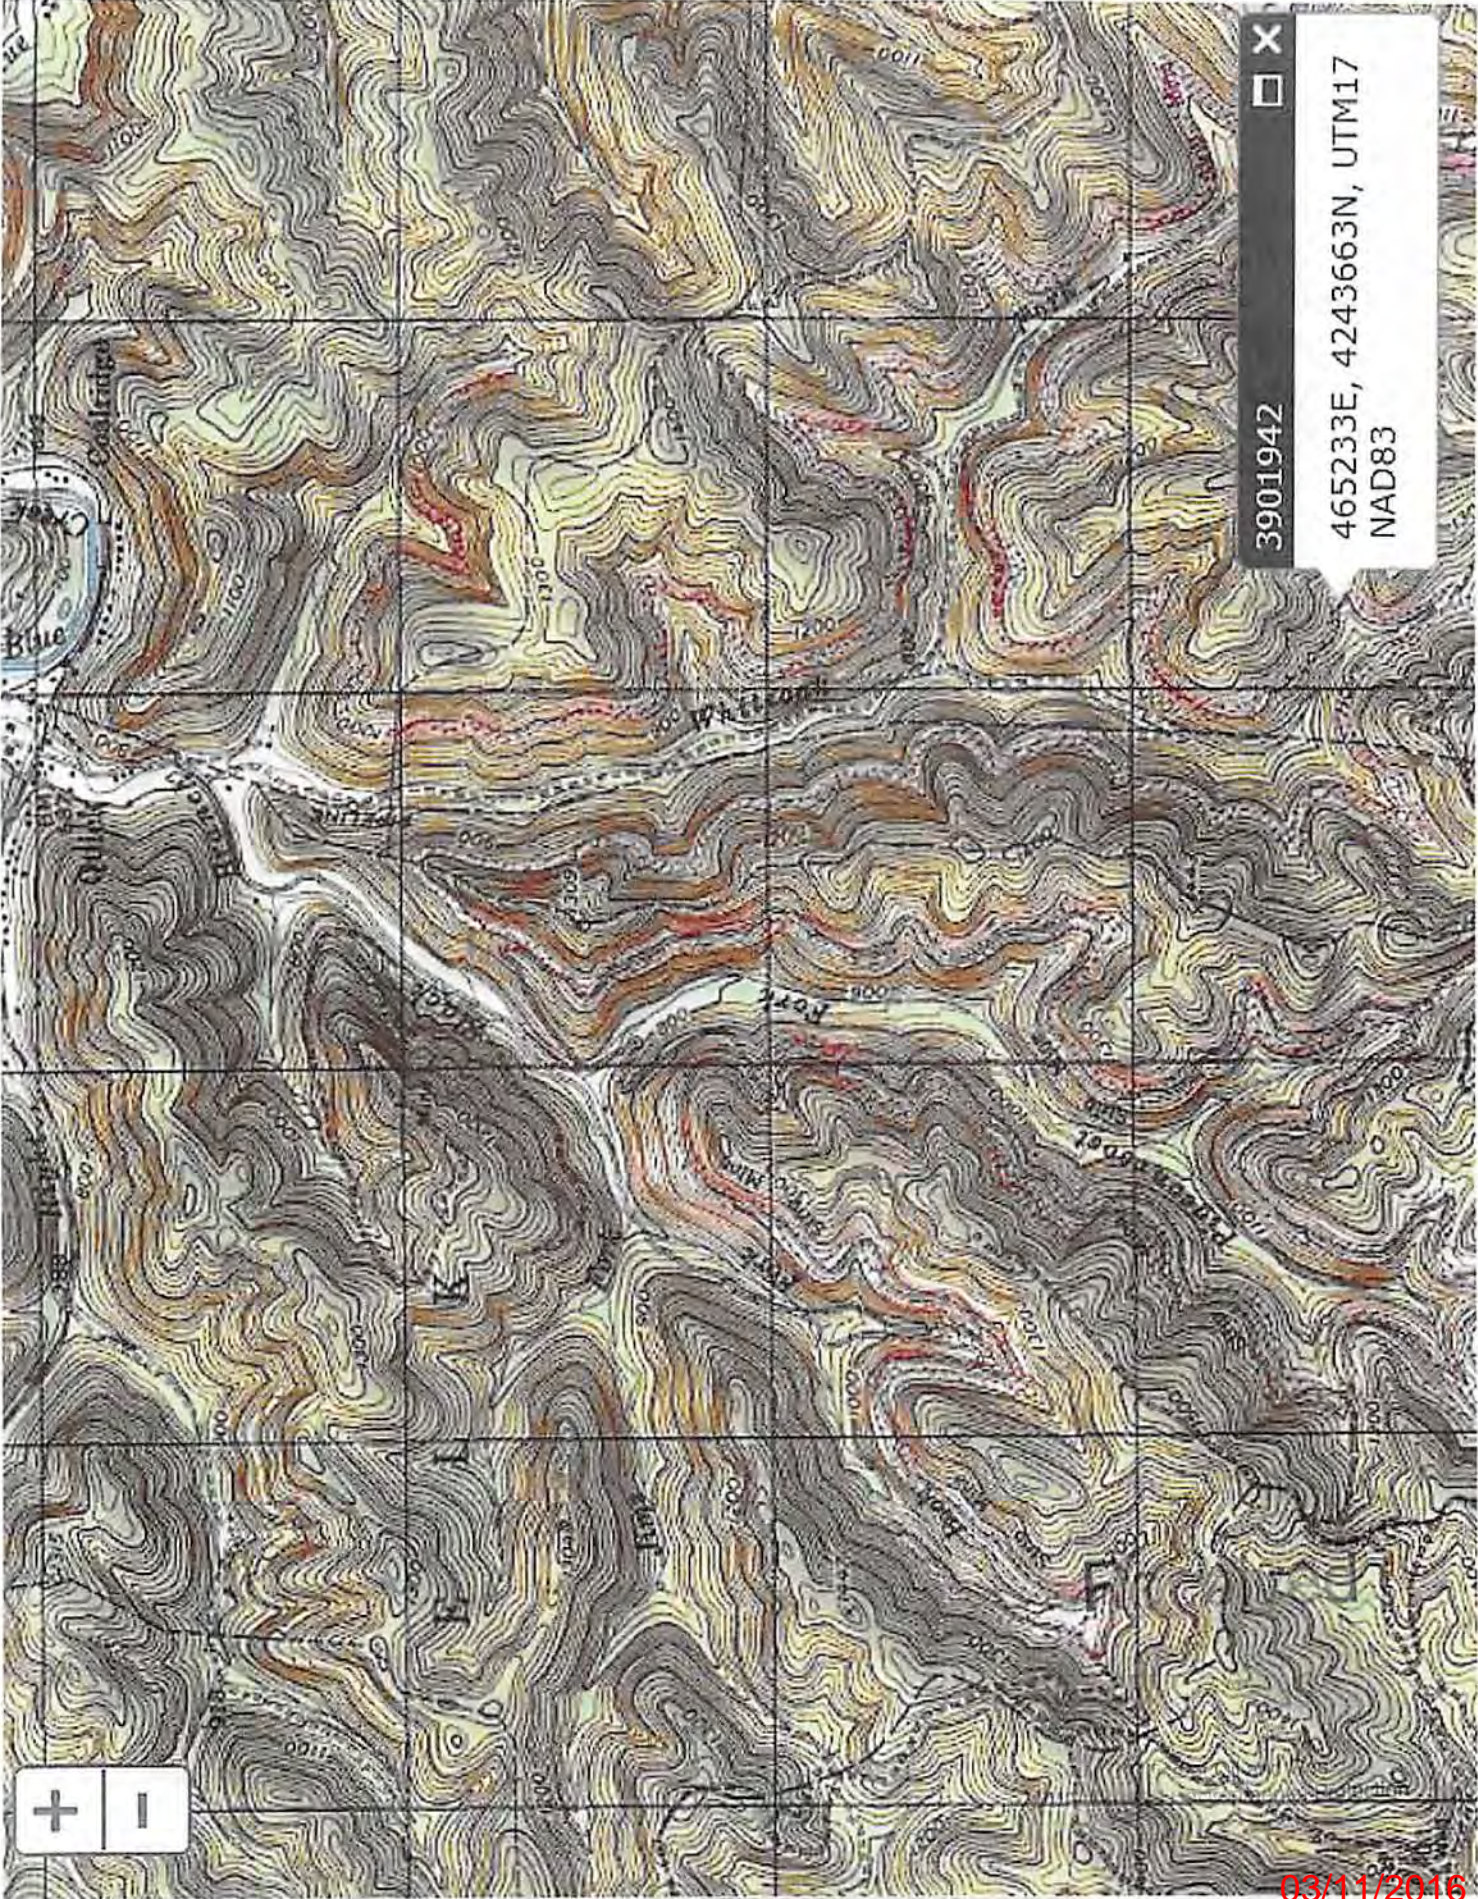

3901942

465233E, 4243663N, UTM17  
NAD83

03/11/2016