

39 01963 P

WW-7
8-30-06



West Virginia Department of Environmental Protection
Office of Oil and Gas
WELL LOCATION FORM: GPS

API: 47-039-01963 WELL NO.: WV 127561 (Hardy A-11)

FARM NAME: Hardy

RESPONSIBLE PARTY NAME: EQT Production Company

COUNTY: Kanawha DISTRICT: Washington

QUADRANGLE: Racine 7.5'

SURFACE OWNER: Waller & Charlotte Hardy

ROYALTY OWNER: Columbian Carbon Company

UTM GPS NORTHING: 4231352

UTM GPS EASTING: 442496 GPS ELEVATION: 324 m (1063 ft)

The Responsible Party named above has chosen to submit GPS coordinates in lieu of preparing a new well location plat for a plugging permit or assigned API number on the above well. The Office of Oil and Gas will not accept GPS coordinates that do not meet the following requirements:

1. Datum: NAD 1983, Zone: 17 North, Coordinate Units: meters, Altitude: height above mean sea level (MSL) – meters.
2. Accuracy to Datum – 3.05 meters
3. Data Collection Method:

Survey grade GPS : Post Processed Differential
Real-Time Differential

Mapping Grade GPS : Post Processed Differential
Real-Time Differential

4. Letter size copy of the topography map showing the well location.

I the undersigned, hereby certify this data is correct to the best of my knowledge and belief and shows all the information required by law and the regulations issued and prescribed by the Office of Oil and Gas.

Received

AUG 19 2013

Office of Oil and Gas
WV Dept. of Environmental Protection

[Signature]
Signature

Professional Surveyor #2180
Title

7/26/13
Date

3901963A

Topo Quad: Racine 7.5'

Scale: 1" = 2000'

County: Kanawha


Date: June 10, 2013

District: Washington

Project No: 52-14-00-07

Hardy A-11 WV 127561 (47-039-01963)

Topo

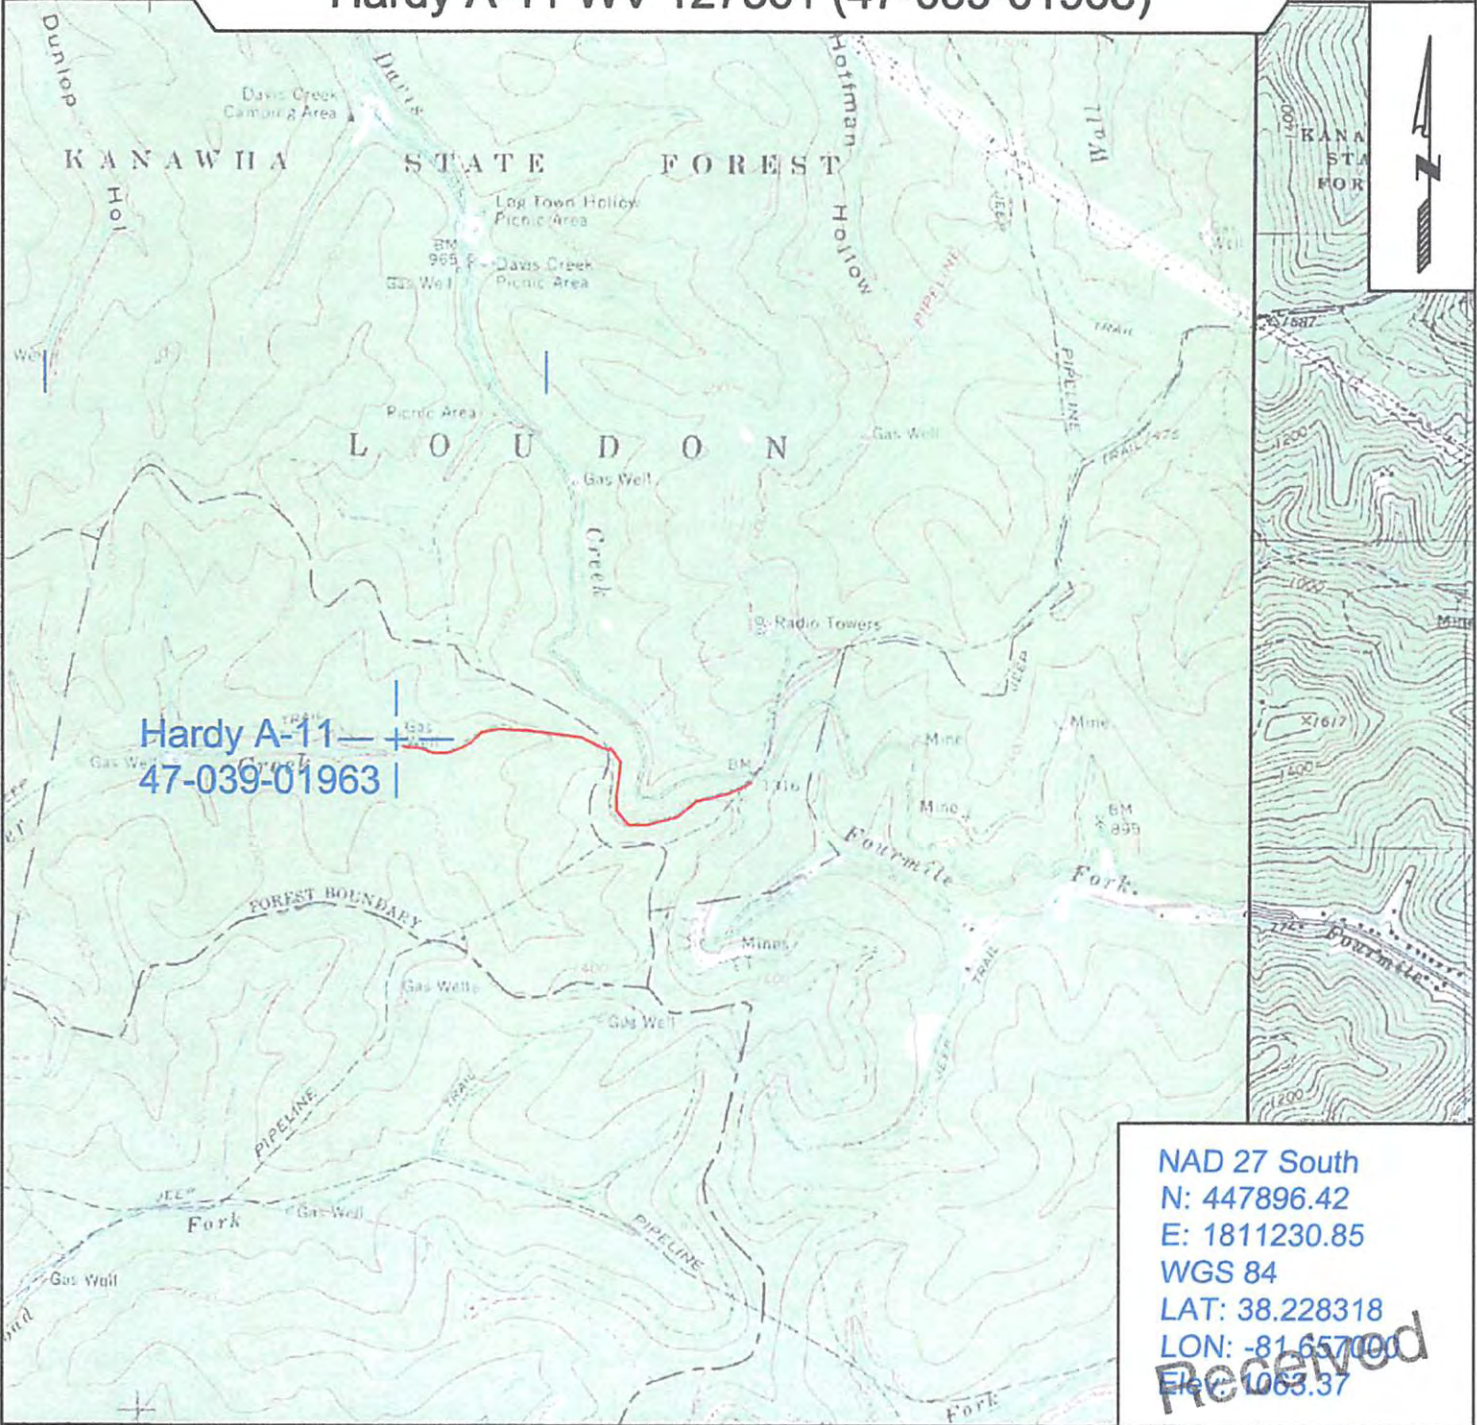

Hardy A-11
47-039-01963

NAD 27 South
 N: 447896.42
 E: 1811230.85
 WGS 84
 LAT: 38.228318
 LON: -81.657000
 Elev: 1063.37



SURVEYING AND MAPPING SERVICES PERFORMED BY:
ALLEGHENY SURVEYS, INC.
 1-800-482-8606
 P.O. BOX 438
 BIRCH RIVER, WV 26610
 PH: (304) 649-8606
 FAX: (304) 649-8608

PREPARED FOR:
EQT Production Company
 P.O. Box 280
 Bridgeport, WV 26330
 Office of Oil and Gas
 WV Dept. of Environmental Protection

AUG 19 2013

Received