

Minimum Error of Closure 1" IN 200  
 Source of Elevation FORK ROAD S.W. 678.00

Fracture.....  
 New Location.....  
 Drill Deeper.....  
 Abandonment..... 9-20-67

I, the undersigned, hereby certify that this map is correct to the best of my knowledge and belief and shows all the information required by paragraph 6 of the rules and regulations of the oil and gas section of the mining laws of West Virginia.

Signed: L. J. Dye  
 Squares: N S E W

Map No.

Company ALLEN BEARD  
 Address SPENCER, W.VA  
 Farm L. CREWS  
 Tract \_\_\_\_\_ Acres 88 Lease No. \_\_\_\_\_  
 Well (Farm) No. 1 Serial No. \_\_\_\_\_  
 Elevation (Spirit Level) 721.59  
 Quadrangle CHARLESTON NC  
 County KANAWHA District UNION  
 Engineer L. J. Dye  
 Engineer's Registration No. 804  
 File No. \_\_\_\_\_ Drawing No. \_\_\_\_\_  
 Date 8-2-67 Scale 1" = 500'

STATE OF WEST VIRGINIA  
 DEPARTMENT OF MINES  
 OIL AND GAS DIVISION  
 CHARLESTON

**WELL LOCATION MAP**

FILE NO. KAN-2156-P

+ Denotes location of well on United States Topographic Maps, scale 1 to 62,500, latitude and longitude lines being represented by border lines as shown.

- Denotes one inch spaces on border line of original tracing.



STATE OF WEST VIRGINIA  
DEPARTMENT OF MINES  
OIL AND GAS DIVISION

- Rotary
- Spudder
- Cable Tools
- Storage

WELL RECORD

Oil or Gas Well Dry  
(KIND)

Quadrangle \_\_\_\_\_  
Permit No. KAN-2156


Company Allen Beard dba Big "B" Gas Co.  
Address 115 Court Street, Ripley, W. Va.  
Farm L. Crews Acres 89  
Location (waters) \_\_\_\_\_  
Well No. 1 Elev. 721.59  
District Union County Kanawha  
The surface of tract is owned in fee by Lillian Crews  
Address Charleston, W. Va.  
Mineral rights are owned by Lillian Crews  
Address Charleston, W. Va.  
Drilling commenced September 1, 1967  
Drilling completed September 20, 1967  
Date Shot \_\_\_\_\_ From \_\_\_\_\_ To \_\_\_\_\_

Casing and Tubing	Used in Drilling	Left in Well	Packers
Size			Kind of Packer
16			
13 3/8"	72'	72'	
9 5/8"	1923'		Size of
8 1/4"			
7"	5049'	1000'	Depth set
5 3/16"			
4 1/2"			
3			Perf. top
2			Perf. bottom
Liners Used			Perf. top
			Perf. bottom

Attach copy of cementing record.  
CASING CEMENTED \_\_\_\_\_ SIZE \_\_\_\_\_ No. Ft. \_\_\_\_\_ Date \_\_\_\_\_  
Amount of cement used (bags) \_\_\_\_\_  
Name of Service Co. \_\_\_\_\_  
COAL WAS ENCOUNTERED AT \_\_\_\_\_ FEET \_\_\_\_\_ INCHES  
\_\_\_\_\_ FEET \_\_\_\_\_ INCHES \_\_\_\_\_ FEET \_\_\_\_\_ INCHES  
\_\_\_\_\_ FEET \_\_\_\_\_ INCHES \_\_\_\_\_ FEET \_\_\_\_\_ INCHES

With \_\_\_\_\_  
Open Flow \_\_\_\_\_ /10ths Water in \_\_\_\_\_ Inch  
\_\_\_\_\_ /10ths Merc. in \_\_\_\_\_ Inch  
Volume \_\_\_\_\_ Cu. Ft.  
Rock Pressure \_\_\_\_\_ lbs. \_\_\_\_\_ hrs.  
Oil \_\_\_\_\_ bbls., 1st 24 hrs.  
WELL ACIDIZED (DETAILS) No  
WELL FRACTURED (DETAILS) No  
RESULT AFTER TREATMENT (Initial open Flow or bbls.) \_\_\_\_\_  
ROCK PRESSURE AFTER TREATMENT \_\_\_\_\_ HOURS  
Fresh Water \_\_\_\_\_ Feet \_\_\_\_\_ Salt Water \_\_\_\_\_ Feet \_\_\_\_\_  
Producing Sand \_\_\_\_\_ Depth \_\_\_\_\_

Formation	Color	Hard or Soft	Top	Bottom	Oil, Gas or Water	Depth	Remarks
Sub Soil			0	20			
Sandstone & Lime			20	50			
Red Rock			50	56			
Shale-Lime Stringers			56	90	Water	77'	
Sandy Lime			90	111			
Shale w/ limestringers			111	1390			
Salt Sand			1390	1560			
Big Lime			1560	1777			
Keener Sand			1777	1805			
Injun Sand			1805	1882			
Shale			1882	4825			
Corniferous Lime			4825	4921			
Oriskany Sand			4921	4959	Salt Water	4936'	
Lime & Dolomite			4959	5659	Sulphur Gas	5148'	
Newburg Sand			5659	5670			
Limestone			5670	5700			
Total Depth				5700'			

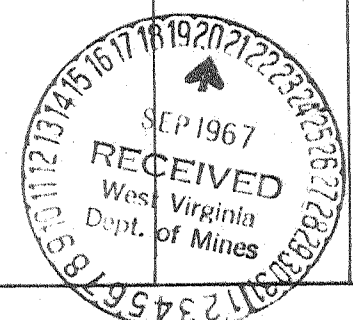

057 8 1967