


Latitude 38° 35'

Longitude 81° 35'

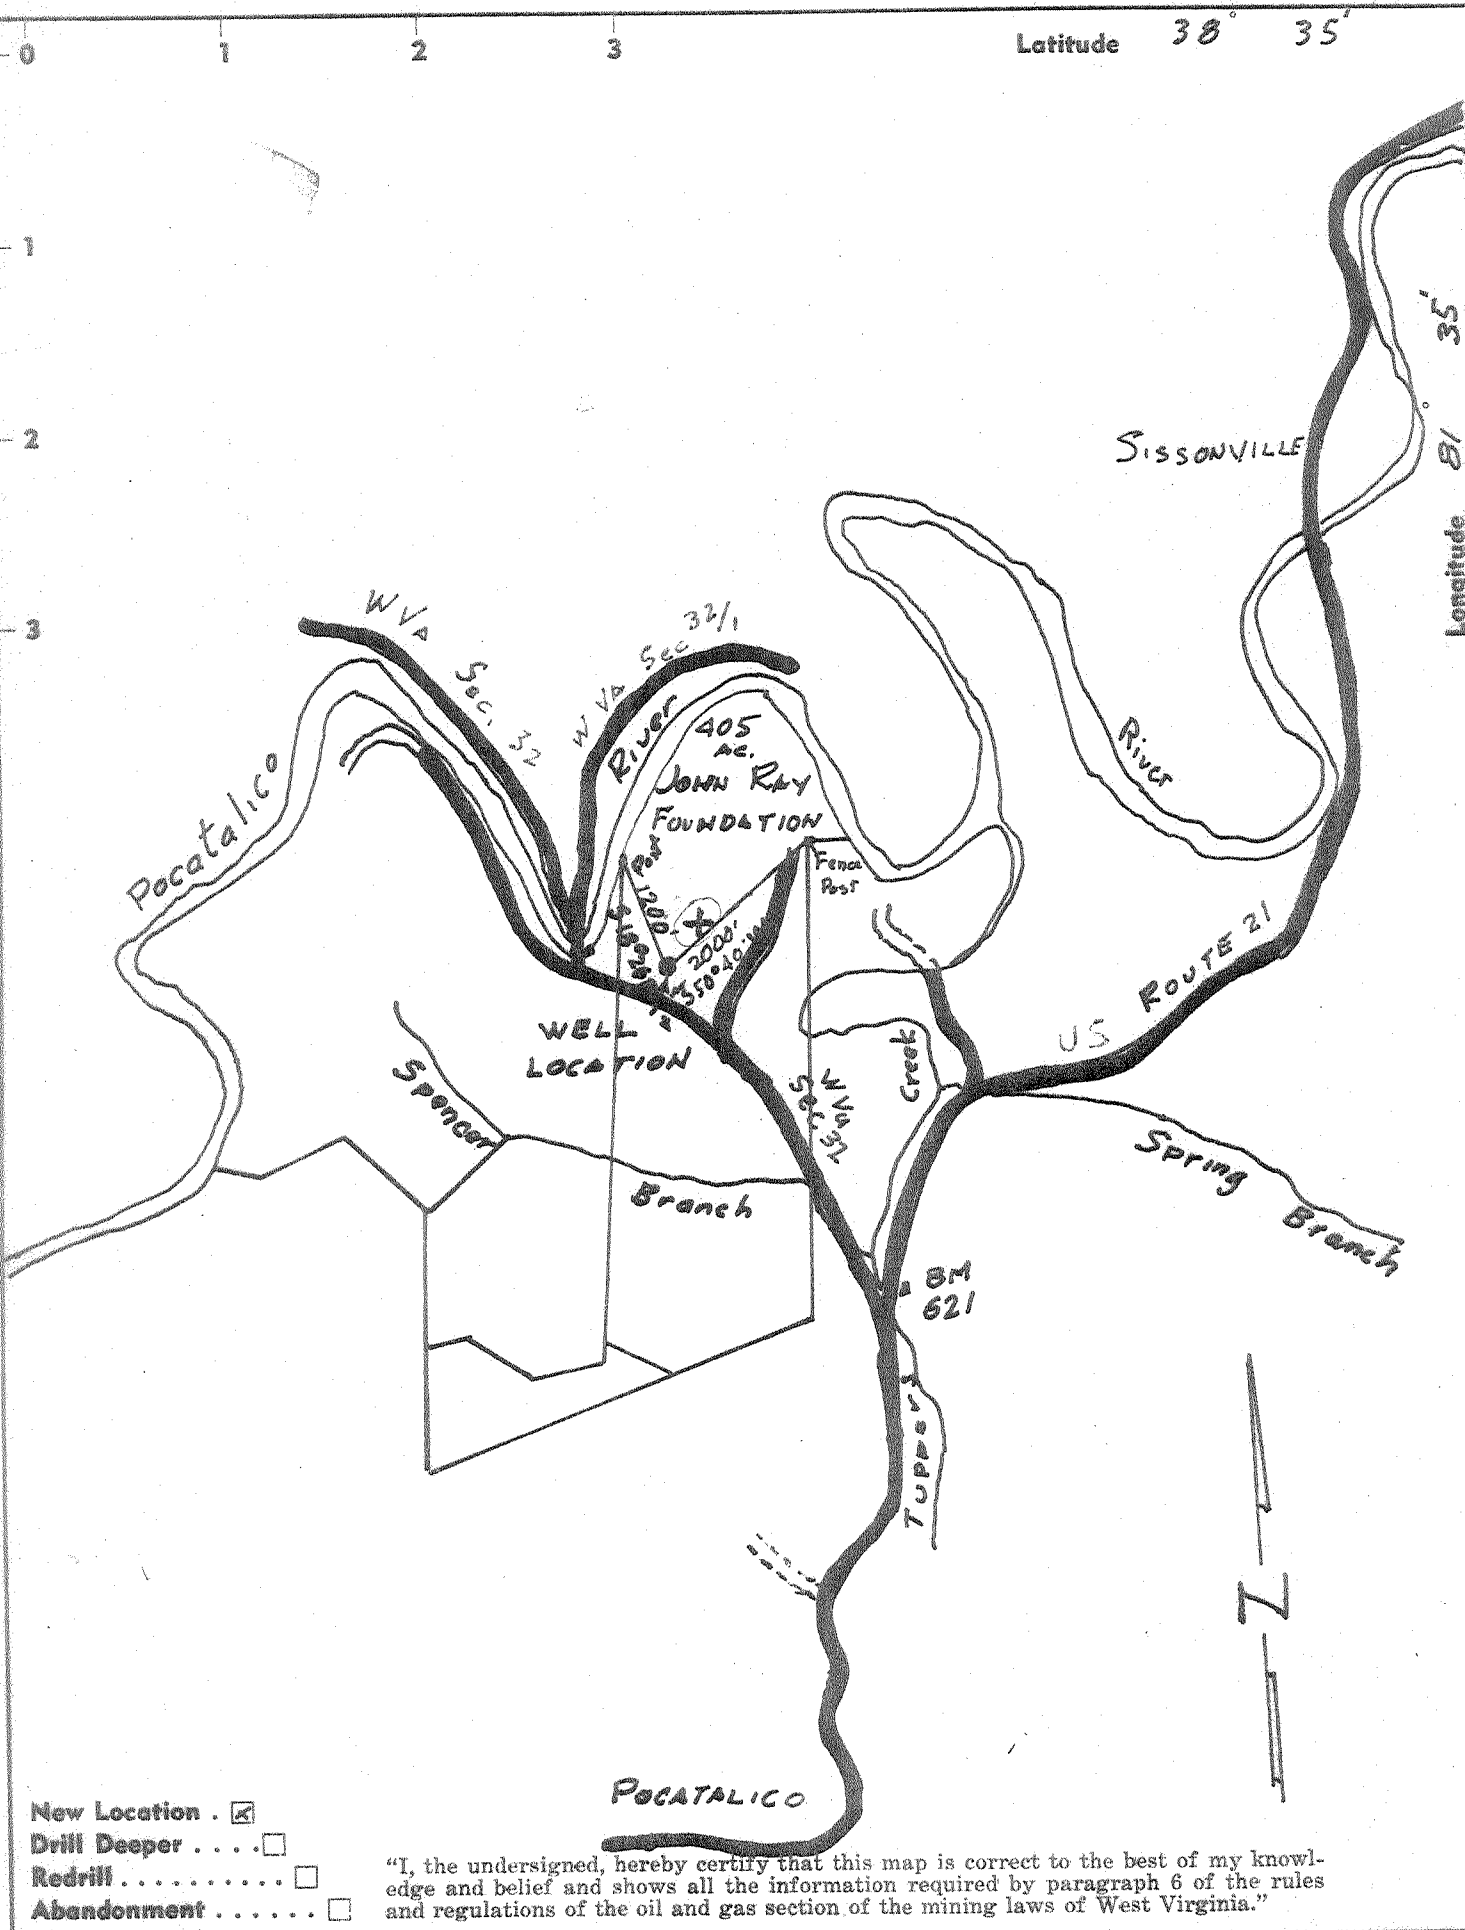

- New Location
- Drill Deeper
- Redrill
- Abandonment

"I, the undersigned, hereby certify that this map is correct to the best of my knowledge and belief and shows all the information required by paragraph 6 of the rules and regulations of the oil and gas section of the mining laws of West Virginia."

Company GUS BERRY  
 Address 1490 Callie Rd. Charleston W.Va.  
 Farm JOHN RAY  
 Tract \_\_\_\_\_ Acres 405 Lease No. \_\_\_\_\_  
 Well (Farm) No. Ray No 2 Serial No. \_\_\_\_\_  
 Elevation (Spirit Level) 638.72  
 Quadrangle KENNA SP  
 County KANAWHA District POCA  
 Engineer Carl S. Berry  
 Engineer's Registration No. 1530  
 File No. S 408 Drawing No. K  
 Date JUNE 11 1968 Scale 1" = 2000'

STATE OF WEST VIRGINIA  
 DEPARTMENT OF MINES  
 OIL AND GAS DIVISION  
 CHARLESTON  
**WELL LOCATION MAP**  
 FILE NO. KAN-2268

+ Denotes location of well on United States Topographic Maps, scale 1 to 62,500, latitude and longitude lines being represented by border lines as shown.  
 - Denotes one inch spaces on border line of original tracing.

*Deep Well (Newburg)*