

Latitude 38° 30'

Longitude 81° 35'

- Fracture Before 6/5/29
- New Location
- Drill Deeper
- Redrill
- Abandonment

I, the undersigned, hereby certify that this map is correct to the best of my knowledge and belief and shows all the information required by Paragraph 5 of the Rules and Regulations of the Oil and Gas Section of the Mining Laws of West Virginia.
 The accuracy of this survey is within the limits and as prescribed in paragraph 5 by the Oil and Gas Division of the Department of Mines Regulations.
PROVEN ELEVATION 653.70'

Company UNITED FUEL GAS CO.
 Address CHARLESTON W.VA.
 Farm CECIL BOGGESS, ET. AL.
 Tract _____ Acres 300.54 Lease No. 62475 ETAL
 Well (Farm) No. _____ Serial No. 9491 P.I.
 Elevation (Spirit Level) 637.84'
 Quadrangle CHARLESTON NC
 County KANAWHA District POCA
 Engineer Adrian E. Hardman
 Engineer's Registration No. 2330
 File No. 60-69 Drawing No. _____
 Date JUNE 11, 1968 Scale 1" = 400'

STATE OF WEST VIRGINIA
 DEPARTMENT OF MINES
 OIL AND GAS DIVISION
 CHARLESTON

WELL LOCATION MAP
 FILE NO. KAN-2276

+ Denotes location of well on United States Topographic Maps, scale 1 to 62,500 latitude and longitude lines being represented by border lines as shown.

- Denotes one inch spaces on border line of original tracing.

Ashland O.R. - 10.5576%
 Commonwealth - 13.8035%
 A.L.D. - 9.1502%

Form OG-10



Map Square 60-69

STATE OF WEST VIRGINIA
 DEPARTMENT OF MINES
 OIL AND GAS DIVISION

Rotary
 Spudder
 Cable Tools
 Storage

Quadrangle Charleston
 Permit No. Kan-2276

WELL RECORD

Oil or Gas Well GAS (KIND)

Company United Fuel Gas Company
 Address P.O. Box 1273, Charleston, W. Va.
 Farm Cecil Bogges et al. Acres 300.54
 Location (waters) Happy Hol. of Tupper Creek 849.84' KB
 Well No. 9491 P.1. Elev. 837.84'
 District Union Bocha County Kanawha
 The surface of tract is owned in fee by _____
 Address _____
 Mineral rights are owned by _____
 Address _____
 Drilling commenced June 29, 1968
 Drilling completed July 8, 1968
 Date Shot From _____ To _____
 With _____

Casing and Tubing	Used in Drilling	Left in Well	Packers
Size			Kind of Packer
16			
13 3/8"	250'	250'	Size of
9 5/8"	1924'	1924'	Depth set
8 1/4"			
8 3/4"	5721'	5721'	Perf. top
5 3/16"			Perf. bottom
4 1/2"			Perf. top
3"			Perf. bottom
2 3/8"	5825'	5825'	
Liners Used			


Open Flow /10ths Water in _____ Inch
 /10ths Merc. in _____ Inch
 Volume _____ Cu. Ft.
 Rock Pressure _____ lbs. _____ hrs.
 Oil _____ bbls., 1st 24 hrs.

Attach copy of cementing record.
 CASING CEMENTED _____ SIZE _____ No. Ft. _____
 Amount of cement used (bags) _____
 Name of Service Co. _____
 COAL WAS ENCOUNTERED AT _____ FEET _____ INCHES
 _____ FEET _____ INCHES _____ FEET _____ INCHES
 _____ FEET _____ INCHES _____ FEET _____ INCHES

WELL ACIDIZED (DETAILS) _____
 WELL FRACTURED (DETAILS) Fractured Newburg 7-11-68 with 26,000// 20-40 sand, 778 bbls. water, 1,000 gallons acid
 RESULT AFTER TREATMENT (Initial open flow or bbls.) 82,000 Mcf Four Point Potential Test
 ROCK PRESSURE AFTER TREATMENT 1945// HOURS 88,040,000
 Fresh Water _____ Feet _____ Salt Water _____ Feet _____
 Producing Sand Newburg Depth 5696'

Formation	Color	Hard or Soft	Top	Bottom	Oil, Gas or Water	Depth	Remarks
Red Rock & Sand			0	100			
Sand			100	260	5692	5692	
Sand & Shale			260	1245	4915	850	
Sand			1245	1630			
Lime - Bigline			1630	1830	777	4842	
Sand - Injun			1830	1860			
Shale			1860	2280			
Sand - Berea			2280	2320			
Shale			2320	4830			
Corniferous Lime			4830	4915			
Oriskany Sand			4915	4960	Show gas in Oriskany		
Shale & Lime			4960	5200	Show sulphur gas 5530'		
Lime			5200	5350	Gas 5692-5696' est. 35,000 M		
Dolomite			5350	5692			
Newburg			5692	5696			
Total Depth			5696'				

Test before fracture - 35 MMCF
 Fractured Newburg
 Final open flow - 88 MMCF Four Point
 Rock Pressure 1945//
 CASING POINTS:
 13 3/8" 250' Cemented 125 sacks
 9 5/8" 32// 1924' Cemented 160 sacks
 7" 23 & 25// 5670' Cemented 150 sacks
 2 3/8" 4.6// 5803'

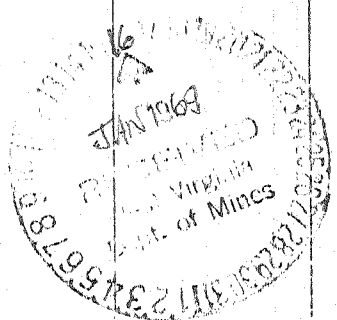

JAN 26 1969