

Partial Plug 12-3-68

- New Location
- Drill Deeper
- Redrill
- Abandonment

SOURCE OF ELEVATION BM 693

"I, the undersigned, hereby certify that this map is correct to the best of my knowledge and belief and shows all the information required by paragraph 6 of the rules and regulations of the oil and gas section of the mining laws of West Virginia."

Company	STONE STREET LANDS Co
Address	Box 350, SPENCER, W. Va. STONE STREET LAND Co
Form	CONSOLIDATED REPORT
Tract	Acres 251 Unit Lease No.
Well (Farm) No.	2 Consolidated Serial No.
Elevation (Spirit Level)	751.32
Quadrangle	ST ALBANS
County	KANAWHA District JEFFERSON
Engineer	Allen H. Kunk
Engineer's Registration No.	1530
File No.	S-407 Drawing No. P
Date	Oct. 16, 1968 Scale 1" = 1320'

STATE OF WEST VIRGINIA  
DEPARTMENT OF MINES  
OIL AND GAS DIVISION  
CHARLESTON

WELL LOCATION MAP  
FILE NO. Man-2324-PP

+ Denotes location of well on United States Topographic Maps, scale 1 to 62,500, latitude and longitude lines being represented by border lines as shown.

- Denotes one inch spaces on border line of original tracing.

Deep Well (Newburg) 3-0

211  
DEC 16 1968



STATE OF WEST VIRGINIA  
DEPARTMENT OF MINES  
OIL AND GAS DIVISION

Rotary   
Spudder   
Cable Tools   
Storage   
Oil or Gas Well Gas *Dry*  
(KIND)

Quadrangle St. Albans  
Permit No. KAN-2324


WELL RECORD

Company Stonestreet Lands Company  
Address Box 350, Spencer, W. Va.  
Farm Stonestreet Lands Co. Acres 286.47  
Location (waters) Tackett Creek  
Well No. 2 Elev. 688.23  
District Jefferson County Kanawha  
The surface of tract is owned in fee by \_\_\_\_\_  
Address \_\_\_\_\_  
Mineral rights are owned by Consolidated Realty Co. & Stonestreet Lands Co.  
Spencer, W. Va.  
Drilling commenced Oct. 26, 1968  
Drilling completed Nov. 3, 1968  
Date Shot \_\_\_\_\_ From \_\_\_\_\_ To \_\_\_\_\_  
With \_\_\_\_\_  
Open Flow \_\_\_\_\_ /10ths Water in \_\_\_\_\_ Inch  
\_\_\_\_\_ /10ths Merc. in \_\_\_\_\_ Inch  
Volume None Cu. Ft.  
Rock Pressure \_\_\_\_\_ lbs. \_\_\_\_\_ hrs.  
Oil \_\_\_\_\_ bbls., 1st 24 hrs.  
WELL ACIDIZED (DETAILS) Yes  
WELL FRACTURED (DETAILS) \_\_\_\_\_  
RESULT AFTER TREATMENT (Initial open Flow or bbls.) No results  
ROCK PRESSURE AFTER TREATMENT \_\_\_\_\_ HOURS  
Fresh Water None Feet \_\_\_\_\_ Salt Water Hole full Feet 1180  
Producing Sand None Depth \_\_\_\_\_

Casing and Tubing	Used in Drilling	Left in Well	Packers
Size			Kind of Packer
10		40'	40'
<del>8 5/8"</del>	1766'	1766'	Size of
6"			Depth set
5 3/16"	5316'	5316'	Perf. top <u>5276</u>
4 1/2"			Perf. bottom <u>5280</u>
3"			Perf. top
2"			Perf. bottom
Liners Used			

Attach copy of cementing record.  
CASING CEMENTED \_\_\_\_\_ SIZE \_\_\_\_\_ No. Ft. \_\_\_\_\_ Date \_\_\_\_\_  
Amount of cement used (bags) See attached record  
Name of Service Co. \_\_\_\_\_  
COAL WAS ENCOUNTERED AT \_\_\_\_\_ FEET \_\_\_\_\_ INCHES  
\_\_\_\_\_ FEET \_\_\_\_\_ INCHES FEET \_\_\_\_\_ INCHES  
\_\_\_\_\_ FEET \_\_\_\_\_ INCHES FEET \_\_\_\_\_ INCHES

Formation	Color	Hard or Soft	Top	Bottom	Oil, Gas or Water	Depth	Remarks
late			0	30			
. Rock			30	50			
late			50	170			
and			170	200			
late			200	245			
. Rock			245	270			
late & Shells			270	700			
and			700	795			
late			795	820			
and			820	1040			
late			1040	1065			
alt Sand			1065	1480			
ime			1440	1555			
ig Lime			1555	1700			
and			1700	1735			
late			1735	2132			
and			2132	2152			
late			2152	4420			
and			4420	4455			
ime			4455	5316			

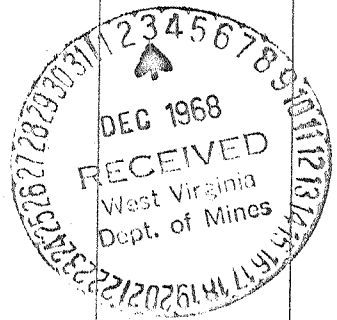

*Reese Hill?  
@TD  
Newburg interval should be @ 5040  
Test @ 5276-80 Keefer?*

*5316  
2152  
3164 expl footage DEC 09 1968*



STATE OF WEST VIRGINIA  
DEPARTMENT OF MINES  
OIL AND GAS DIVISION

Rotary   
Spudder   
Cable Tools   
Storage   
Oil or Gas Well Gas <sup>Dry</sup>  
(KIND)

Quadrangle St. Albans

Permit No. KAN-2324

WELL RECORD

Company Stonestreet Lands Company  
Address Box 350, Spencer, W. Va.  
Farm Stonestreet Lands Co. Acres 286.47  
Location (waters) Tackett Creek  
Well No. 2 Elev. 688.23  
District Jefferson County Kanawha  
The surface of tract is owned in fee by Shaws  
Address 7506L  
Mineral rights are owned by Consolidated Realty Co. & Stonestreet Lands Co. Address Spencer, W. Va.


Casing and Tubing	Used in Drilling	Left in Well	Packers
Size			
16			Kind of Packer.....
13	40'	40'	
10			Size of.....
8 5/8"	1766'	1766'	
6 5/8"			Depth set.....
5 3/16"			
4 1/4"	5316'	5316'	
3"			Perf. top <u>5276</u>
2"			Perf. bottom <u>5280</u>
Liners Used			Perf. top.....
			Perf. bottom.....

Drilling commenced Oct. 26, 1968  
Drilling completed Nov. 3, 1968  
Date Shot 1-3-69 From Fracture Information To   
With 398 bbls. water, 40,000 # Sand-500 gal acid.  
Open Flow None /10ths Water in None Inch  
/10ths Merc. in None Inch  
Volume None Cu. Ft.  
Rock Pressure 100 lbs. lbs. 24 hrs.  
Oil None bbls., 1st 24 hrs.  
WELL ACIDIZED (DETAILS) Yes

Attach copy of cementing record.  
CASING CEMENTED None SIZE None No. Ft. None Date None  
Amount of cement used (bags) See attached record  
Name of Service Co. None  
COAL WAS ENCOUNTERED AT None FEET None INCHES  
FEET None INCHES FEET None INCHES  
FEET None INCHES FEET None INCHES

WELL FRACTURED (DETAILS) Fractured 1-3-69  
RESULT AFTER TREATMENT (Initial open Flow or bbls.) 75,000  
ROCK PRESSURE AFTER TREATMENT 100 lbs. HOURS 24  
Fresh Water None Feet None Salt Water Hole full Feet 1180  
Producing Sand None Depth None

Formation	Color	Hard or Soft	Top	Bottom	Oil, Gas or Water	Depth	Remarks
Slate			0	30			
R. Rock			30	50			
Slate			50	170			
Sand			170	200			
Slate			200	245			
R. Rock			245	270			
Slate & Shells			270	700			
Sand			700	795			
Slate			795	820			
Sand			820	1040			
Slate			1040	1065			
Salt Sand			1065	1480			
Lime			1440	1555			
Big Lime			1555	1700			
Sand			1700	1735			
Slate			1735	2132			
Sand			2132	2152			
Slate			2152	4420			
Sand			4420	4455			
Lime			4455	5316			

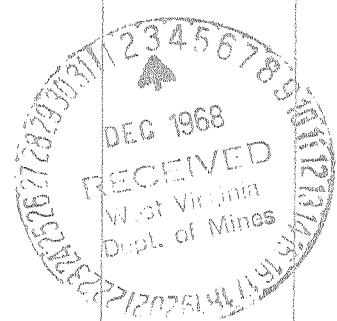

Ran 2206' of 4 1/2" Casing. Perforated at 2170' with 3 holes and fractured 1/3/69 with 398 bbl. water, 40,000# sand, and 500 gal. acid. Final Open flow was 75,000 cubic feet and the rock pressure was 100 pounds in 24 hours.