

WW-7
8-30-06



West Virginia Department of Environmental Protection
Office of Oil & Gas
WELL LOCATION FORM: GPS

API: 47- 039 - 2395 WELL NO: 26

FARM NAME: Black Band Fuel No.26

RESPONSIBLE PARTY NAME: H.G. Energy, LLC

COUNTY: Kanawha DISTRICT: Washington

QUADRANGLE: Racine 7.5'

SURFACE OWNER: Dickinson Fuel Co.

ROYALTY OWNER: HG Energy, LLC

UTM GPS NORTHING: 4,233,190 (NAD 83)

UTM GPS EASTING: 439,890 (NAD 83) GPS ELEVATION: 308 m. (1009')

The Responsible Party named above has chosen to submit GPS coordinates in lieu of preparing a new well location plat for a plugging permit or assigned API number on the above well. The Office of Oil & Gas will not accept GPS coordinates that do not meet the following requirements:

1. Datum: NAD 1983, Zone:17 North, Coordinate Units: meters, Altitude: height above mean sea level (MSL) - meters.
2. Accuracy to Datum - 3.05 meters
3. Data Collection Method:

Survey Grade GPS Post Processed Differential
 Real-Time Differential

Mapping Grade GPS Post Processed Differential
 Real-Time Differential

- 4 **Letter size copy of the topography map showing the well location.**

I the undersigned, hereby certify this data is correct to the best of my knowledge and belief and shows all the information required by law and the regulations issued and prescribed by the Office of Oil and Gas.

Diane White
Diane C. White


Designated Agent
Title

11/20/2018

Date RECEIVED
Office of Oil and Gas

APR 10 2019

SUBJECT WELL
Black Band Fuel No.26
47-039-2395

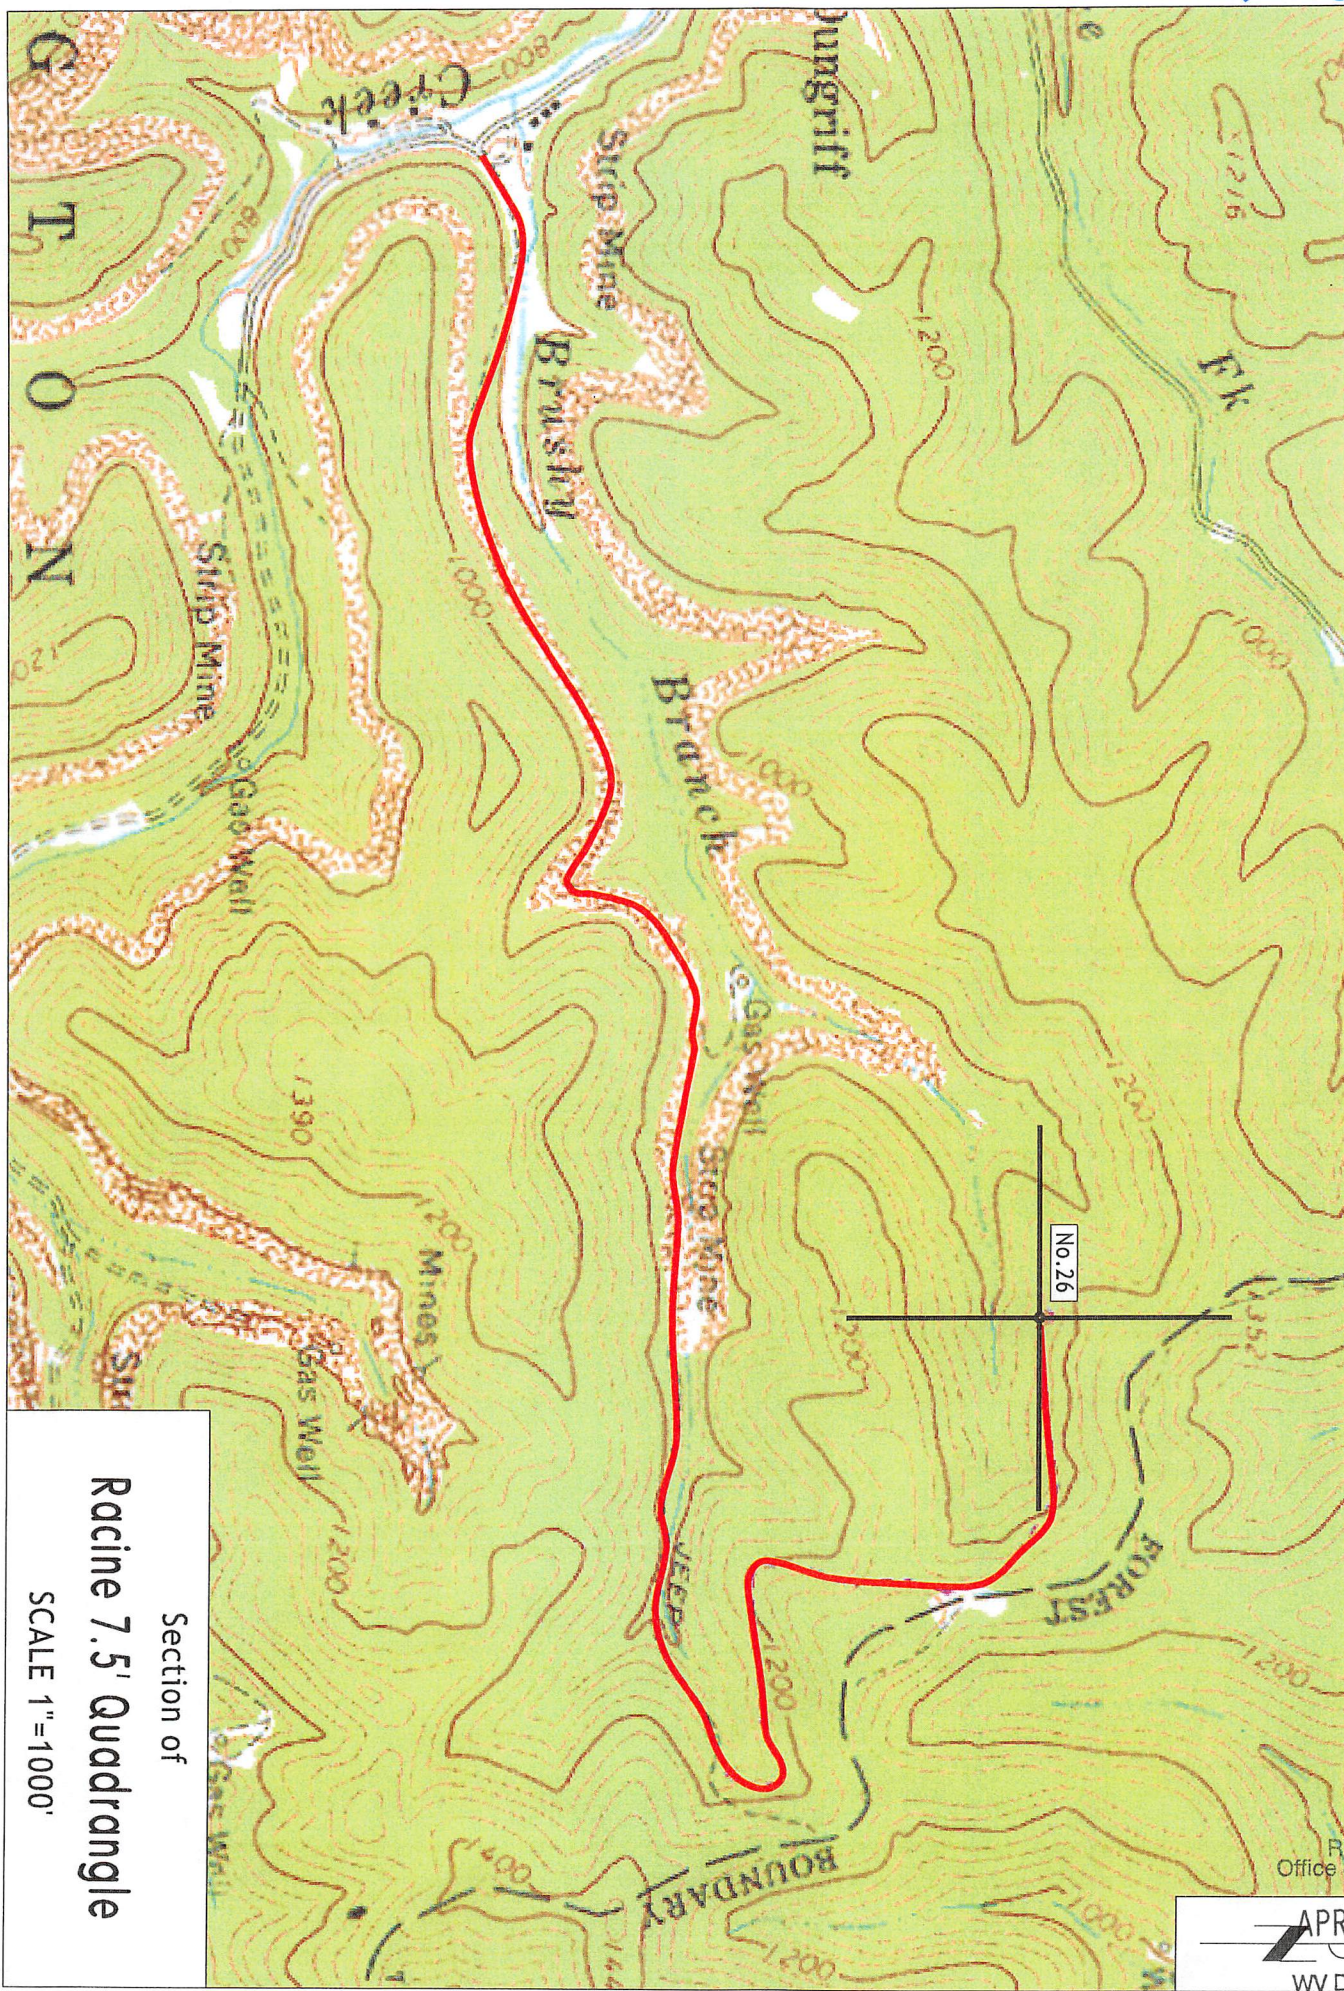

Section of
Racine 7.5' Quadrangle
SCALE 1"=1000'

RECEIVED
Office of Oil and Gas
APR 10 2019
WV Department of
Environmental Protection