
7/9/69 CEN

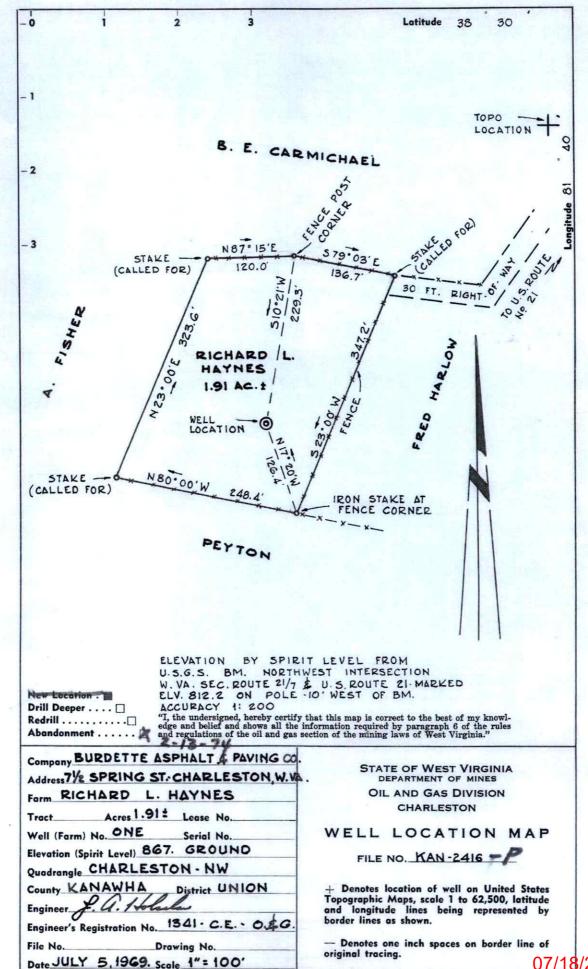

ALLEN BLUEPRINT & SUPPLY CO.

07/18/2025



West Virginia Department of Environmental Protection Office of Oil and Gas

WELL LOCATION FORM: GPS

WELL LO	CATION FURM: GPS	,
_{API:} 4703902416	WELL NO.: \	Haynes 1
FARM NAME: Haynes,	Richard L.	
RESPONSIBLE PARTY NAME	DEP Paid Pluggir	ng Contract
_{county:} Kanawha	DISTRICT: Ur	nion
QUADRANGLE: Pocatal		
SURFACE OWNER: Hayno	es, Richard L.	
ROYALTY OWNER:		
UTM GPS NORTHING: 4 41	241	
UTM GPS EASTING: 42 59	036 GPS ELEVAT	10N: 867'
The Responsible Party named above preparing a new well location plat above well. The Office of Oil and Othe following requirements: 1. Datum: NAD 1983, Zorn height above mean season above mean season and a collection Method Survey grade GPS: Post F	for a plugging permit or assigned. Gas will not accept GPS coordinate: 17 North, Coordinate Units: malevel (MSL) – meters. 15 meters 16:	API number on the tes that do not meet
	Time Differential	
Mapping Grade GPS X: Po	st Processed Differential	
Re	al-Time Differential	
4. Letter size copy of the I the undersigned, hereby certify the belief and shows all the information prescribed by the Office of Oil and	n required by law and the regulation	knowledge and
Bryan Harris	Inspector Specialist	July 10, 2025
Signature	Title	Date