
WW-7 8-30-06				
West Virginia Department of Environmental Protection Office of Oil and Gas				
WELL LOCATION FORM: GPS				
_{API:} 4703902488	WELL NO.:2-S-157			
FARM NAME: Kan & Hocking Coal & Coke				
RESPONSIBLE PARTY NAME: Diversified Production LLC				
COUNTY: Kanawha	DISTRICT: Cabin Ck			
QUADRANGLE: Quick				
SURFACE OWNER: Blackhawk Mining				
ROYALTY OWNER: Pardee Resources				
UTM GPS NORTHING: 4235894.15				
UTM GPS EASTING: 458007.86	GPS ELEVATION: 883.71			
 The Responsible Party named above has chosen to submit GPS coordinates in lieu of preparing a new well location plat for a plugging permit or assigned API number on the above well. The Office of Oil and Gas will not accept GPS coordinates that do not meet the following requirements: Datum: NAD 1983, Zone: 17 North, Coordinate Units: meters, Altitude: height above mean sea level (MSL) – meters. Accuracy to Datum – 3.05 meters Data Collection Method: Survey grade GPS: Post Processed Differential 				
Real-Time Differe	ntial			
Mapping Grade GPS X: Post Processed Differential				
Real-Time Differential				
4. Letter size copy of the topography	map showing the well location.			

.

.

I the undersigned, hereby certify this data is correct to the best of my knowledge and belief and shows all the information required by law and the regulations issued and prescribed by the Office of Oil and Gas.

prescribed by the Office of Oil and Gas.		RECEIVED	
Juster Sutter	Digitally signed by Austin Sutler Date: 2022.01.17 08:32:43 -05'00'	Sr. Proj. Manager	1/17/2022 JAN 21 2021
Signature		Title	Date 0711 2021
			WV Department of Environmental Protection

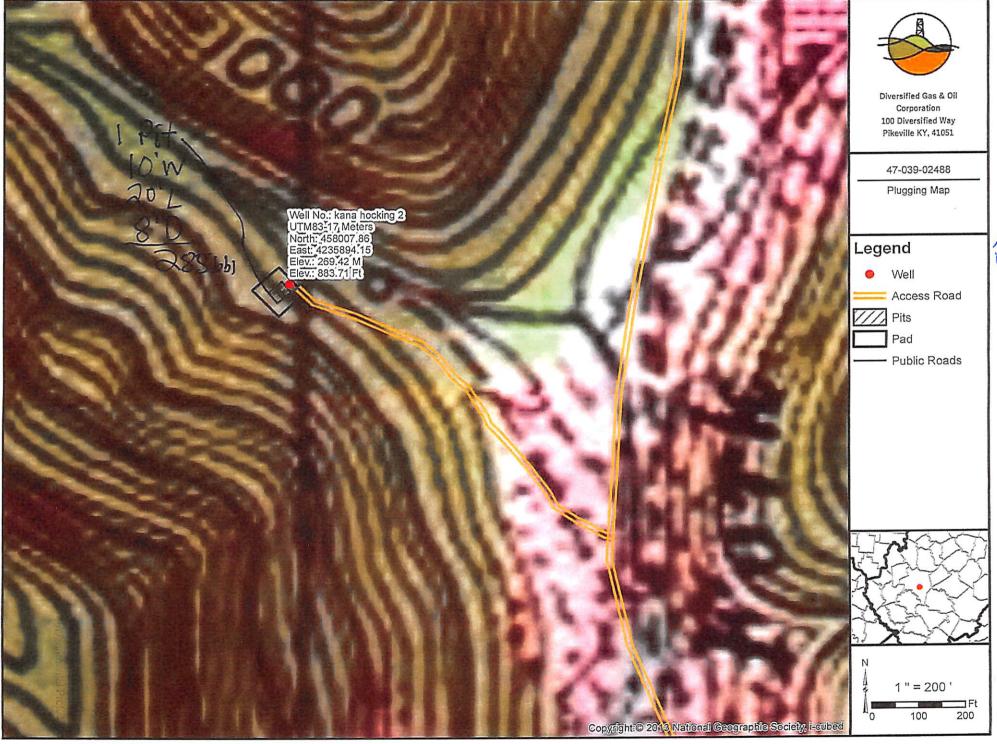

703902488

0

P

N