

UTM NAD.83
 ZONE 17
 0437680E
 4253021N

NAD 83
 LAT. 38.4232757N
 LONG. 81.7139329W

STATE PLANE COOR.
 NAD 83
 N 519,055
 E 1,763,973

NORTH

1,650'

LONGITUDE
 81°42'30"

12,700'



GARY B. GRIGSBY
 2824/3
 TM 23 PAR 72


ILA JEAN ANDERSON
 M28/644
 TM 23
 PAR 77

RALPH D. JONES
 2739/380
 TRACT 2
 TM 23 PAR 78

JOYSE A. PAYNE
 WB 662/39
 TM 24 PAR 31

DREMA JETT
 2830/682
 TM 23 PAR 110

RODNEY LOFTIS
 2740/476
 TM 24 PAR 34

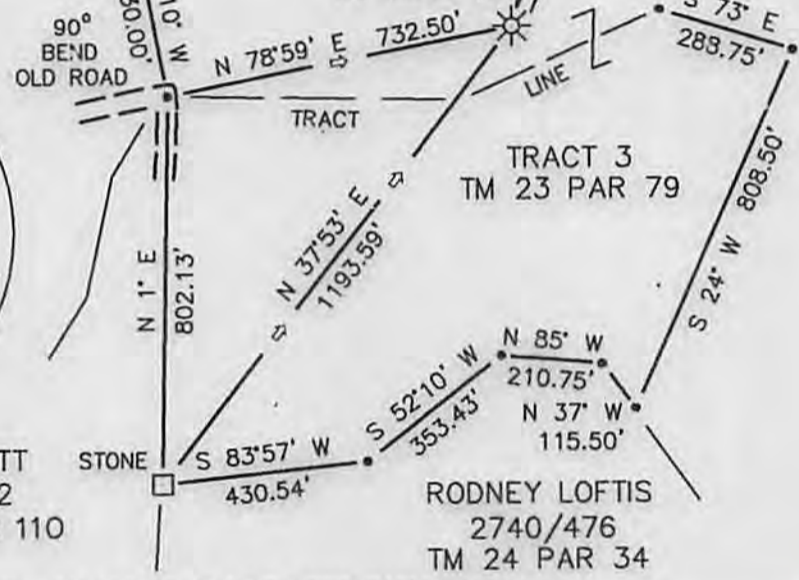

TOPO
 LOC

FILE NO. _____
 DRAWING NO. 14-1
 SCALE 1"=400'
 MINIMUM DEGREE OF ACCURACY 1 IN 200
 PROVEN SOURCE OF ELEVATION GPS

I THE UNDERSIGNED, HEREBY CERTIFY THAT THIS PLAT IS CORRECT TO THE BEST OF MY KNOWLEDGE AND BELIEF AND SHOWS ALL THE INFORMATION REQUIRED BY LAW AND THE REGULATIONS ISSUED AND PRESCRIBED BY THE DEPARTMENT OF ENERGY.
 (SIGNED) *[Signature]*
 R.P.E. _____ P.S. 851



STATE OF WEST VIRGINIA
 Department of Environmental Protection
 OFFICE OF OIL AND GAS

DATE 2/23, 2014
 OPERATOR'S WELL NO. RECEIVED RALPH D. JONES
 OFFICE OF OIL AND GAS
 47-039-02736R
 STATE COUNTY PERMIT
 WV Department of Environmental Protection

WELL TYPE: OIL ___ GAS LIQUID INJECTION ___ WASTE DISPOSAL ___
 (IF "GAS") PRODUCTION STORAGE ___ DEEP ___ SHALLOW

LOCATION: ELEVATION 868 WATER SHED LIMESTONE BR. OF FISHER BR. OF ROCKY FORK OF POCATALICO RIVER
 DISTRICT UNION COUNTY KANAWHA
 QUADRANGLE POCATALICO

SURFACE OWNER RALPH D. JONES ACREAGE 49
 OIL & GAS ROYALTY OWNER C.E. BAILEY JR., ETAL LEASE ACREAGE 49
 LEASE NO. _____


PROPOSED WORK: DRILL ___ CONVERT ___ DRILL DEEPER ___ REDRILL ___ FRACTURE OR
 STIMULATE PLUG OFF OLD FORMATION ___ PERFORATE NEW
 FORMATION ___ OTHER PHYSICAL CHANGE IN WELL (SPECIFY): PULL TUBING & INSTALL 4 1/2"

PLUG AND ABANDON ___ CLEAN OUT AND REPLUG ___

TARGET FORMATION BROWN SHALE ESTIMATED DEPTH 4223
 WELL OPERATOR Shale Gas Production LLC DESIGNATED AGENT J. SCOTT FRESHWATER
 ADDRESS 929 CHARLESTON ROAD ADDRESS 929 CHARLESTON ROAD
 SPENCER, WV 25276 SPENCER, WV 25276

02/28/2014

3902736 R

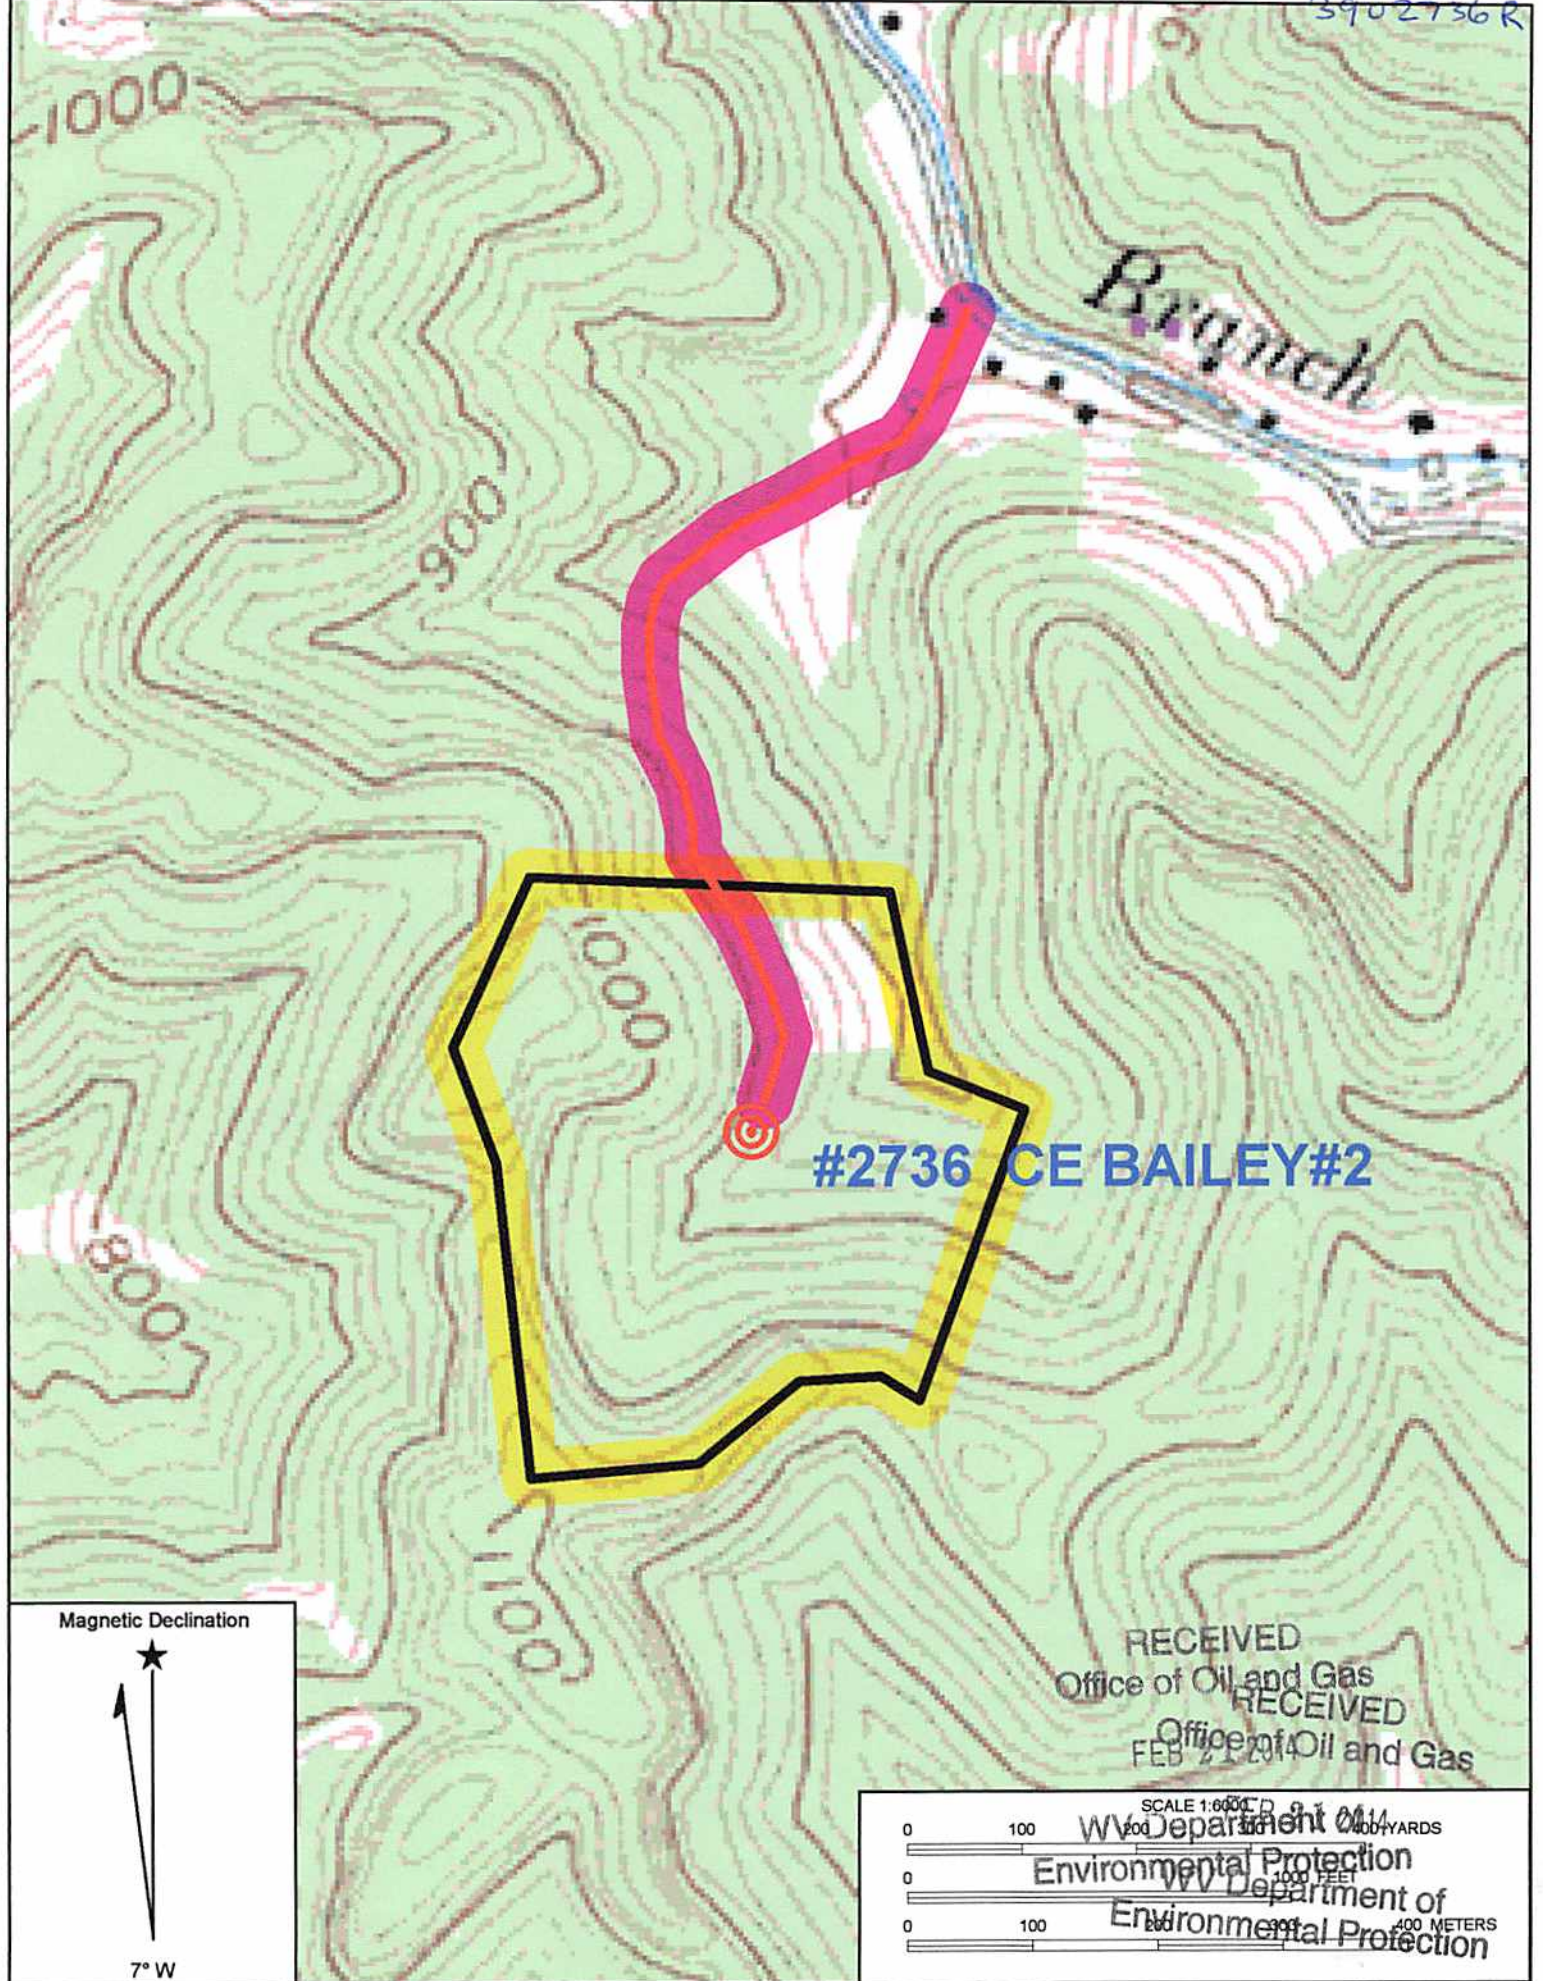

#2736 CE BAILEY#2

Magnetic Declination



7° W

RECEIVED
Office of Oil and Gas
RECEIVED
Office of Oil and Gas
FEB 2 2014

