

WW-7  
8-30-06



West Virginia Department of Environmental Protection  
Office of Oil and Gas  
**WELL LOCATION FORM: GPS**

API: 4703902929 WELL NO.: 5

FARM NAME: Quincy Coal Co.

RESPONSIBLE PARTY NAME: Diversified Production LLC

COUNTY: Kanawha DISTRICT: Cabin Creek

QUADRANGLE: Cedar Grove

SURFACE OWNER: Ranger Scientific LLC

ROYALTY OWNER: Diversified Production LLC

UTM GPS NORTHING: 4230545.86

UTM GPS EASTING: 457201.6 GPS ELEVATION: 1345.61

The Responsible Party named above has chosen to submit GPS coordinates in lieu of preparing a new well location plat for a plugging permit or assigned API number on the above well. The Office of Oil and Gas will not accept GPS coordinates that do not meet the following requirements:

1. Datum: NAD 1983, Zone: 17 North, Coordinate Units: meters, Altitude: height above mean sea level (MSL) – meters.
2. Accuracy to Datum – 3.05 meters
3. Data Collection Method:

Survey grade GPS  : Post Processed Differential

Real-Time Differential

Mapping Grade GPS  : Post Processed Differential

Real-Time Differential

4. Letter size copy of the topography map showing the well location.

I the undersigned, hereby certify this data is correct to the best of my knowledge and belief and shows all the information required by law and the regulations issued and prescribed by the Office of Oil and Gas.

Austin Suttler Sr. Proj. Manager 1/14/2022  
Signature Title Date


RECEIVED  
Office of Oil and Gas

JAN 21 2021

WV Department of  
Environmental Protection

02/11/2022

4703902929F

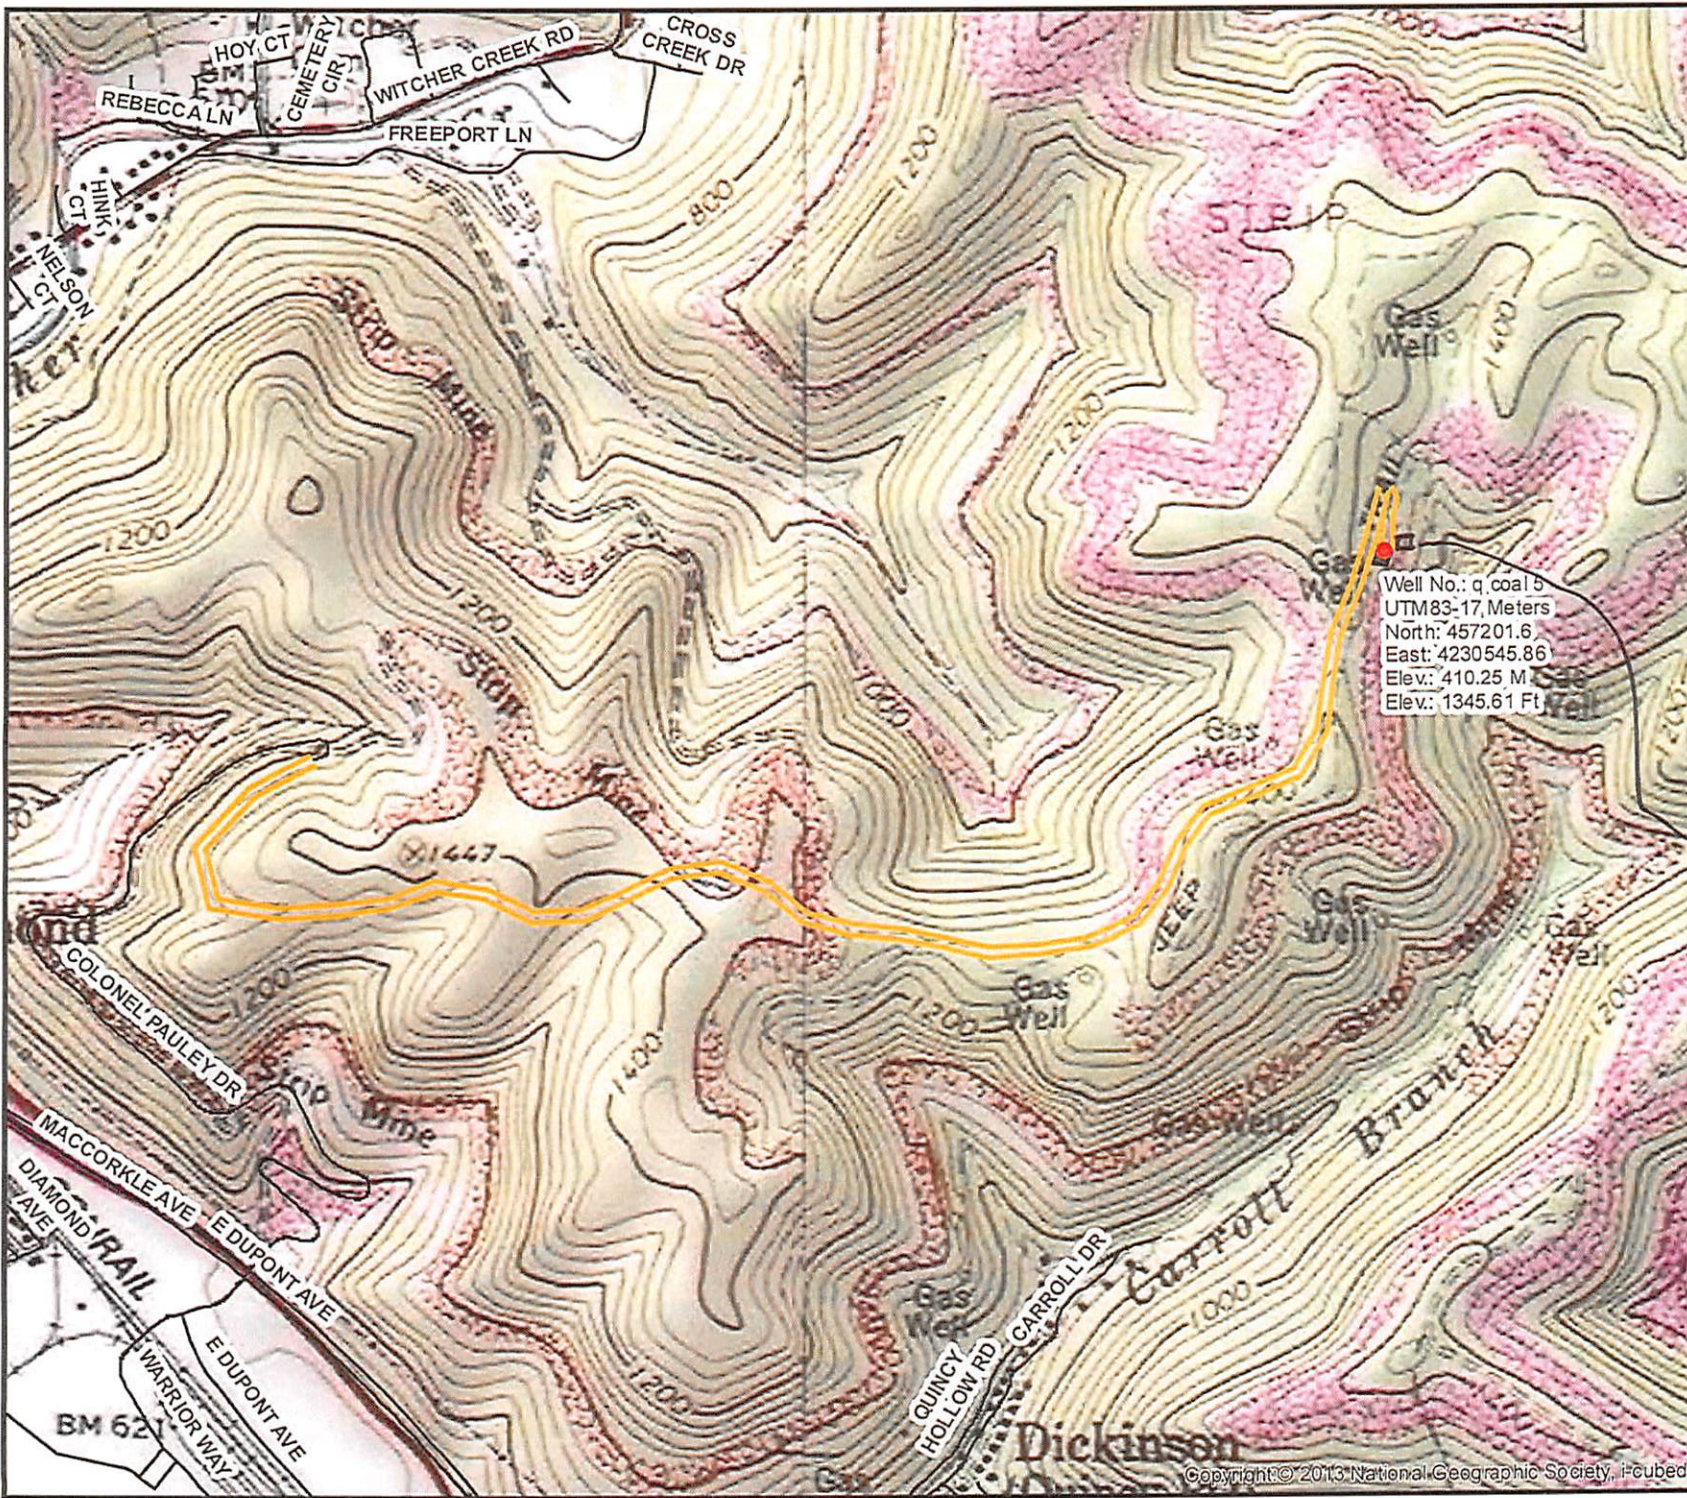

Diversified Gas & Oil Corporation  
 100 Diversified Way  
 Pikeville KY, 41051

47-039-02929

Plugging Map

**Legend**

- Well
- Access Road
- Pits
- Pad
- Public Roads

Well No.: q coal 5  
 UTM83-17, Meters  
 North: 457201.6  
 East: 4230545.86  
 Elev.: 410.25 M  
 Elev.: 1345.61 Ft

1 Pit  
 10' W  
 20' L  
 8' D  
 285 bbl

