

Oil&Gas

Wells, Horizontal Only

WellStatus

- Active Well
- Permit Issued
- Permit Application
- Plugged

Wells, Active Status Only


WellUse

- Brine Disposal
- Fluid Injection
- Gas Production
- House Gas
- Observation
- Oil Production
- Production
- Solution Mining
- Storage
- Vent
- <all other values>

Wells, Other than Active Status

WellUse

- Brine Disposal
- Fluid Injection
- Gas Production
- House Gas
- Observation
- Oil Production
- Production
- Solution Mining

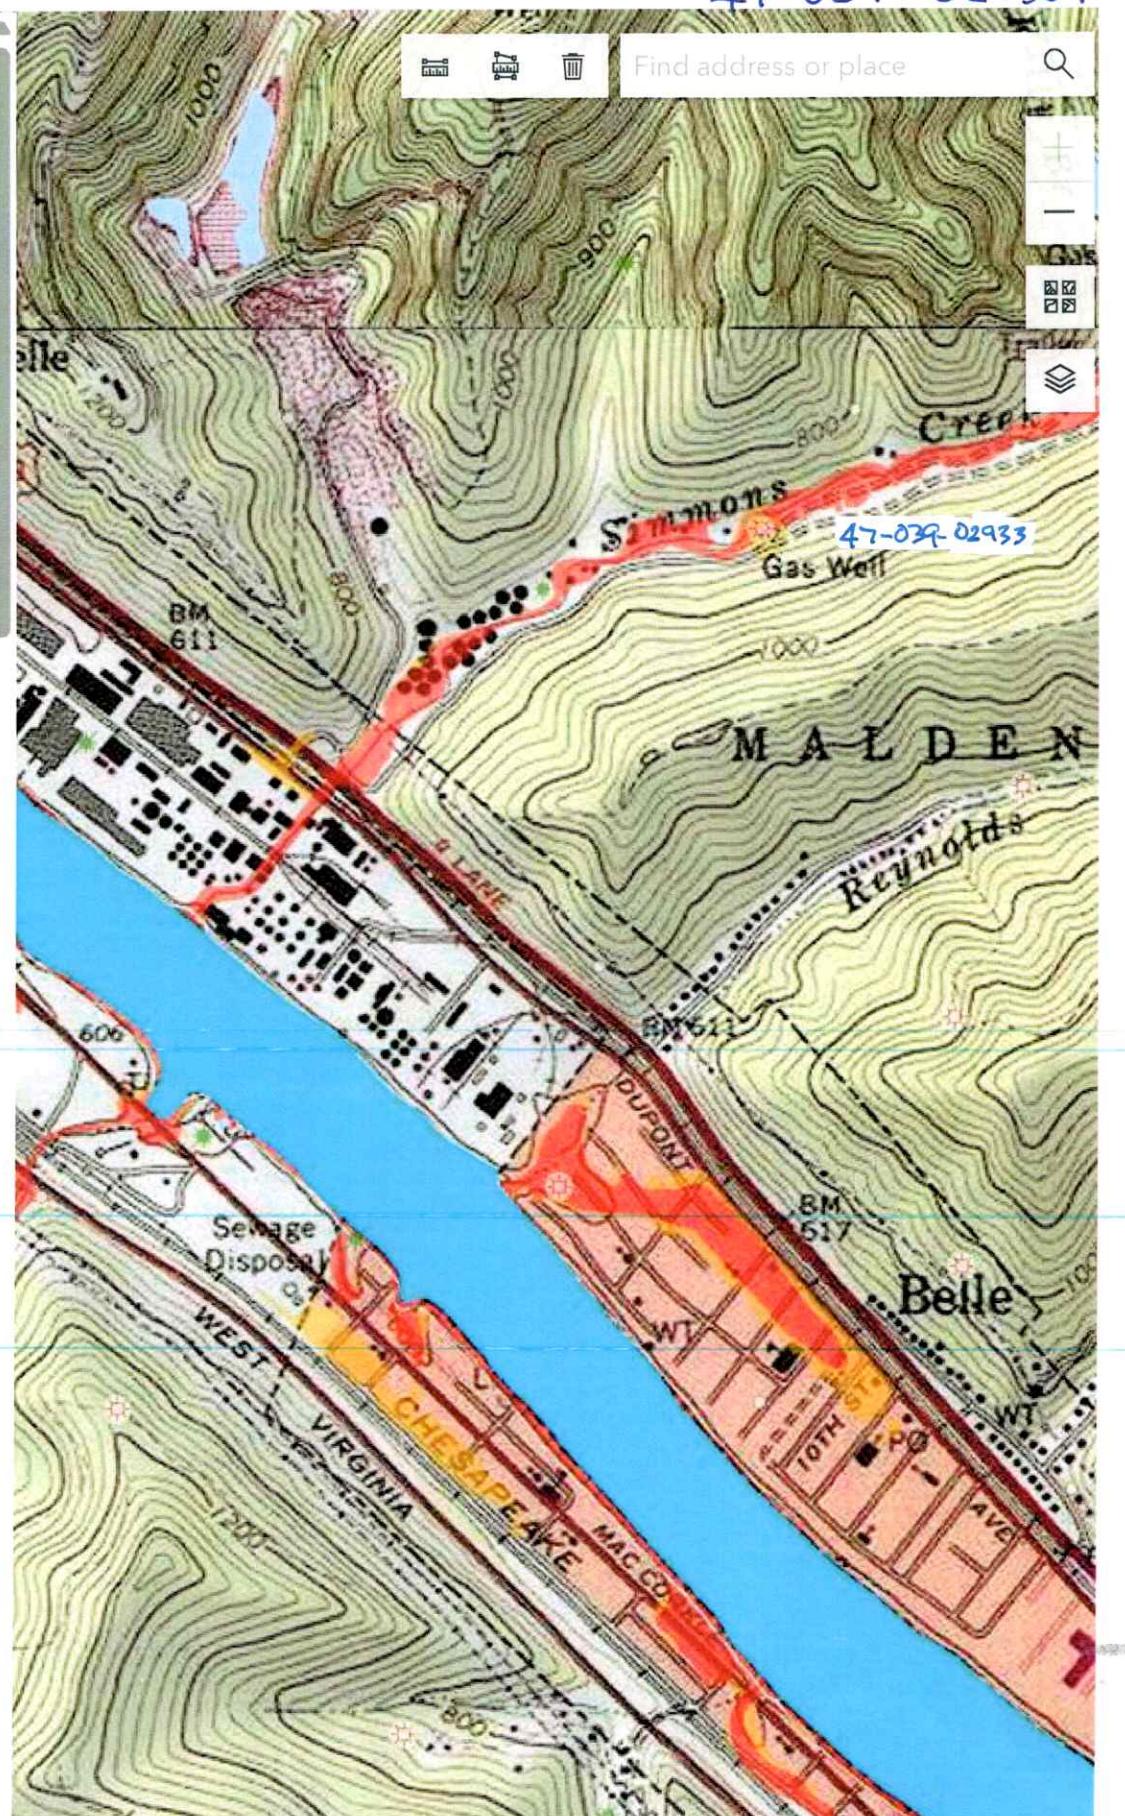

begin date

end date


rainfall total

update

01/30/2026

47-039-02933, P

Kan-2933

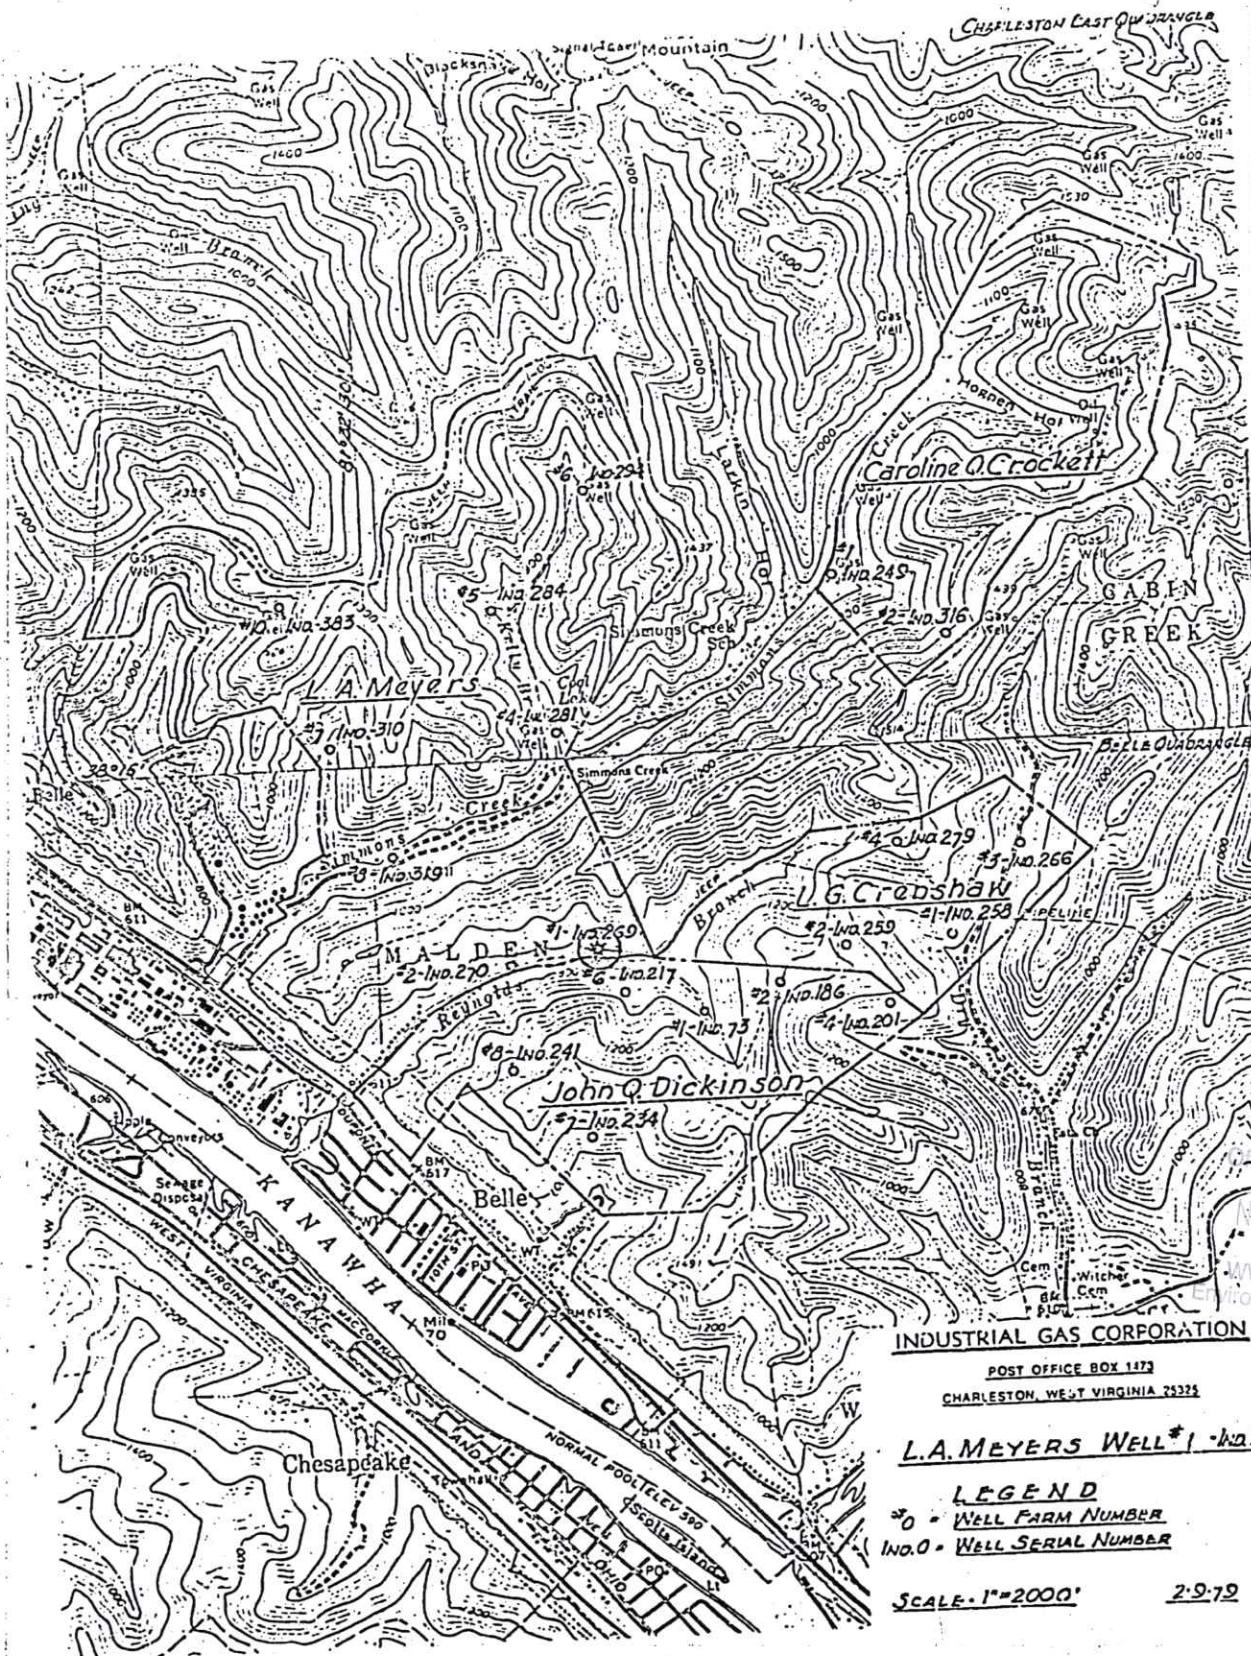

RECEIVED
ce of Oil and Gas

NOV 13 2025

Department of
Environmental Protection

INDUSTRIAL GAS CORPORATION

POST OFFICE BOX 1473
CHARLESTON, WEST VIRGINIA 25325

L.A. MEYERS WELL #1

LEGEND

20 - WELL FARM NUMBER

INO. 0 - WELL SERIAL NUMBER

SCALE. 1"=2000'

2-9-79

01/30/2026

WW-7
8-30-06



West Virginia Department of Environmental Protection
Office of Oil and Gas
WELL LOCATION FORM: GPS

API: 4703902933 WELL NO.: MEYERS L A A # 1

FARM NAME: Mewyers, L.A.

RESPONSIBLE PARTY NAME: Diversified Production, LLC

COUNTY: Kanawha DISTRICT: Malden

QUADRANGLE: Belle 7.5'

SURFACE OWNER: John H. Tincher & Girlonza N. Scott

ROYALTY OWNER: Unknown Owner

UTM GPS NORTHING: 4232921.18

UTM GPS EASTING: 453391.77 GPS ELEVATION: 924.74'

The Responsible Party named above has chosen to submit GPS coordinates in lieu of preparing a new well location plat for a plugging permit or assigned API number on the above well. The Office of Oil and Gas will not accept GPS coordinates that do not meet the following requirements:

1. Datum: NAD 1983, Zone: 17 North, Coordinate Units: meters, Altitude: height above mean sea level (MSL) – meters.

2. Accuracy to Datum – 3.05 meters

3. Data Collection Method:

Survey grade GPS : Post Processed Differential

Real-Time Differential


Mapping Grade GPS X : Post Processed Differential X

Real-Time Differential

RECEIVED
Office of Oil and Gas
NOV 13 2025

WV Department of
Environmental Protection

4. Letter size copy of the topography map showing the well location.
I the undersigned, hereby certify this data is correct to the best of my knowledge and belief and shows all the information required by law and the regulations issued and prescribed by the Office of Oil and Gas.

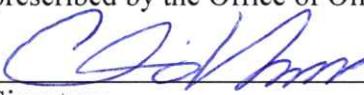
Signature

Chris Veazey - Director of Administration

Title


Date