



TOPO SECTION OF USGS
CEDAR GROVE 7.5' QUADRANGLE




Well Location Map for
47-039-03355
IMPERIAL #02

Northing: 4221059.3135
Easting: 462634.1021
Elevation: 1179 ft

UTM NAD83 Zone 17N Meters

Greylock Conventional, LLC
500 Corporate Landing
Charleston, WV 25311

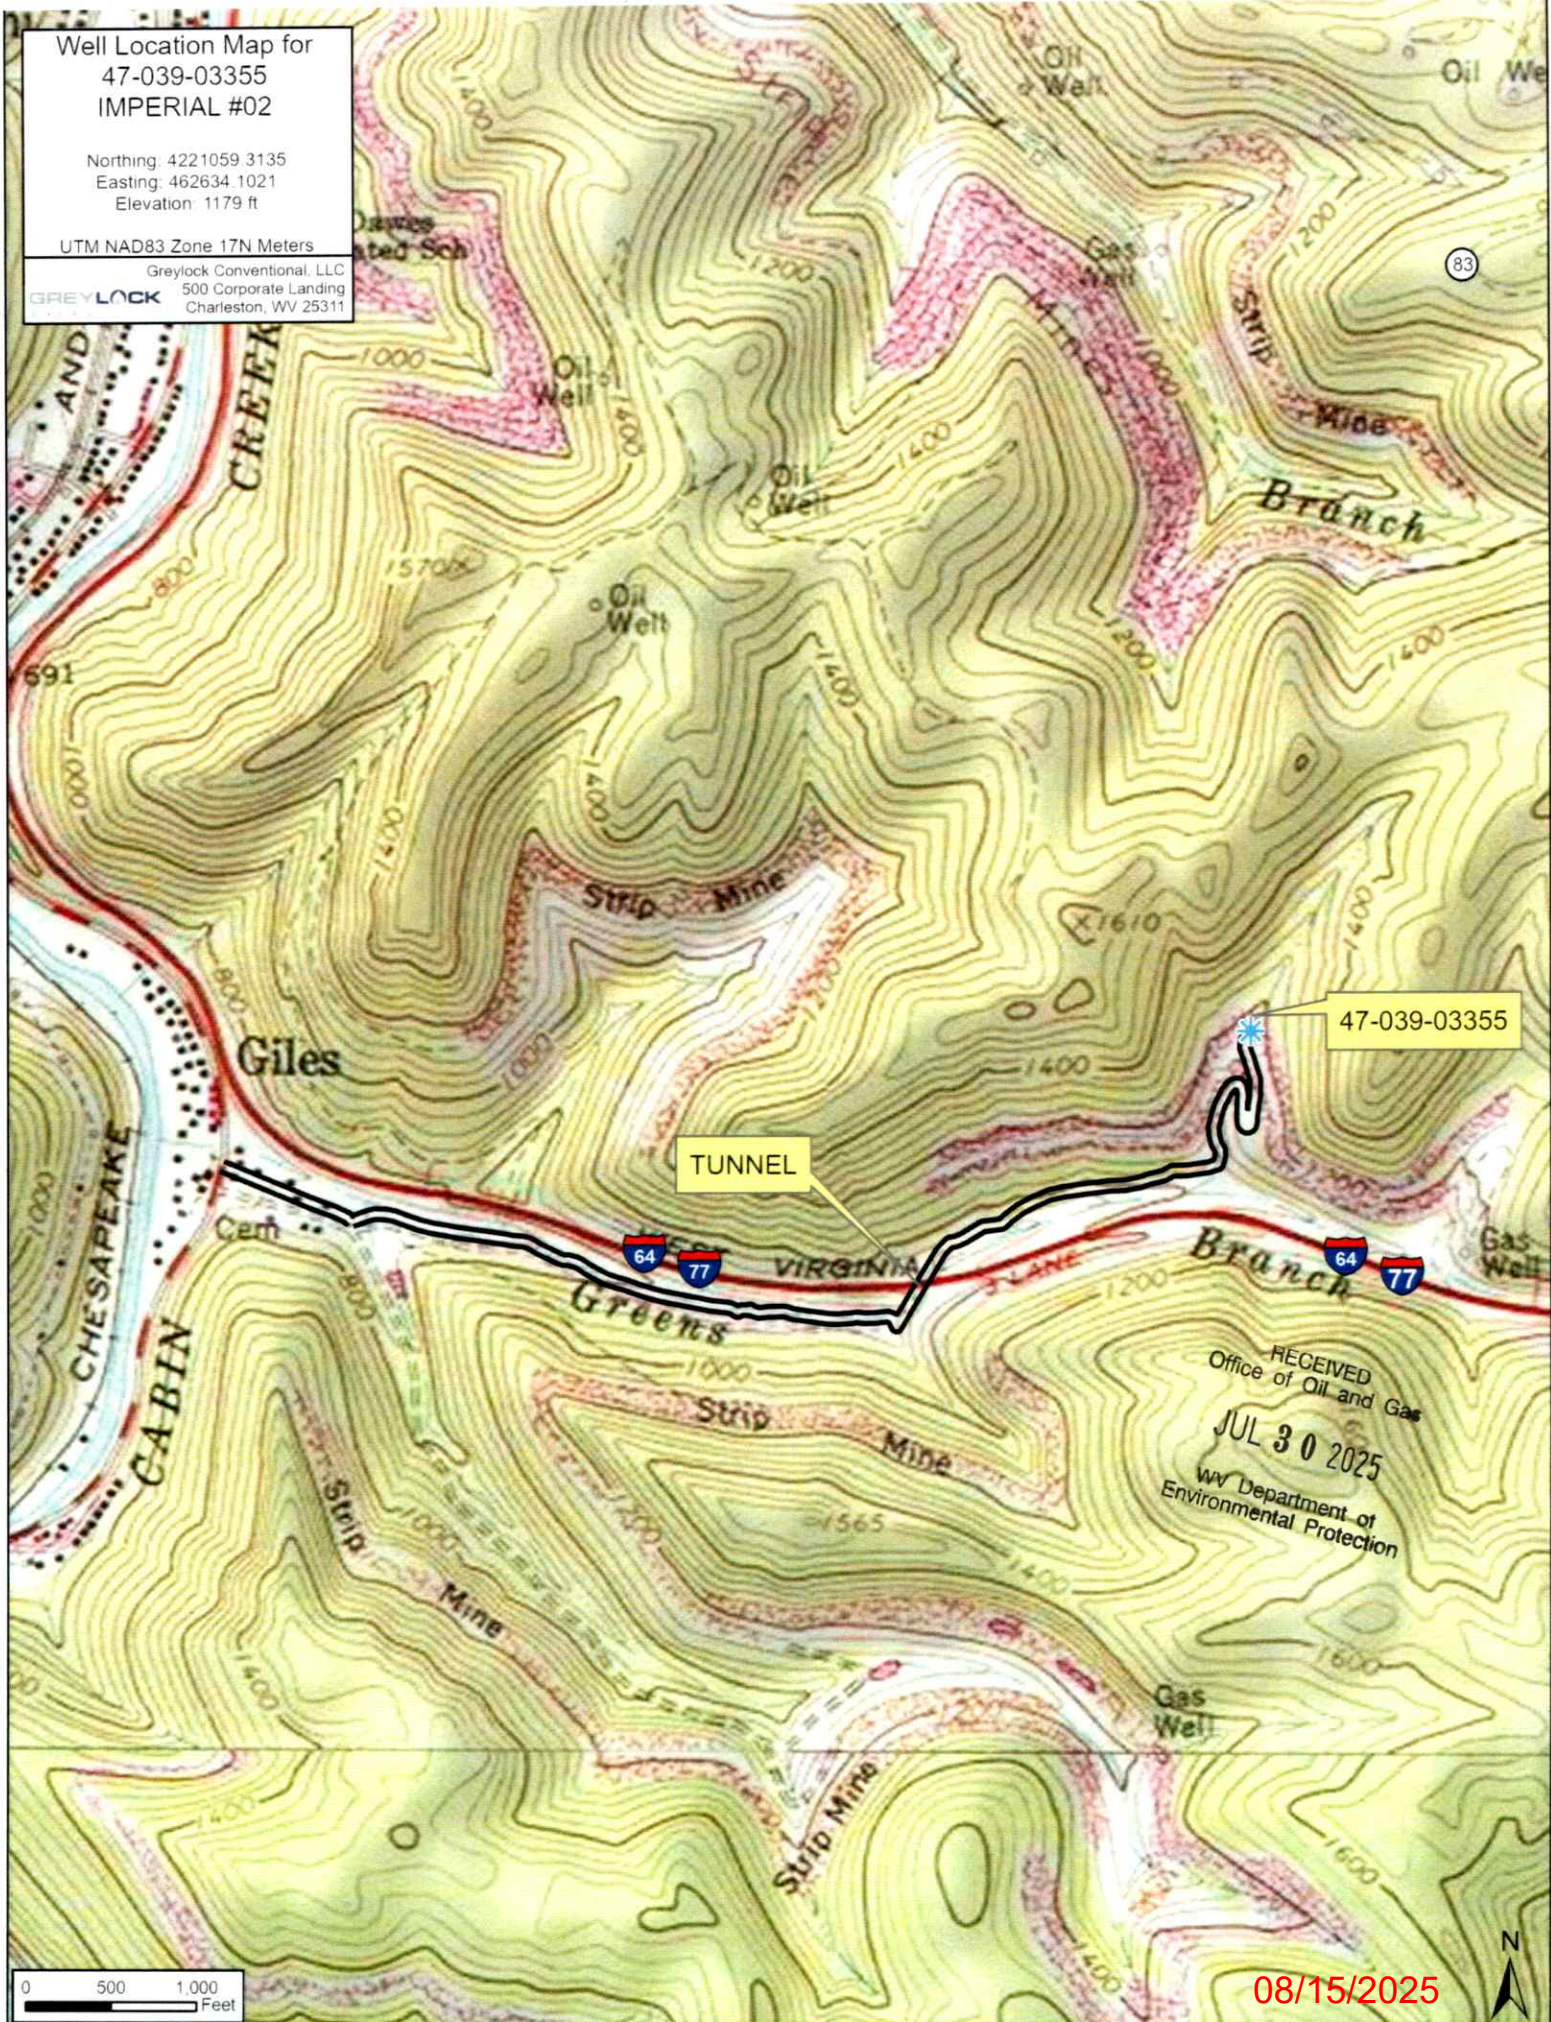

08/15/2025



West Virginia Department of Environmental Protection
Office of Oil and Gas

WELL LOCATION FORM: GPS

API: 47-039-03355 WELL NO.: 02
FARM NAME: IMPERIAL
RESPONSIBLE PARTY NAME: Greylock Conventional, LLC
COUNTY: Kanawha DISTRICT: Cabin Creek
QUADRANGLE: Cedar Grove
SURFACE OWNER: _____
ROYALTY OWNER: _____
UTM GPS NORTHING: 4221059.3135
UTM GPS EASTING: 462634.1021 GPS ELEVATION: 1,179 ft

The Responsible Party named above has chosen to submit GPS coordinates in lieu of preparing a new well location plat for a plugging permit or assigned API number on the above well. The Office of Oil and Gas will not accept GPS coordinates that do not meet the following requirements:

1. Datum: NAD 1983, Zone: 17 North, Coordinate Units: meters, Altitude: height above mean sea level (MSL) – meters.
2. Accuracy to Datum – 3.05 meters
3. Data Collection Method:
Survey grade GPS _____: Post Processed Differential _____

Real-Time Differential _____

Mapping Grade GPS X: Post Processed Differential _____

Real-Time Differential X

4. **Letter size copy of the topography map showing the well location.**

I the undersigned, hereby certify this data is correct to the best of my knowledge and belief and shows all the information required by law and the regulations issued and prescribed by the Office of Oil and Gas.

G.M. Ry
Signature

Asset Den Mager
Title

7/21/25
Date

RECEIVED
Office of Oil and Gas
JUL 30 2025
WV Department of
Environmental Protection

08/15/2025