


OHLEY #1

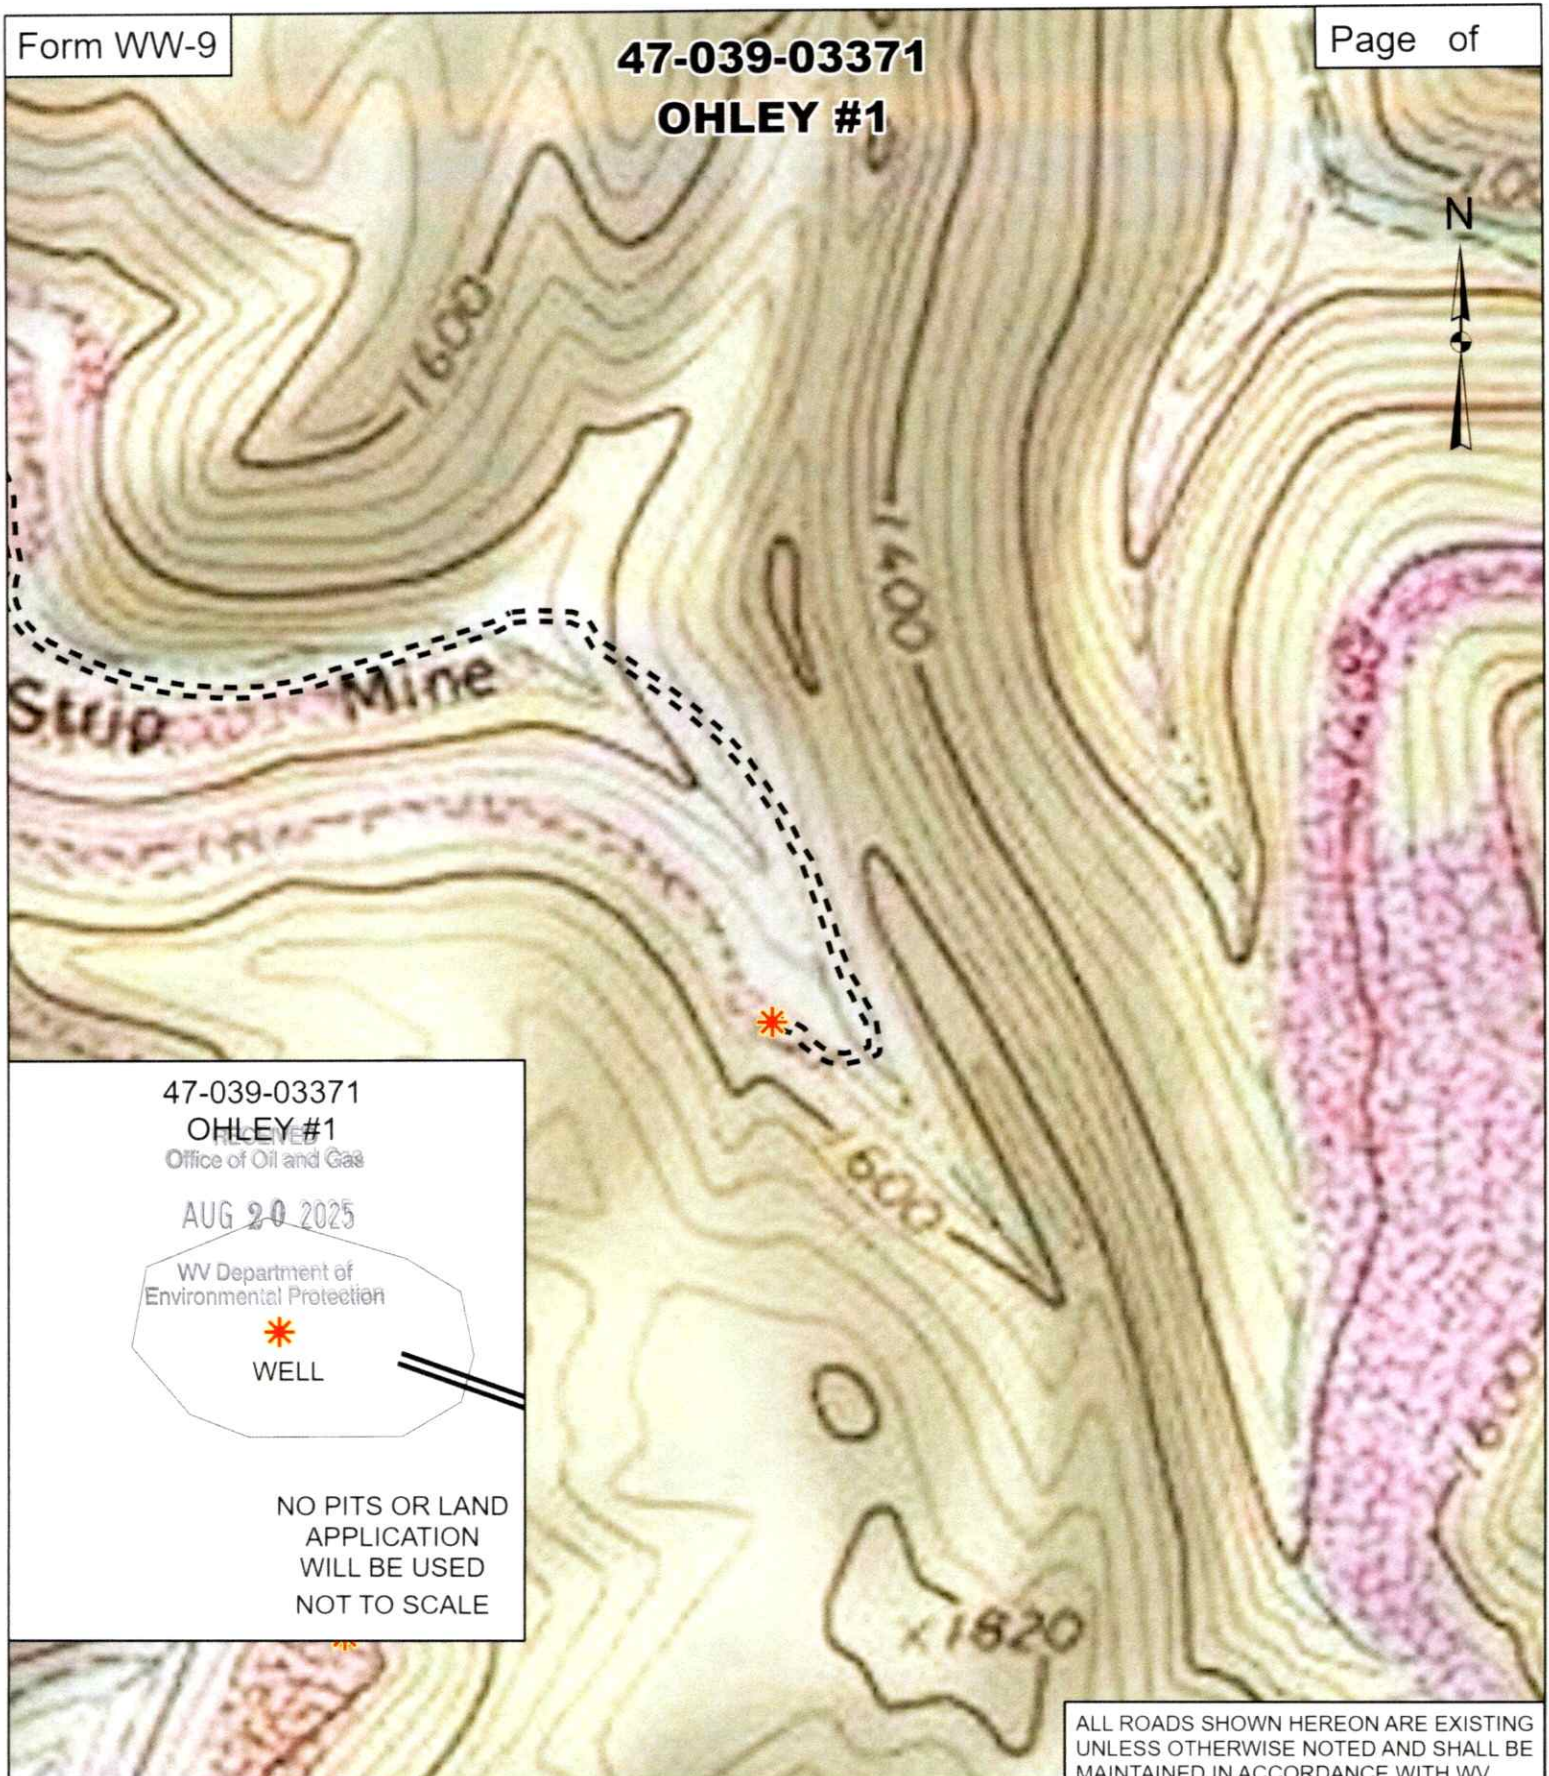

47-039-03371

OHLEY #1

Office of Oil and Gas

AUG 20 2025

WV Department of
Environmental Protection

WELL

NO PITS OR LAND
APPLICATION
WILL BE USED
NOT TO SCALE

GREYLOCK
ENERGY

Greylock Conventional, LLC

500 Corporate Landing Charleston, WV 25311
304-925-6100 - www.greylockenergy.com

Date: 8/11/2025

0 150 300 600 900 1,200



Feet

1:6,000



TOPO SECTION OF USGS
ESKDALE 7.5' QUADRANGLE

ALL ROADS SHOWN HEREON ARE EXISTING
UNLESS OTHERWISE NOTED AND SHALL BE
MAINTAINED IN ACCORDANCE WITH WV
D.E.P. OIL AND GAS BMP MANUAL
ENTRANCES AT COUNTY/STATE ROADS
SHALL BE MAINTAINED WITH WV D.O.T.
REGULATION. SEPARATE PERMITS MAY
BE REQUIRED BY D.O.T.

EARTHWORK CONTRACTORS ARE
RESPONSIBLE FOR THE ACCURACY OF THE
OPERATOR AND INSPECTOR PRIOR TO ANY
DEVIATION FROM THIS PLAN.


09/05/2025

Well Location Map for
47-039-03371
OHLEY #1

Northing: 4218179 9691
Easting: 462972 6122
Elevation: 1444 ft

UTM NAD83 Zone 17N Meters

GREYLOCK
Greylock Conventional, LLC
500 Corporate Landing
Charleston, WV 25311

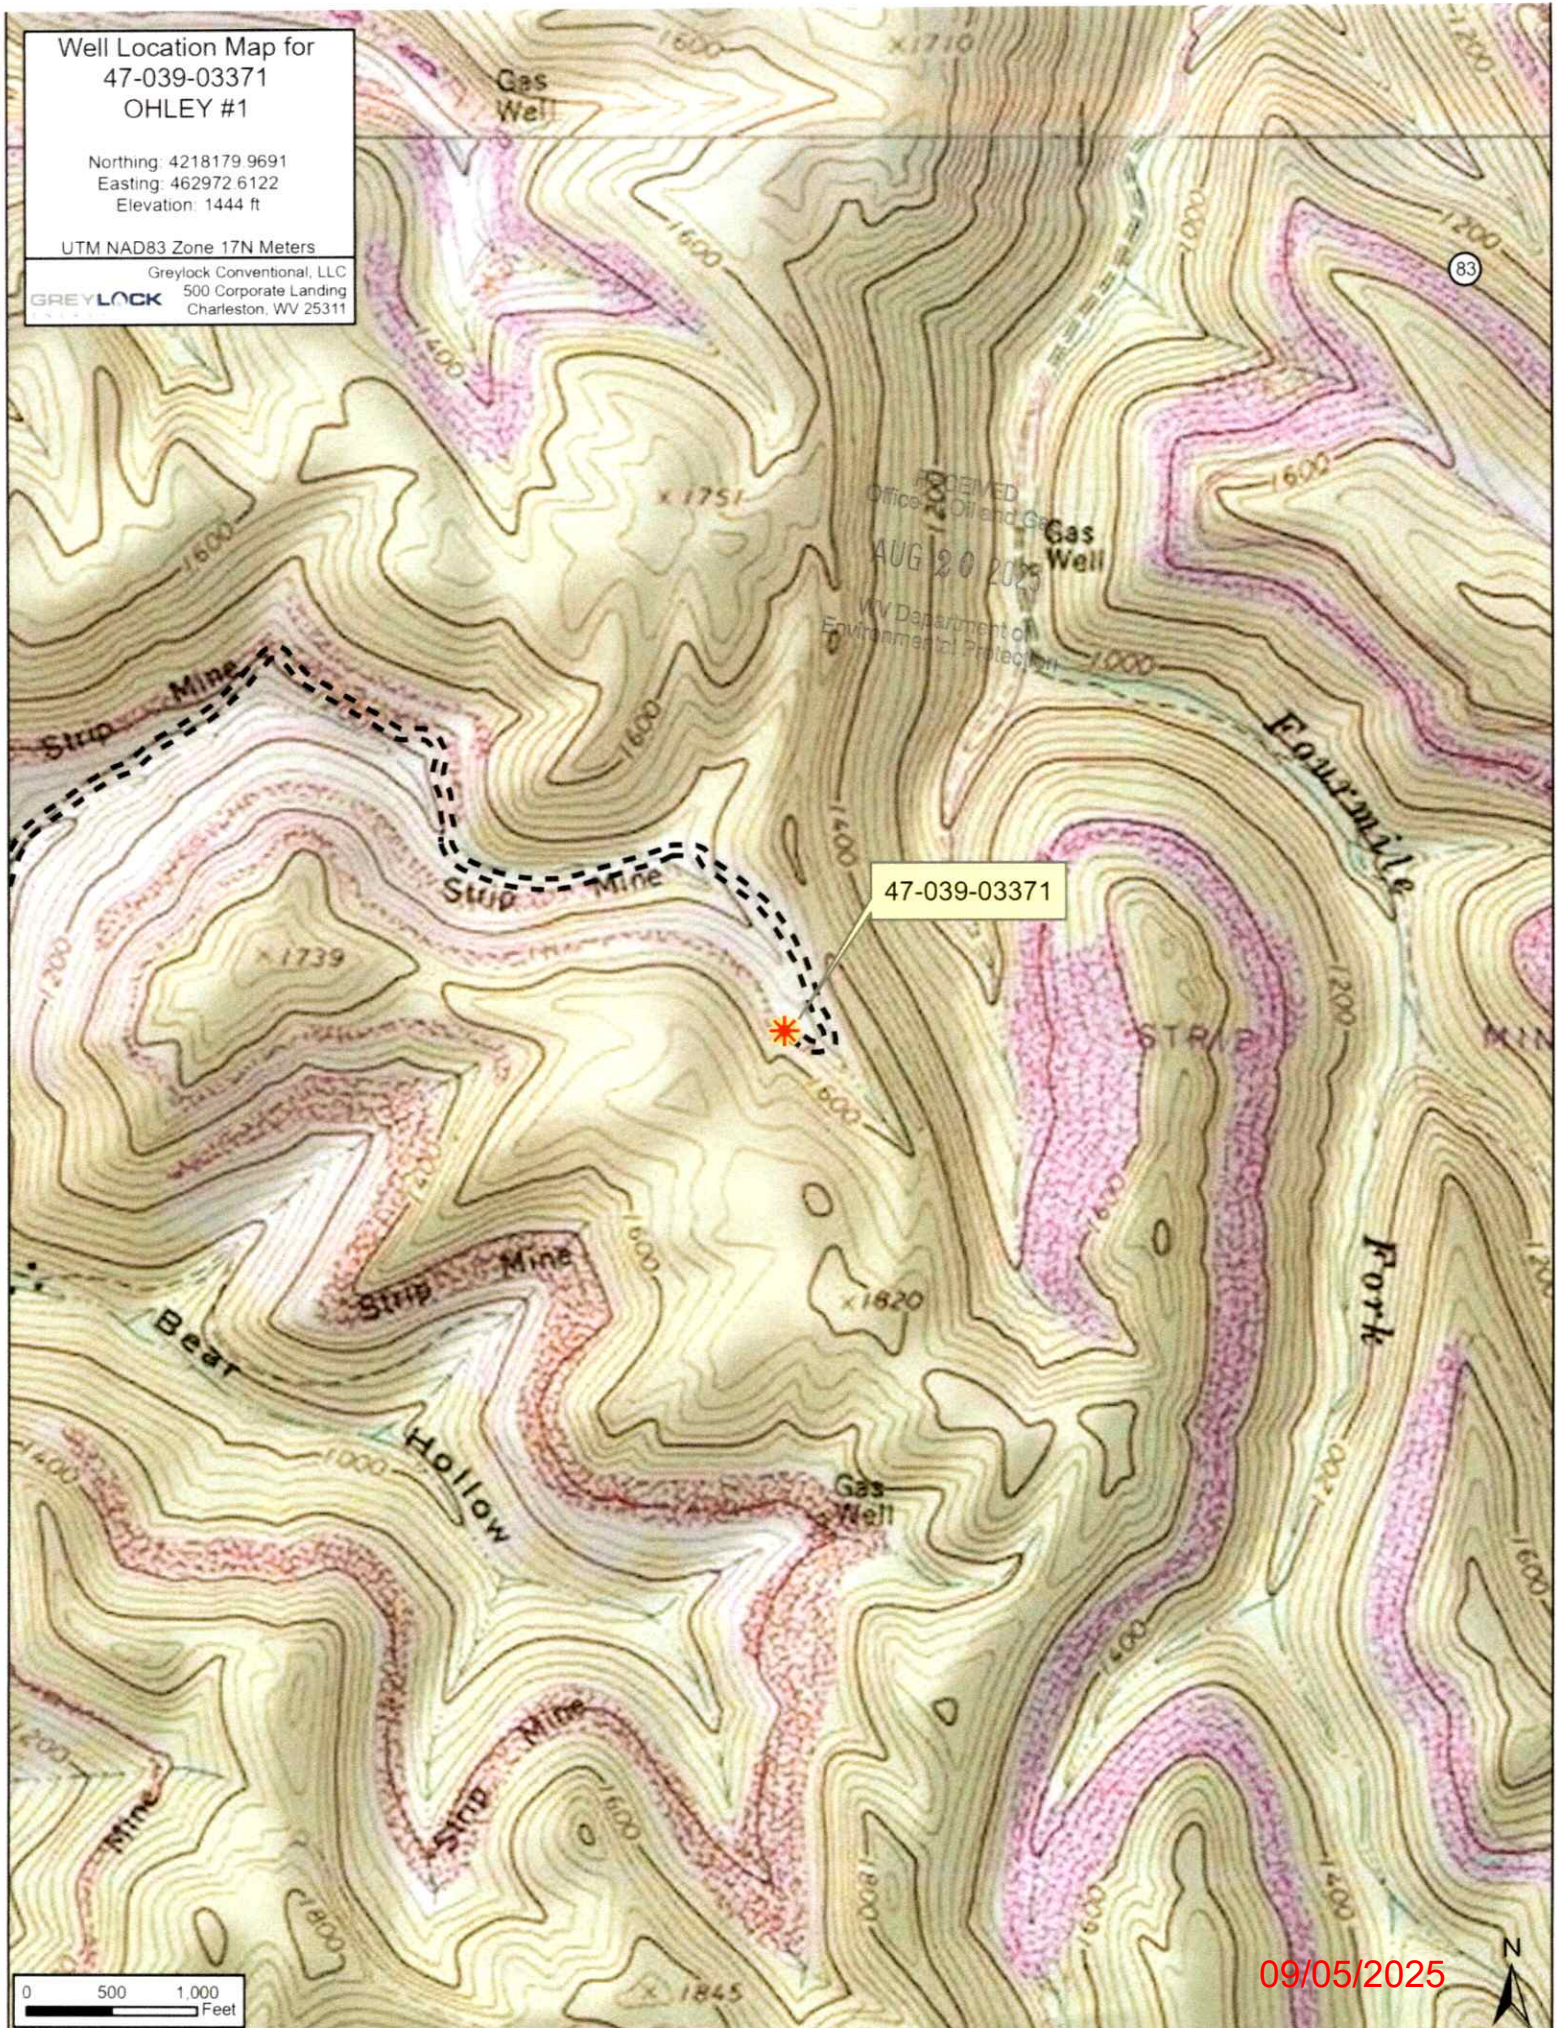

WW-7
8-30-06



West Virginia Department of Environmental Protection
Office of Oil and Gas

WELL LOCATION FORM: GPS

API: 47-039-03371 WELL NO.: 1

FARM NAME: Ohley

RESPONSIBLE PARTY NAME: Greylock Conventional, LLC

COUNTY: Kanawha DISTRICT: Cabin Creek

QUADRANGLE: Eskdale

SURFACE OWNER: Ohley Land Company

ROYALTY OWNER: Ohley Land Company

UTM GPS NORTHING: 4218179.969

UTM GPS EASTING: 462972.612 GPS ELEVATION: 1,444 ft

RECEIVED
Office of Oil and Gas
AUG 20 2025
WV Department of
Environmental Protection

The Responsible Party named above has chosen to submit GPS coordinates in lieu of preparing a new well location plat for a plugging permit or assigned API number on the above well. The Office of Oil and Gas will not accept GPS coordinates that do not meet the following requirements:

1. Datum: NAD 1983, Zone: 17 North, Coordinate Units: meters, Altitude: height above mean sea level (MSL) – meters.
2. Accuracy to Datum – 3.05 meters
3. Data Collection Method:

Survey grade GPS ____: Post Processed Differential ____

Real-Time Differential ____

Mapping Grade GPS X: Post Processed Differential ____

Real-Time Differential X

4. **Letter size copy of the topography map showing the well location.**

I the undersigned, hereby certify this data is correct to the best of my knowledge and belief and shows all the information required by law and the regulations issued and prescribed by the Office of Oil and Gas.

G.M. 14 Asset Dev. Manager 8/13/25
Signature Title Date

09/05/2025