

WW-7
8-30-06



West Virginia Department of Environmental Protection
Office of Oil and Gas
WELL LOCATION FORM: GPS

API: 47-039-03468 WELL NO.: WV 150201 (Harding #2)

FARM NAME: Harding

RESPONSIBLE PARTY NAME: EQT Production Company

COUNTY: Kanawha DISTRICT: Poca

QUADRANGLE: Romance 7.5'

SURFACE OWNER: James Tignor

ROYALTY OWNER: Lanora J. Davis, et al

UTM GPS NORTHING: 4265011

UTM GPS EASTING: 452867 GPS ELEVATION: 311m (1021 ft)

The Responsible Party named above has chosen to submit GPS coordinates in lieu of preparing a new well location plat for a plugging permit or assigned API number on the above well. The Office of Oil and Gas will not accept GPS coordinates that do not meet the following requirements:

- Datum: NAD 1983, Zone: 17 South, Coordinate Units: meters, Altitude: height above mean sea level (MSL) – meters.
- Accuracy to Datum – 3.05 meters
- Data Collection Method:

Survey grade GPS : Post Processed Differential
Real-Time Differential

Mapping Grade GPS X: Post Processed Differential X
Real-Time Differential

- Letter size copy of the topography map showing the well location.**

I the undersigned, hereby certify this data is correct to the best of my knowledge and belief and shows all the information required by law and the regulations issued and prescribed by the Office of Oil and Gas.


Signature

PS # 2180
Title

1/28/16
Date

Topo Quad: Romance 7.5'

Scale: 1" = 2000'

County: Kanawha


Date: January 26, 2016

District: Poca

Project No: 52-14-00-07

47-039-03468 WV 150201 Harding #2

Topo

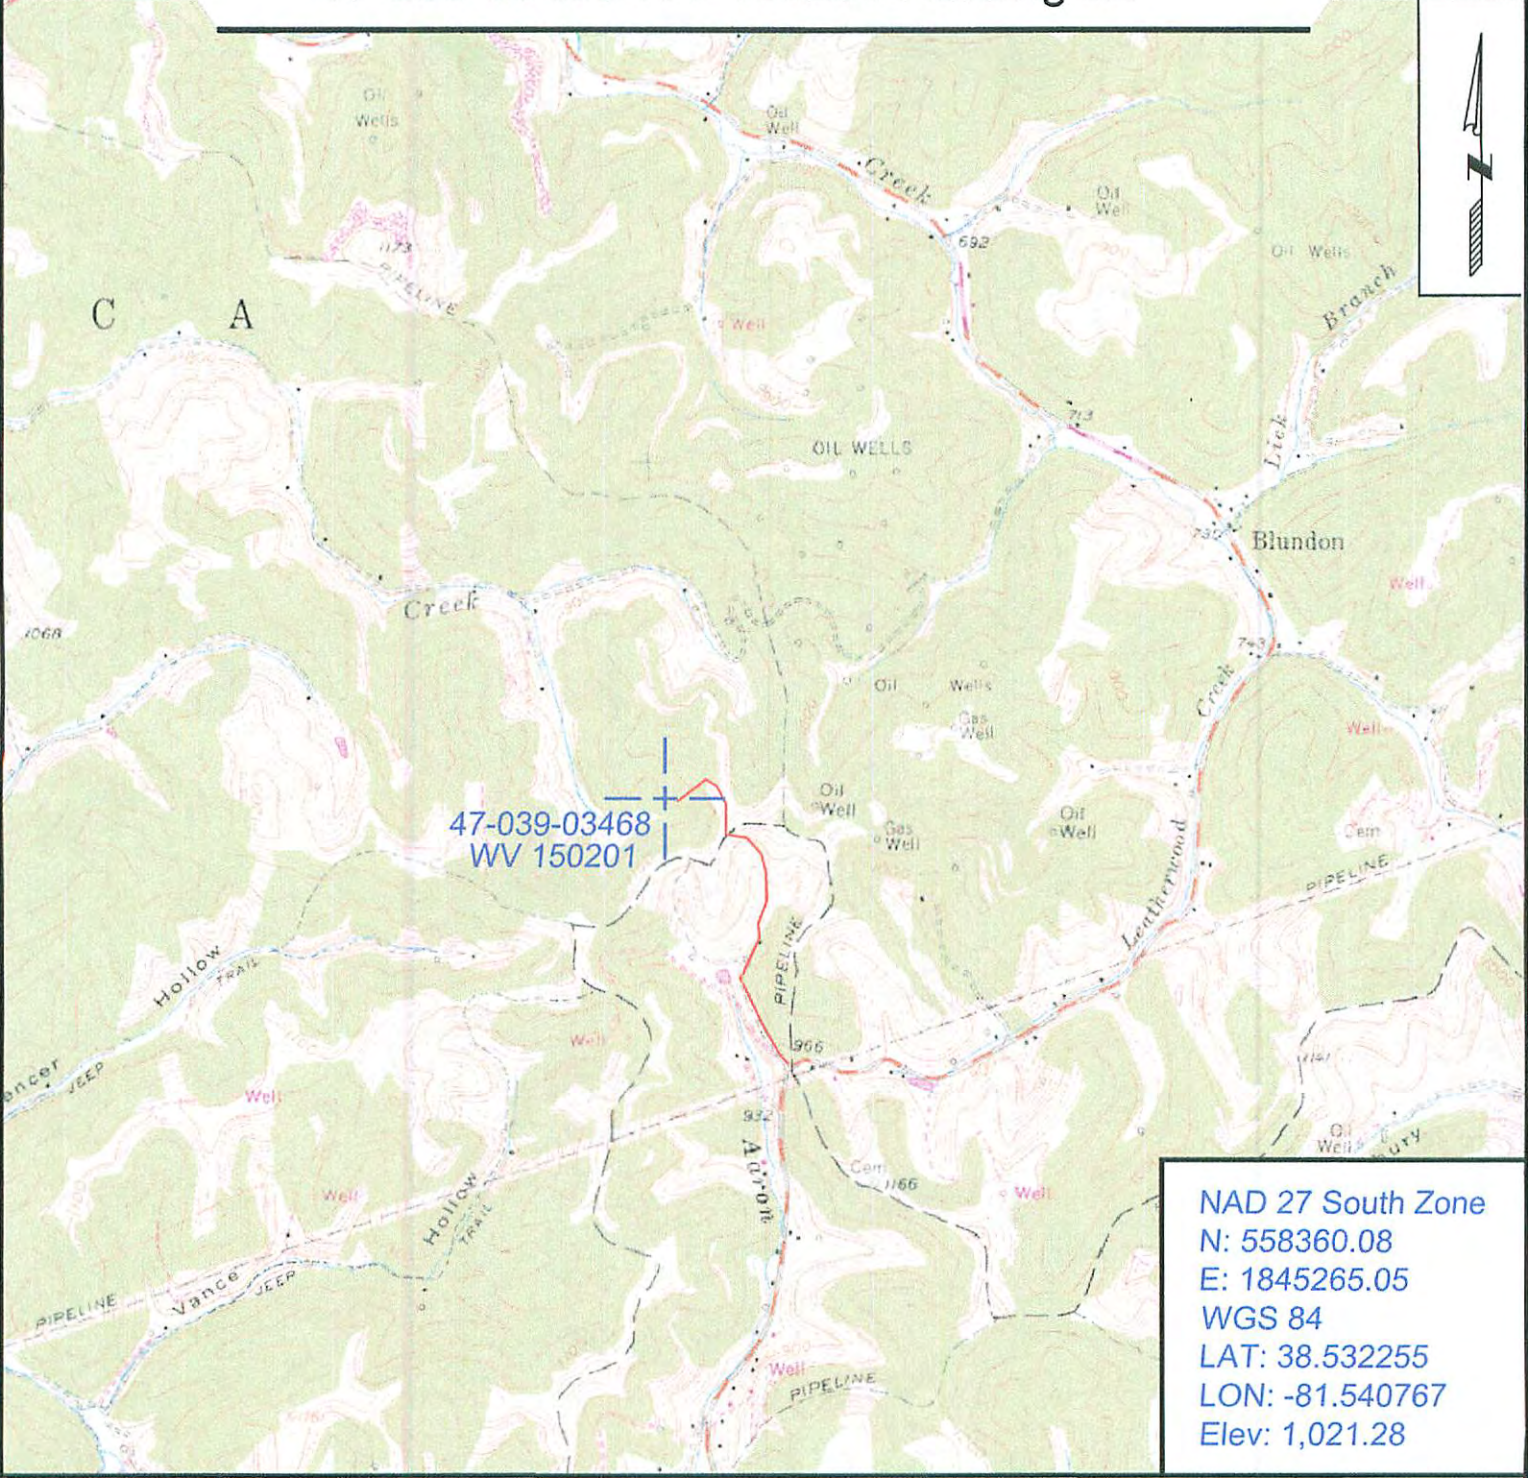

47-039-03468
WV 150201

NAD 27 South Zone
 N: 558360.08
 E: 1845265.05
 WGS 84
 LAT: 38.532255
 LON: -81.540767
 Elev: 1,021.28



SURVEYING AND MAPPING SERVICES PERFORMED BY:
ALLEGHENY SURVEYS, INC.
 1-800-482-8606
 237 Birch River Road
 Birch River, WV 26610
 PH: (304) 649-8606
 FAX: (304) 649-8608

PREPARED FOR:
EQT Production Company
 P.O. Box 280
 Bridgeport, WV 26330
 02/26/2016