


Young #2 LOCATION MAP

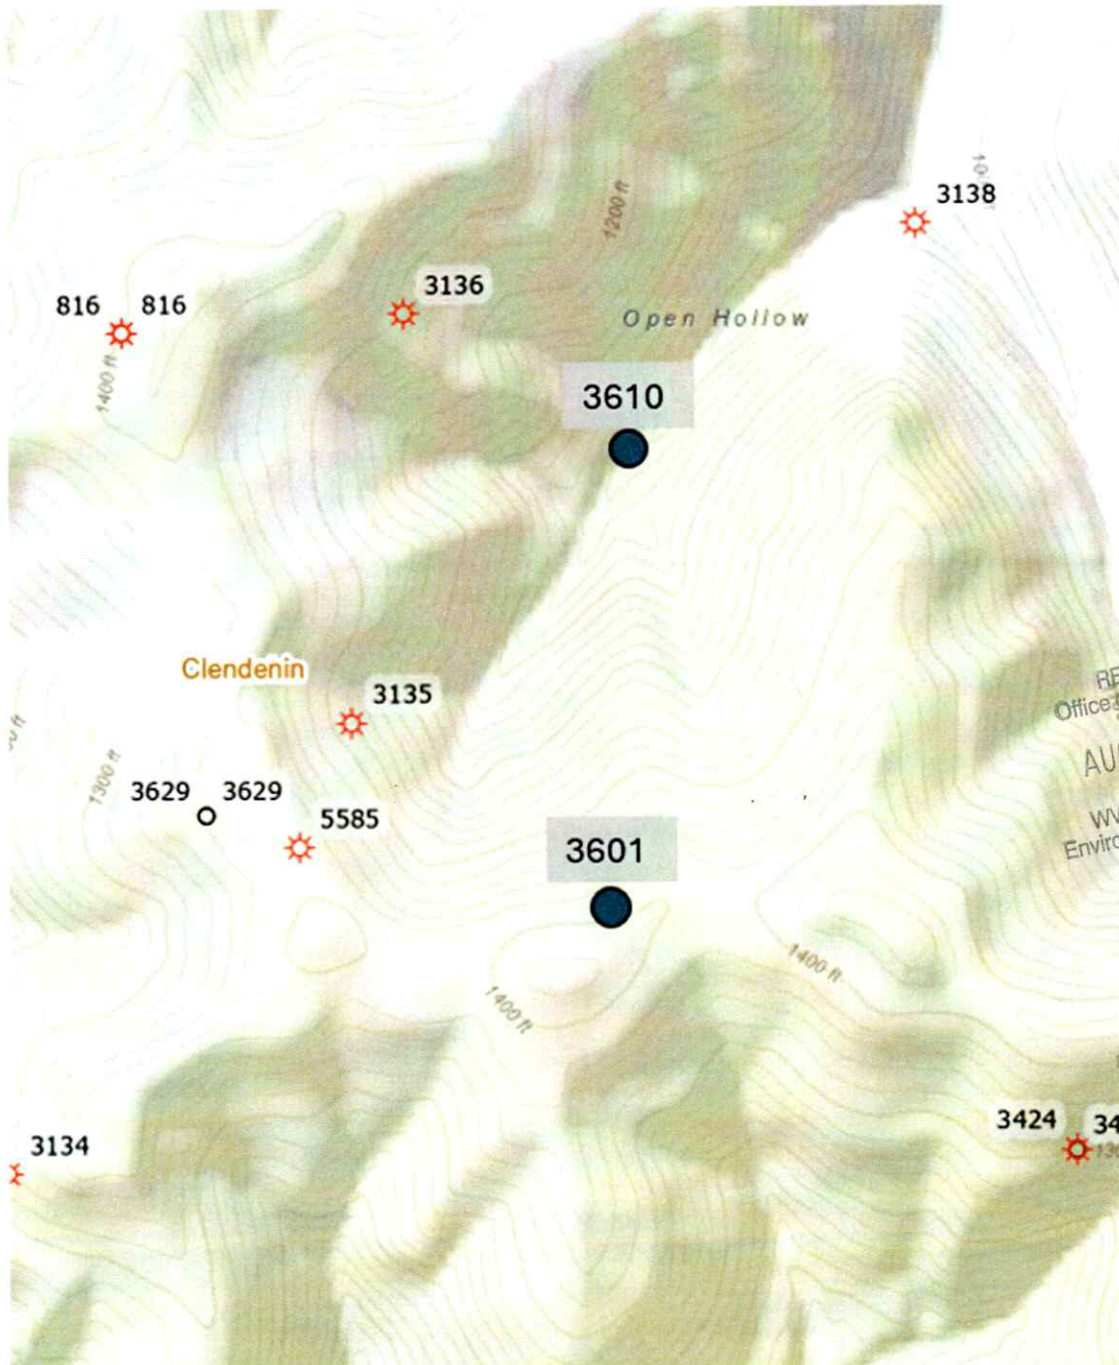

08/15/2025



West Virginia Department of Environmental Protection
Office of Oil and Gas

WELL LOCATION FORM: GPS

API: 47-039-03610 WELL NO.: #2
FARM NAME: Young
RESPONSIBLE PARTY NAME: Pillar Energy LLC
COUNTY: Kanawha DISTRICT: Elk
QUADRANGLE: Clendenin
SURFACE OWNER: Michael & Christina Myers
ROYALTY OWNER: Michael & Christina Myers
UTM GPS NORTHING: 4250668.56
UTM GPS EASTING: 473445.35 GPS ELEVATION: 1080

The Responsible Party named above has chosen to submit GPS coordinates in lieu of preparing a new well location plat for a plugging permit or assigned API number on the above well. The Office of Oil and Gas will not accept GPS coordinates that do not meet the following requirements:

1. Datum: NAD 1983, Zone: 17 North, Coordinate Units: meters, Altitude: height above mean sea level (MSL) – meters.
2. Accuracy to Datum – 3.05 meters
3. Data Collection Method:

Survey grade GPS ____: Post Processed Differential ____


Real-Time Differential ____

Mapping Grade GPS ____: Post Processed Differential ____

Real-Time Differential ____

4. Letter size copy of the topography map showing the well location.

I the undersigned, hereby certify this data is correct to the best of my knowledge and belief and shows all the information required by law and the regulations issued and prescribed by the Office of Oil and Gas.

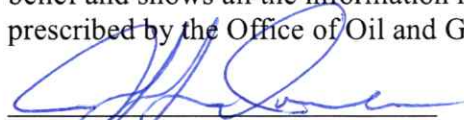
Signature

CEO

Title

7-14-25

Date

RECEIVED
Office of Oil and Gas
AUG 04 2025
WV Department of
Environmental Protection

08/15/2025