



Diversified Gas & Oil
Corporation
100 Diversified Way
Pikeville KY, 41051


47-030-03730

Well Plugging Map


Legend

- Well
- Pits
- Pad
- Access Road
- Public Roads

47-039- 03730P

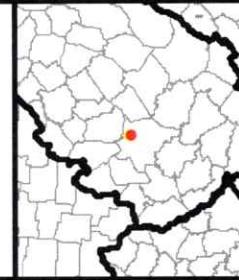

1" = 50'
25 50
N

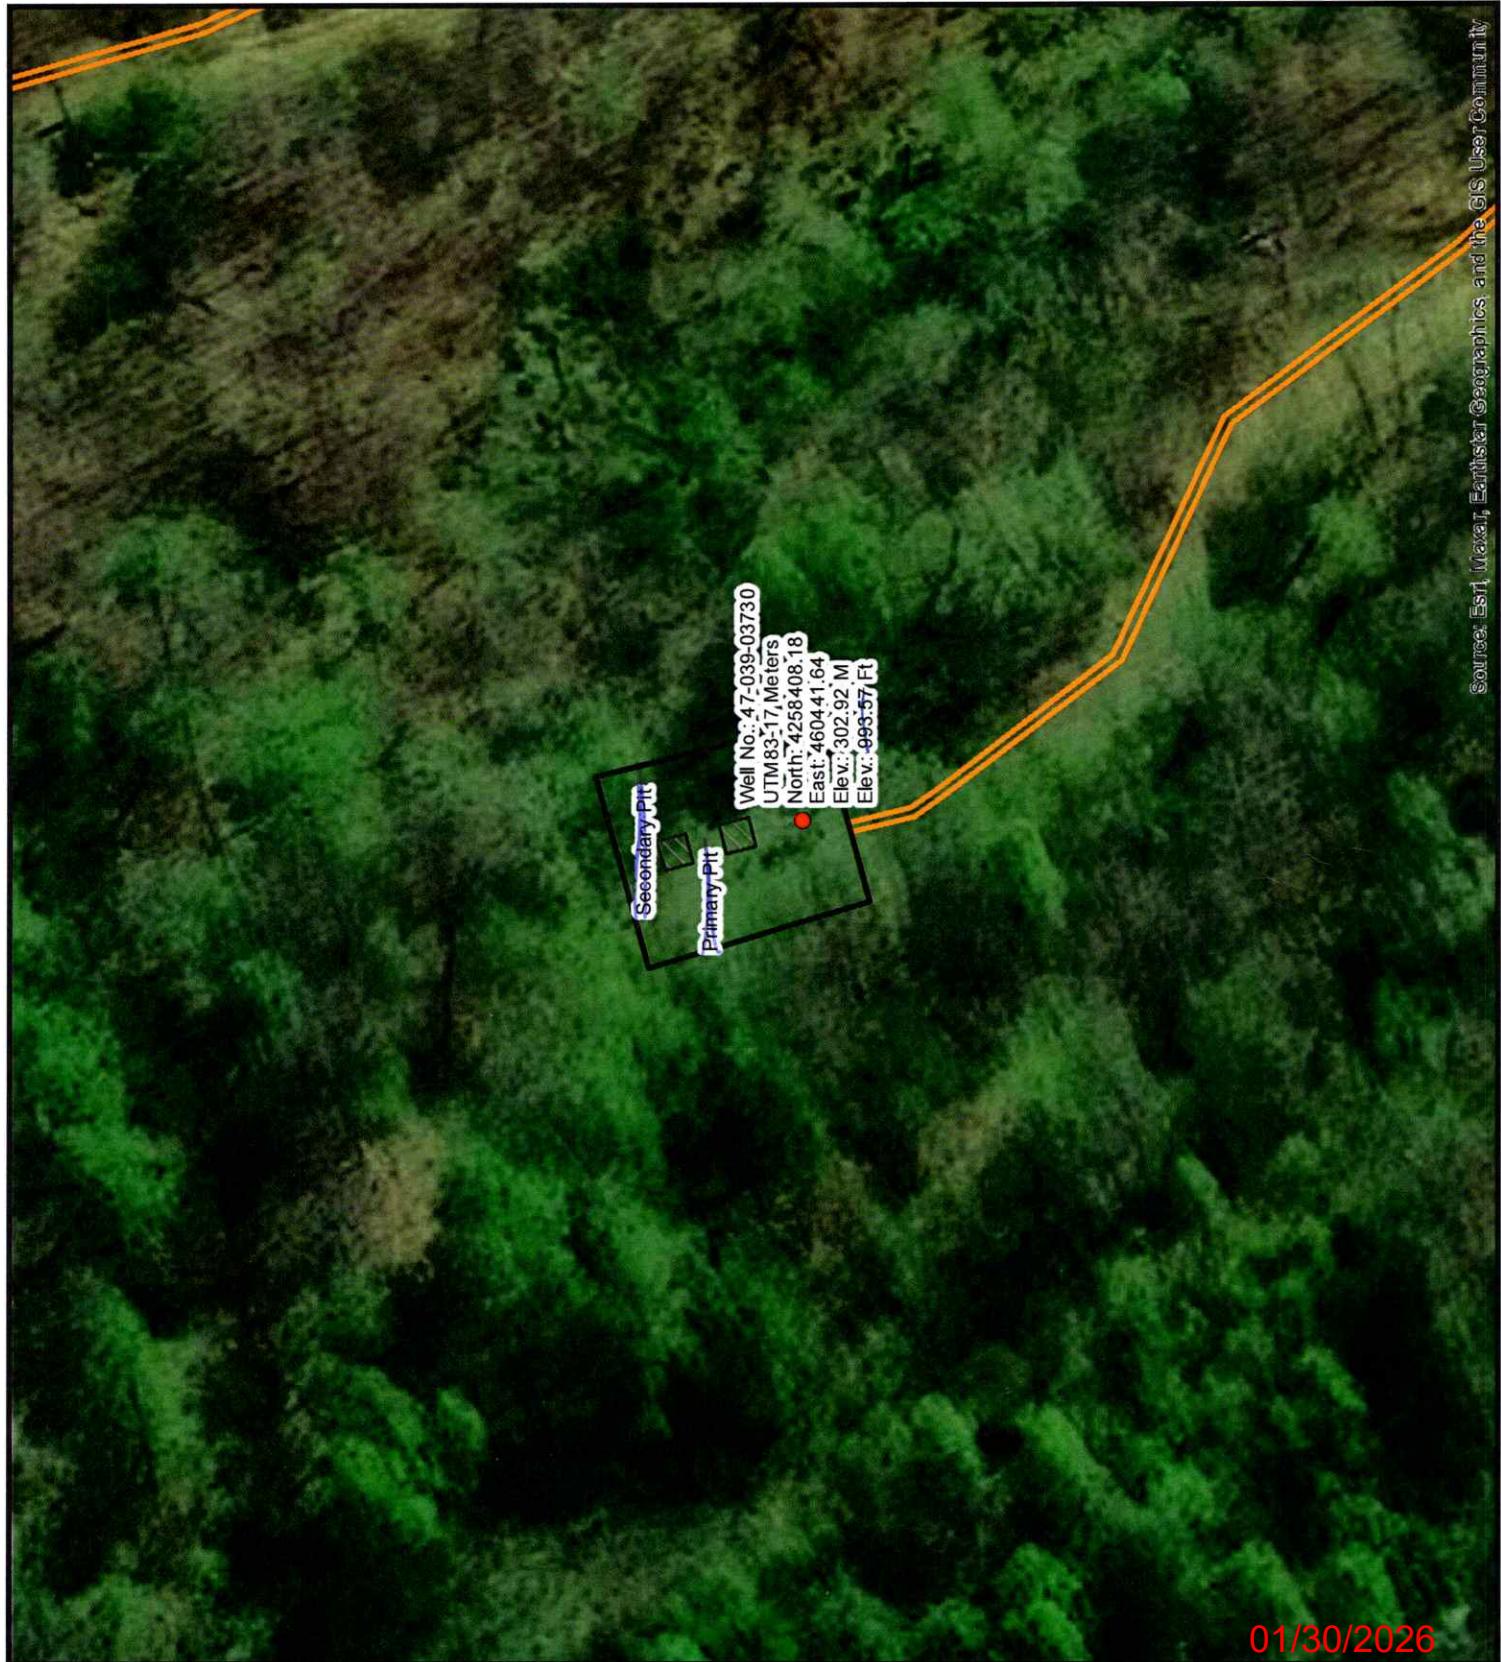



Diversified Gas & Oil
Corporation
100 Diversified Way
Pikeville KY, 41051



47-030-03730
Well Plugging Map

Legend

Well Pits Pad

— Access Road
— Public Roads

47-039-037309

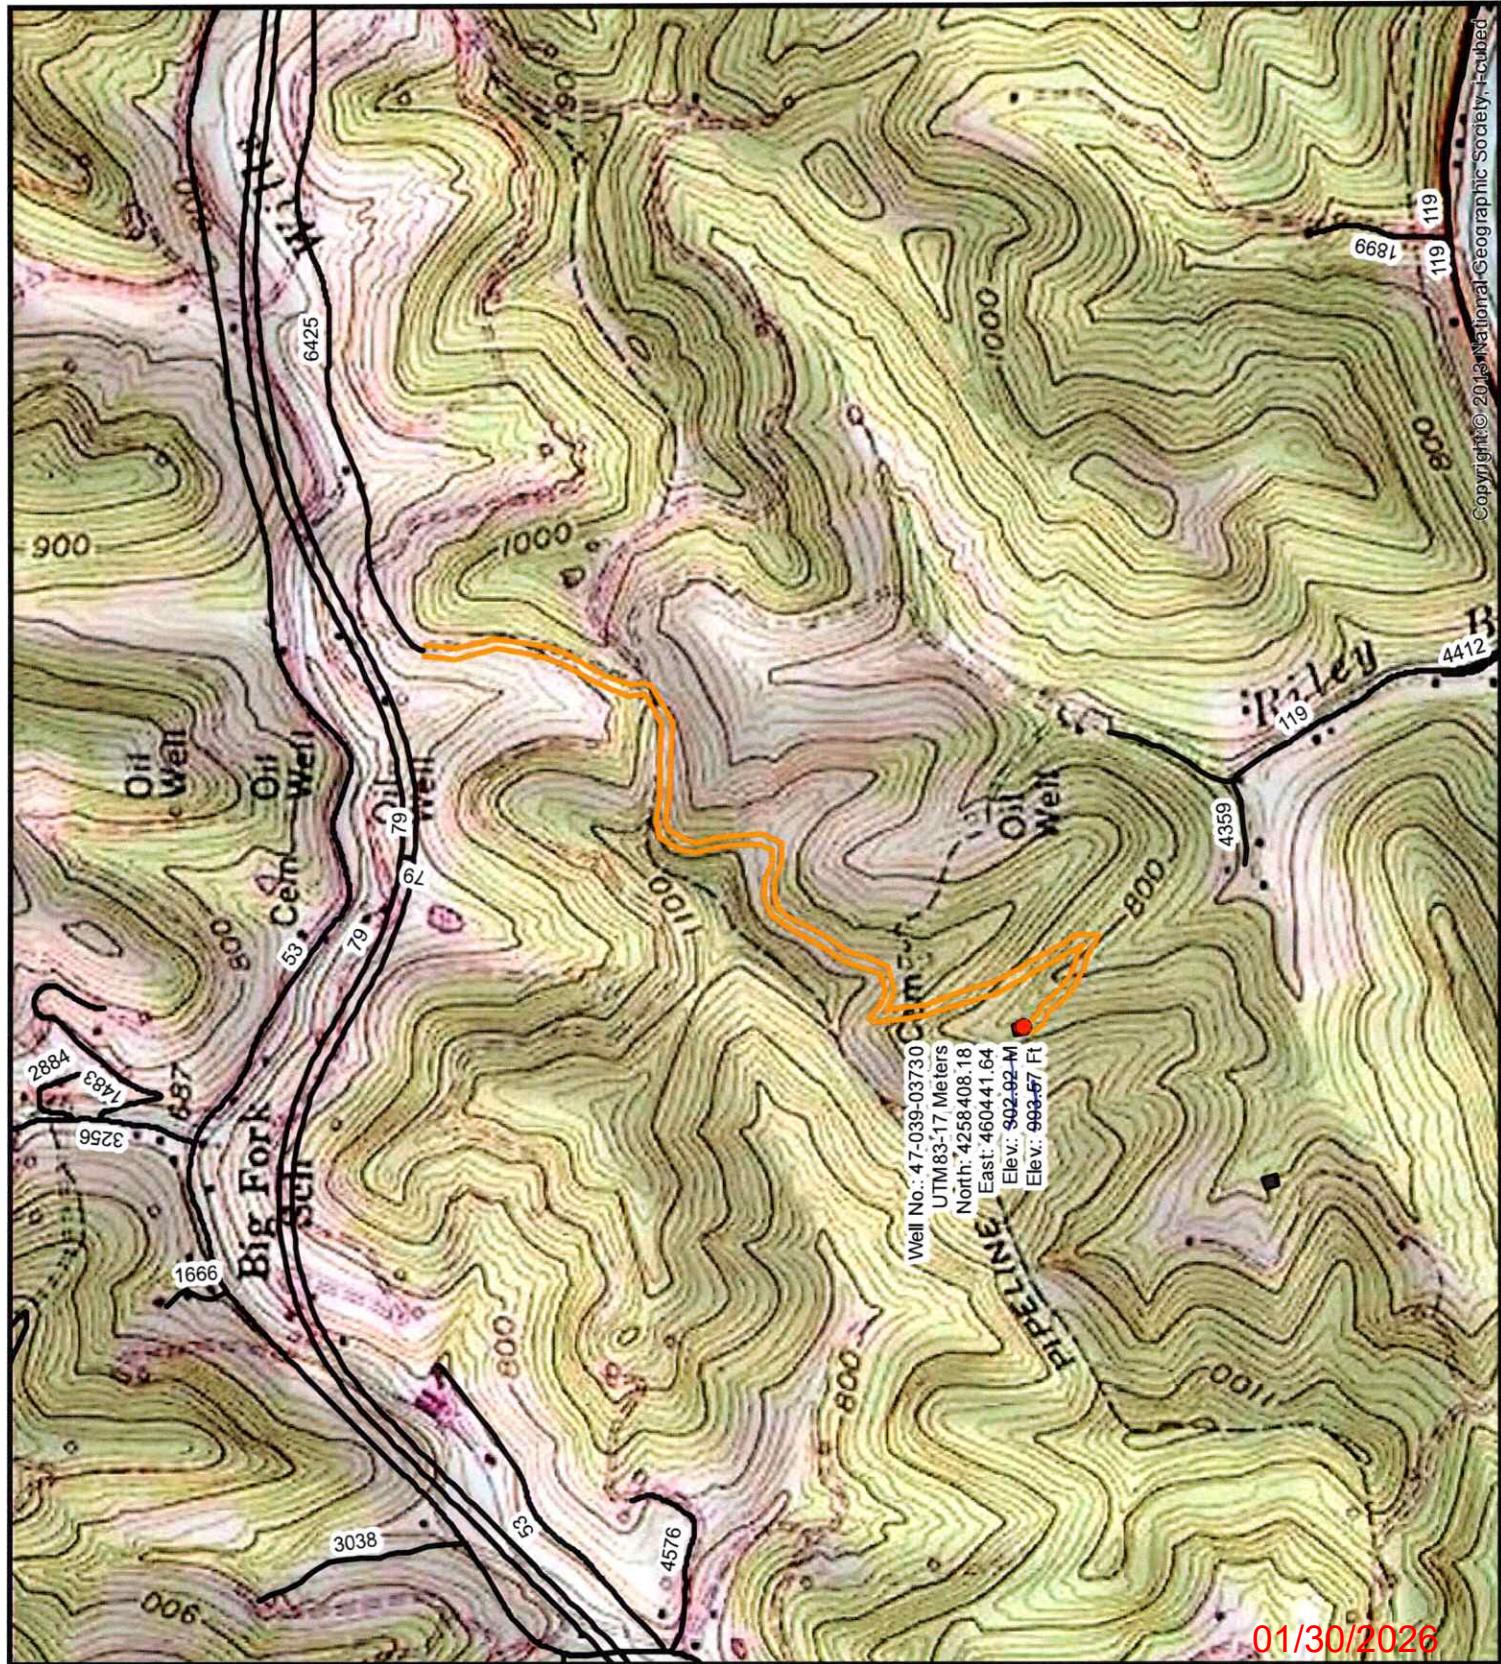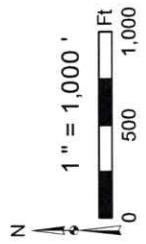

47-039-03730 P





Diversified Gas & Oil
Corporation
100 Diversified Way
Pikeville KY, 41051

47-039-02933

Well Plugging Map

Legend

- Well
- Pits
- Pad
- Access Road
- Public Roads

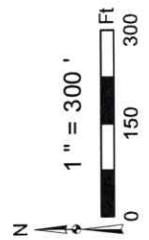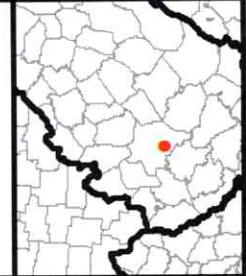

Copyright © 2013 National Geographic Society, Inc.

WW-7
8-30-06



West Virginia Department of Environmental Protection
Office of Oil and Gas
WELL LOCATION FORM: GPS

API: 4703903730

WELL NO.: SAMPSON SIMON D 1

FARM NAME: SD Sampson

RESPONSIBLE PARTY NAME: Diversified Production, LLC

COUNTY: Kanawha DISTRICT: Elk

QUADRANGLE: Blue Creek 7.5'

SURFACE OWNER: Stricklen Realty, Inc.

ROYALTY OWNER: Jerry Null

UTM GPS NORTHING: 4258408.18

829.4'

UTM GPS EASTING: 460441.64 GPS ELEVATION: 993.57'

The Responsible Party named above has chosen to submit GPS coordinates in lieu of preparing a new well location plat for a plugging permit or assigned API number on the above well. The Office of Oil and Gas will not accept GPS coordinates that do not meet the following requirements:

1. Datum: NAD 1983, Zone: 17 North, Coordinate Units: meters, Altitude: height above mean sea level (MSL) – meters.

2. Accuracy to Datum – 3.05 meters

3. Data Collection Method:

Survey grade GPS : Post Processed Differential


Real-Time Differential

Mapping Grade GPS X : Post Processed Differential X


Real-Time Differential

4. Letter size copy of the topography map showing the well location.

I the undersigned, hereby certify this data is correct to the best of my knowledge and belief and shows all the information required by law and the regulations issued and prescribed by the Office of Oil and Gas.

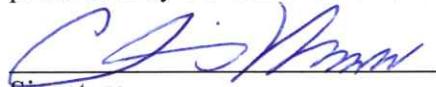
Signature

Chris Veazey - Director of Administration
Title

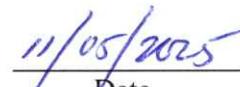
Date

RECEIVED
Office of Oil and Gas
NOV 13 2025
WV Department of
Environmental Protection

1000' 1000' 1000' 1000'

LATITUDE (25') 38°30'00"
(5') 38°30'

LONGITUDE (25') 0°25'00"
(5') 0°25'00"

1000' 1000' 1000' 1000'

NORTH

MAGNETIC 79-61.

Louise Holt, et al

ANNA CASTO
Jorrell H. Stricklen (Surf)
DB 1028-328

HENRY ANDERSON
Louise Holt, et al (Surf)
DB 609-43

SIMON D. SAMPSON, ET AL
Jorrell H. Stricklen (Surf)
DB 1028-328

LOC. No. 1

OLIVER CULPEPPER
H.H. Head (Surf)
DB 91-31

SQUIRE A. HILL
Jorrell H. Stricklen (Surf)
DB 1400-678

Note:
Description of lease taken from a
recent survey by C.T. Tolson, Jr.
dated 5-29-76. Map No. 29

TAX MAP 19
PARCELS No.s 3 & 30

FILE NO. WAI-2 WQ No. 365
DRAWING NO. D-243
SCALE 1" = 500'
MINIMUM DEGREE OF
ACCURACY 1/1,000'
PROVEN SOURCE OF
ELEVATION B.M. Mouth of Blue Creek
Elev. 616.354

THE UNDERSIGNED, HEREBY CERTIFY
THAT THIS PLAT IS CORRECT TO THE
BEST OF MY KNOWLEDGE AND BELIEF AND
SHOWS ALL THE INFORMATION REQUIRED
BY LAW AND THE REGULATIONS ISSUED
AND PRESCRIBED BY THE DEPARTMENT OF
MINES.
(SIGNED) *J. G. Sturgill*
R.P.E. L.L.S. 412

L. G. STURGILL
REGISTERED
412
STATE OF
WEST VIRGINIA
LAND SURVEYOR
PLAT SURVEYOR

(+) DENOTES LOCATION OF
WELL ON UNITED STATES
TOPOGRAPHIC MAPS

FORM IV-6
(8-78)

DATE MARCH 13, 1981
OPERATOR'S WELL NO. 1
API WELL NO. 47-039-3730
STATE COUNTY PERMIT

Department of Mines
Oil & Gas Division

WELL TYPE: OIL GAS LIQUID INJECTION WASTE DISPOSAL
(IF "GAS", PRODUCTION STORAGE DEEP SHALLOW
LOCATION: ELEVATION 629.4 WATER SHED ELEY BRANCH OF ELK RIVER
DISTRICT ELEY COUNTY KANAWHA
QUADRANGLE 25' BLUE CREEK / 15' CLENDENIN (N.W.)
SURFACE OWNER JORRELL H. STRICKLEN ACREAGE 64.5
OIL & GAS ROYALTY OWNER SIMON D. SAMPSON, ET AL LEASE ACREAGE 64.5
LEASE NO. W-1017

PROPOSED WORK: DRILL CONVERT DRILL DEEPER REDRILL FRACTURE OR
STIMULATE PLUG OFF OLD FORMATION PERFORATE NEW FORMATION
OTHER PHYSICAL CHANGE IN WELL (SPECIFY)

PLUG AND ABANDON CLEAN OUT AND REPLUG
TARGET FORMATION BIG INJUN ESTIMATED DEPTH 1971

WELL OPERATOR GLAVER STATE OIL REEF. DESIGNATED AGENT CARL J. CARLSON
ADDRESS P.O. BOX 1527 ADDRESS P.O. BOX 1527
PARKERSBURG, WV 26101 PARKERSBURG, WV 26101

RECEIVED
Office of Oil and Gas
NOV 13 2025
WV Department of
Environmental Protection

01/30/2026