

WW-7
8-30-06



West Virginia Department of Environmental Protection
Office of Oil and Gas
WELL LOCATION FORM: GPS

API: 47-039-03972 WELL NO.: WV 210011 (Marmet BR #117)

FARM NAME: Marmet

RESPONSIBLE PARTY NAME: EQT Production Company

COUNTY: Kanawha DISTRICT: Loudon

QUADRANGLE: Belle 7.5'

SURFACE OWNER: Orlandi, Inc.

ROYALTY OWNER: EQT Production Company

UTM GPS NORTHING: 4231306

UTM GPS EASTING: 451154 GPS ELEVATION: 275 m (903 ft)

The Responsible Party named above has chosen to submit GPS coordinates in lieu of preparing a new well location plat for a plugging permit or assigned API number on the above well. The Office of Oil and Gas will not accept GPS coordinates that do not meet the following requirements:

- Datum: NAD 1983, Zone: 17 North, Coordinate Units: meters, Altitude: height above mean sea level (MSL) – meters.
- Accuracy to Datum – 3.05 meters
- Data Collection Method:
Survey grade GPS : Post Processed Differential
Real-Time Differential
Mapping Grade GPS X: Post Processed Differential X
Real-Time Differential

4. Letter size copy of the topography map showing the well location.

I the undersigned, hereby certify this data is correct to the best of my knowledge and belief and shows all the information required by law and the regulations issued and prescribed by the Office of Oil and Gas.

[Signature]
Signature
7/26/13
Date

Professional Surveyor # 21800
Title **Received**

AUG 19 2013

3903972P

Topo Quad: Belle 7.5'

Scale: 1" = 2000'

County: Kanawha


Date: June 17, 2013

District: Loudon

Project No: 52-14-00-07

Marmet BR #117 47-039-03972 WV 210011

Topo

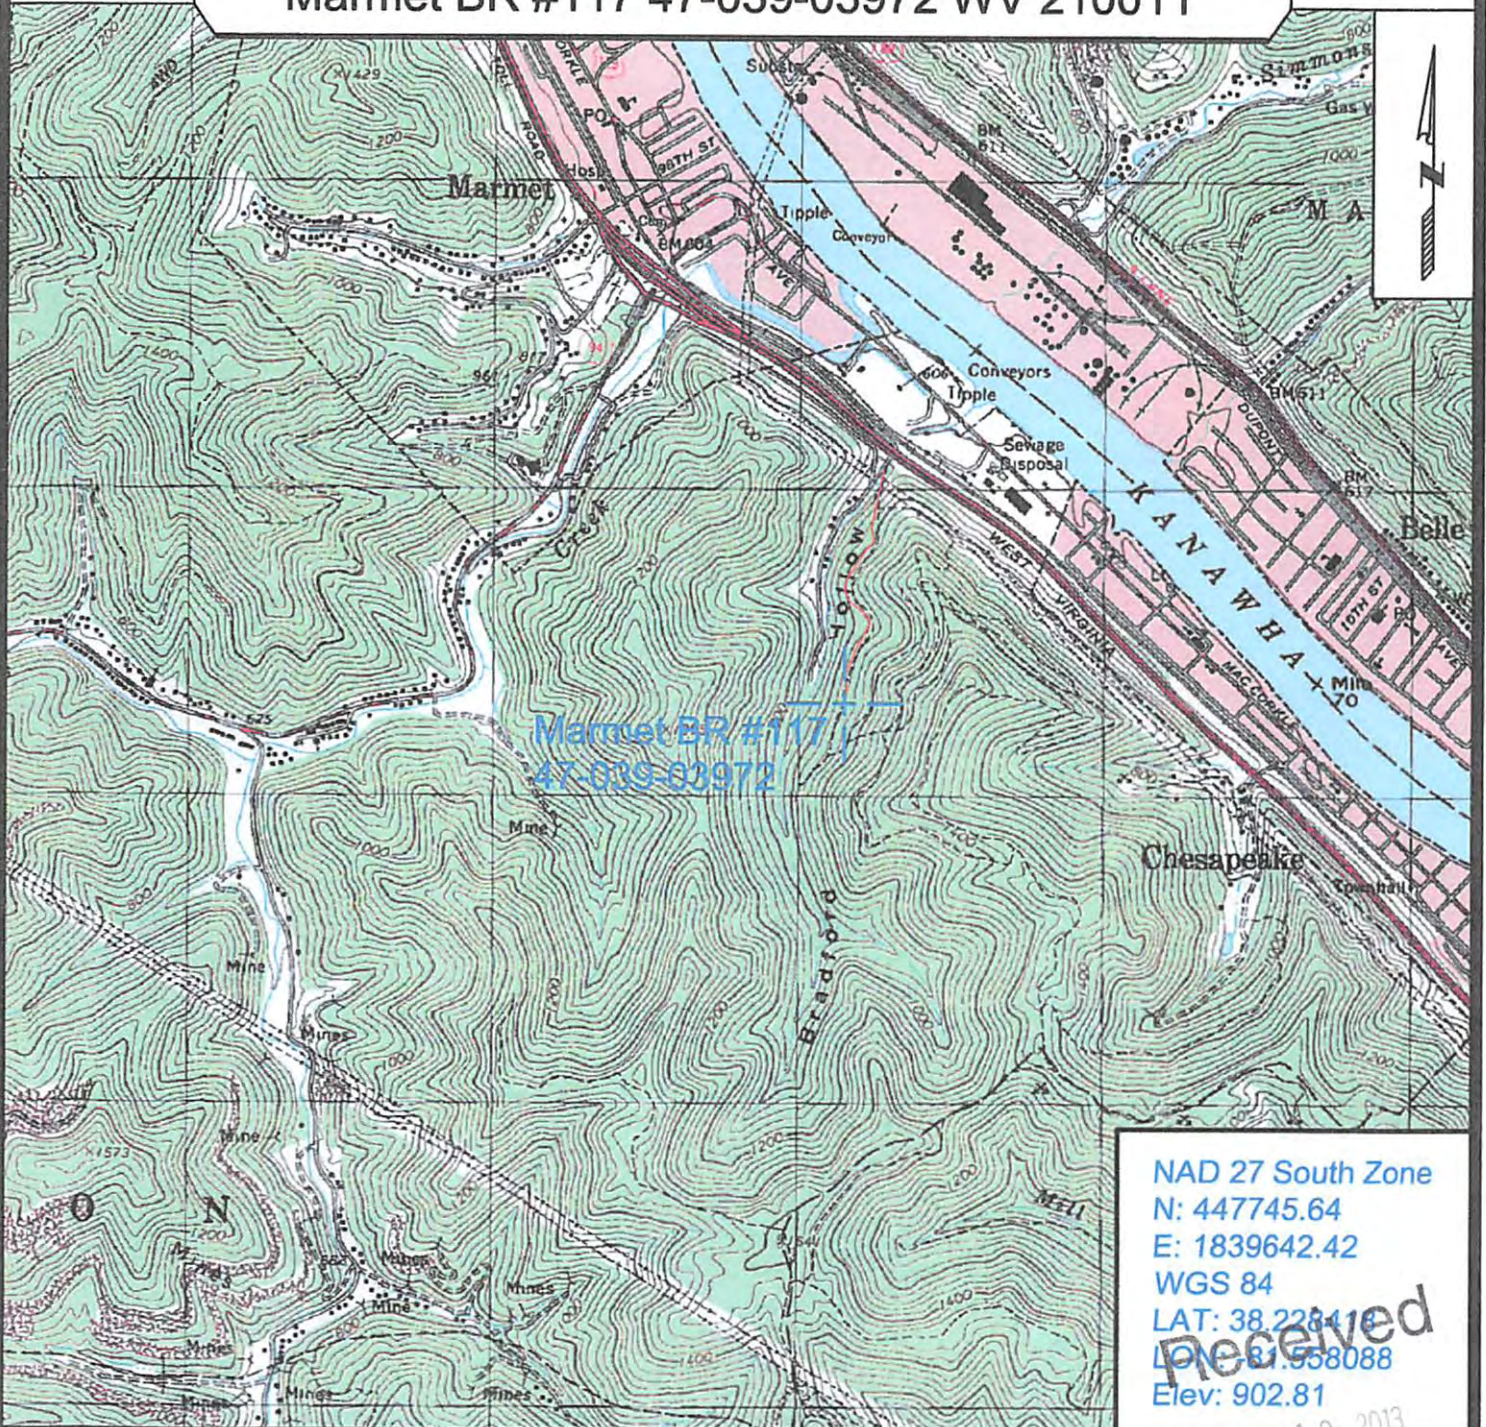

NAD 27 South Zone
 N: 447745.64
 E: 1839642.42
 WGS 84
 LAT: 38.228416
 LONG: -81.958088
 Elev: 902.81

received

AUG 19 2013



SURVEYING AND MAPPING SERVICES PERFORMED BY:
ALLEGHENY SURVEYS, INC.
 1-800-482-8606
 P.O. BOX 438
 BIRCH RIVER, WV 26610
 PH: (304) 649-8606
 FAX: (304) 649-8608

PREPARED FOR:

EQT Production Company
 P.O. Box 280
 Bridgeport, WV 26330

Office of Environmental Protection
 West Virginia Dept. of Environmental Protection